12002

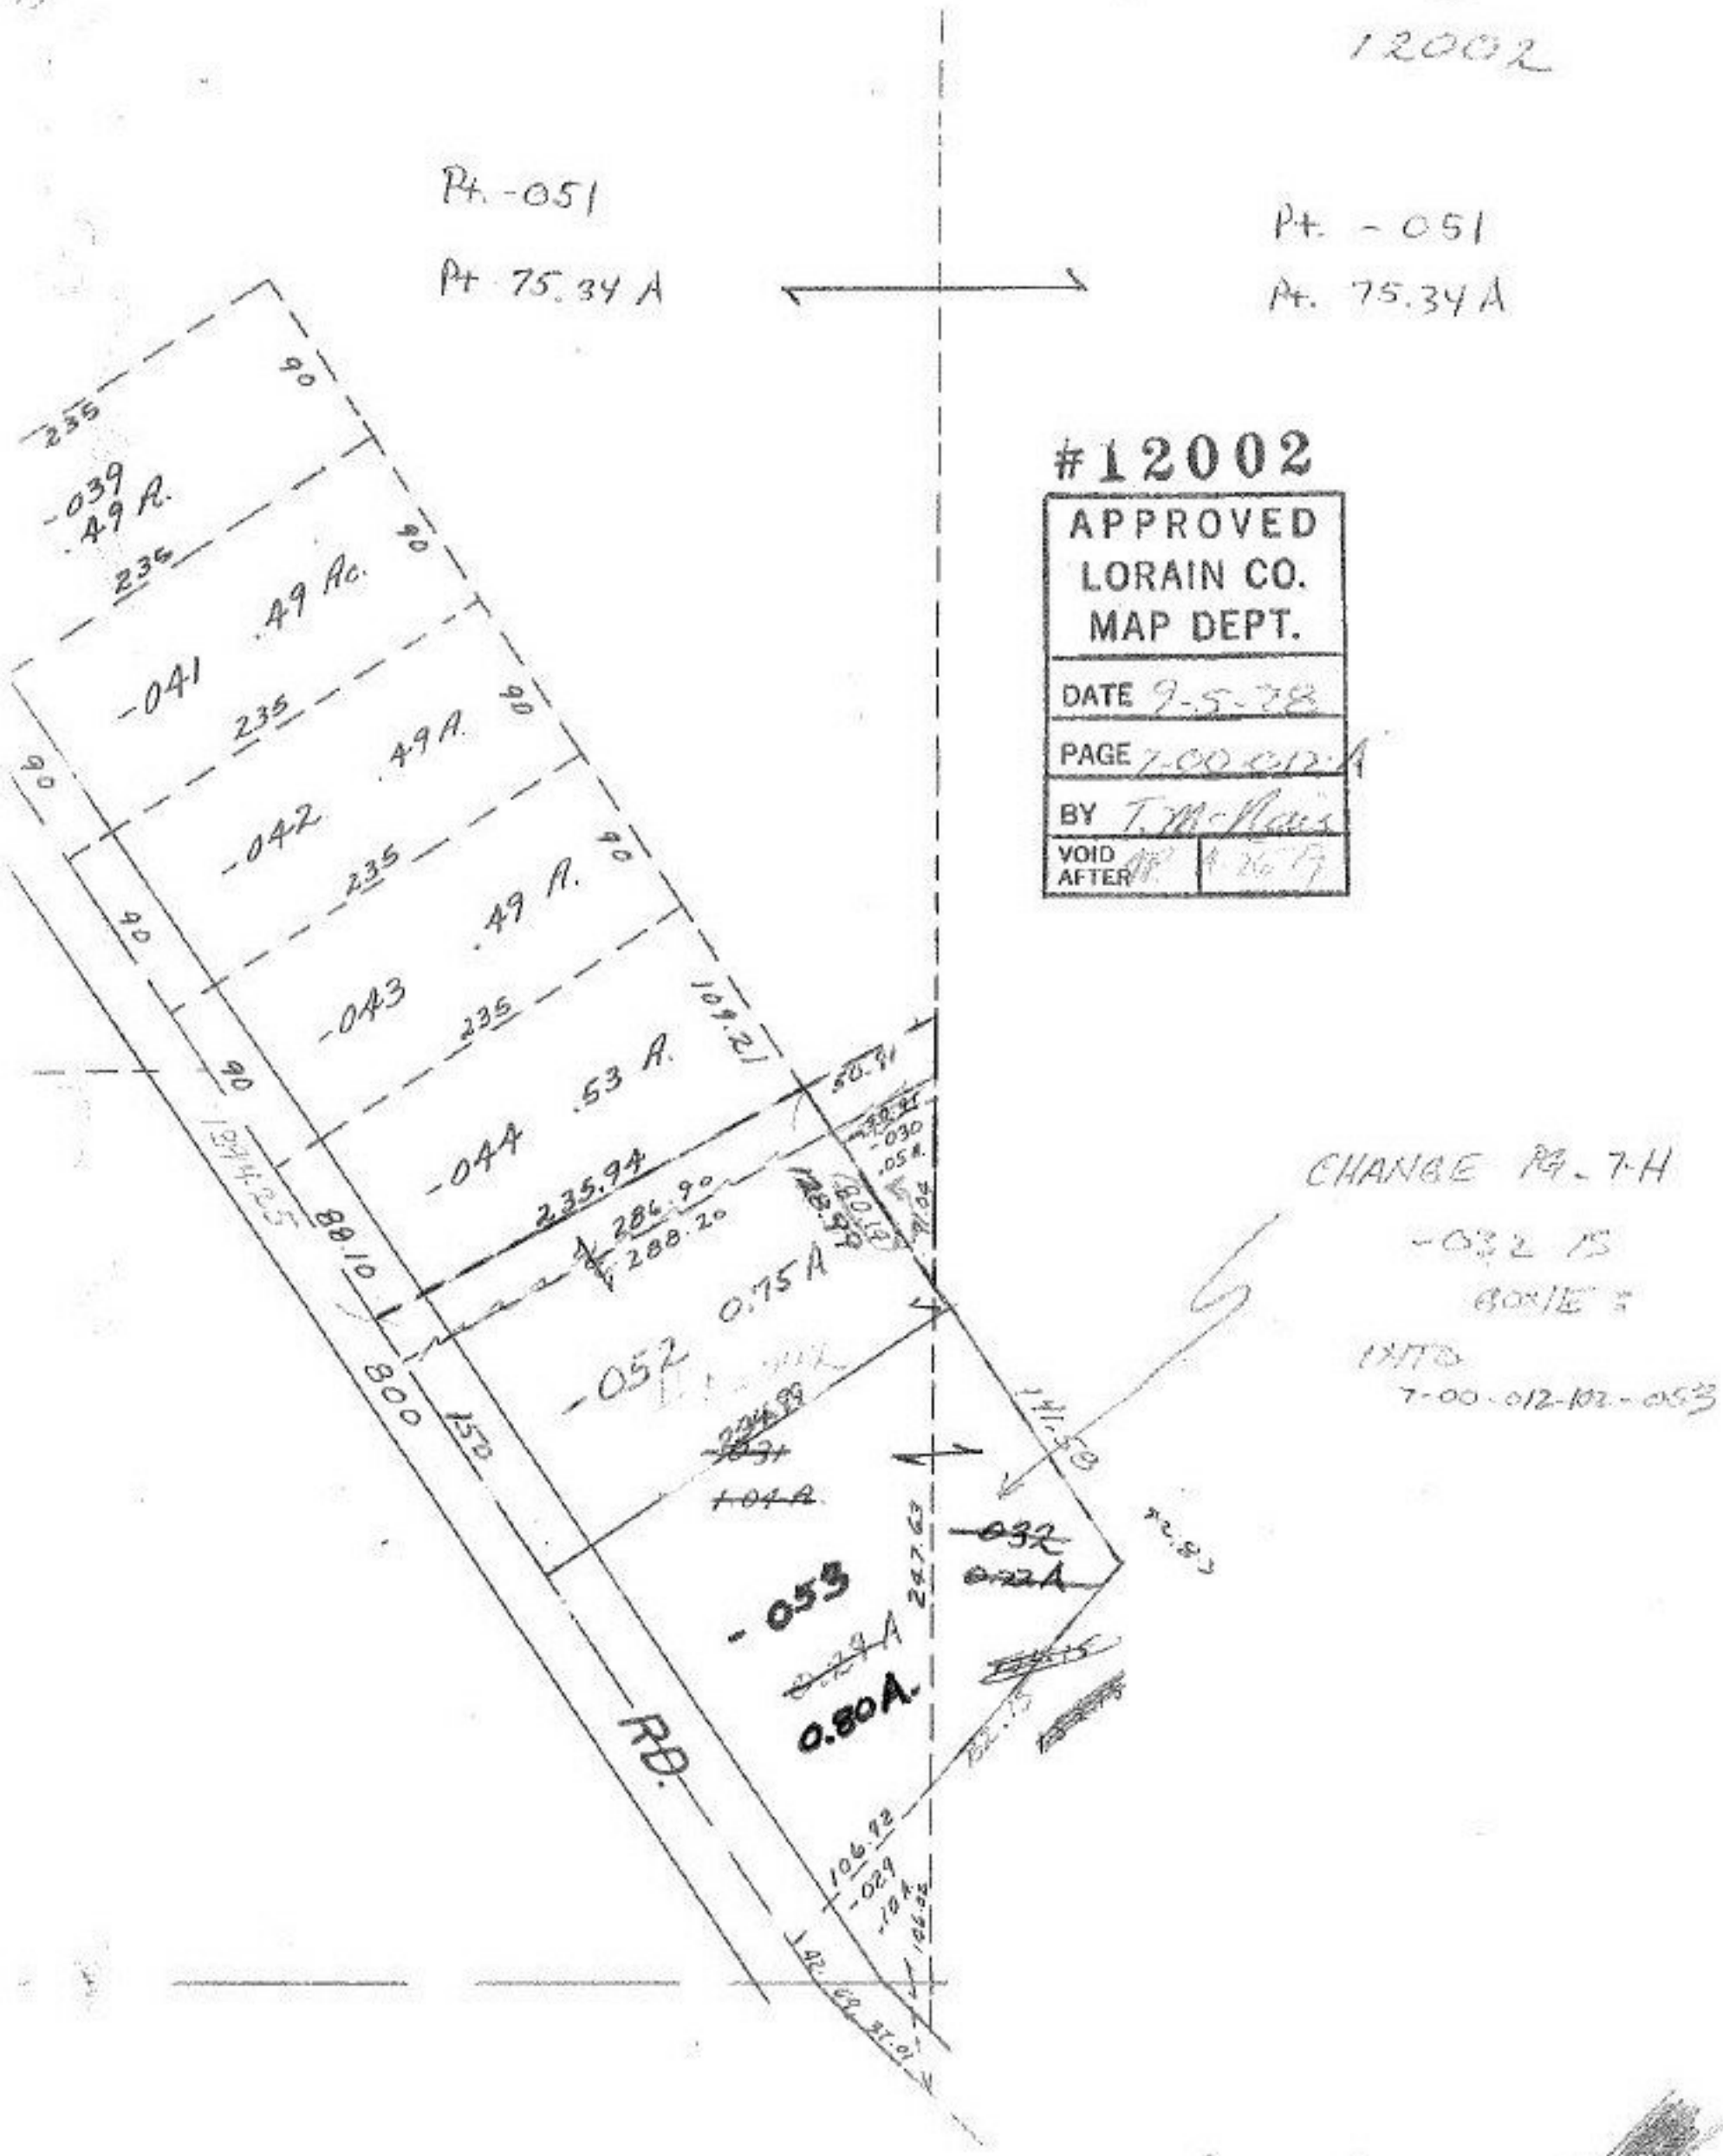

#12002

APPROVED
LORAIN CO.
MAP DEPT.

DATE 9-5-78

PAGE 7-00-012-A

BY T. McNair

VOID AFTER