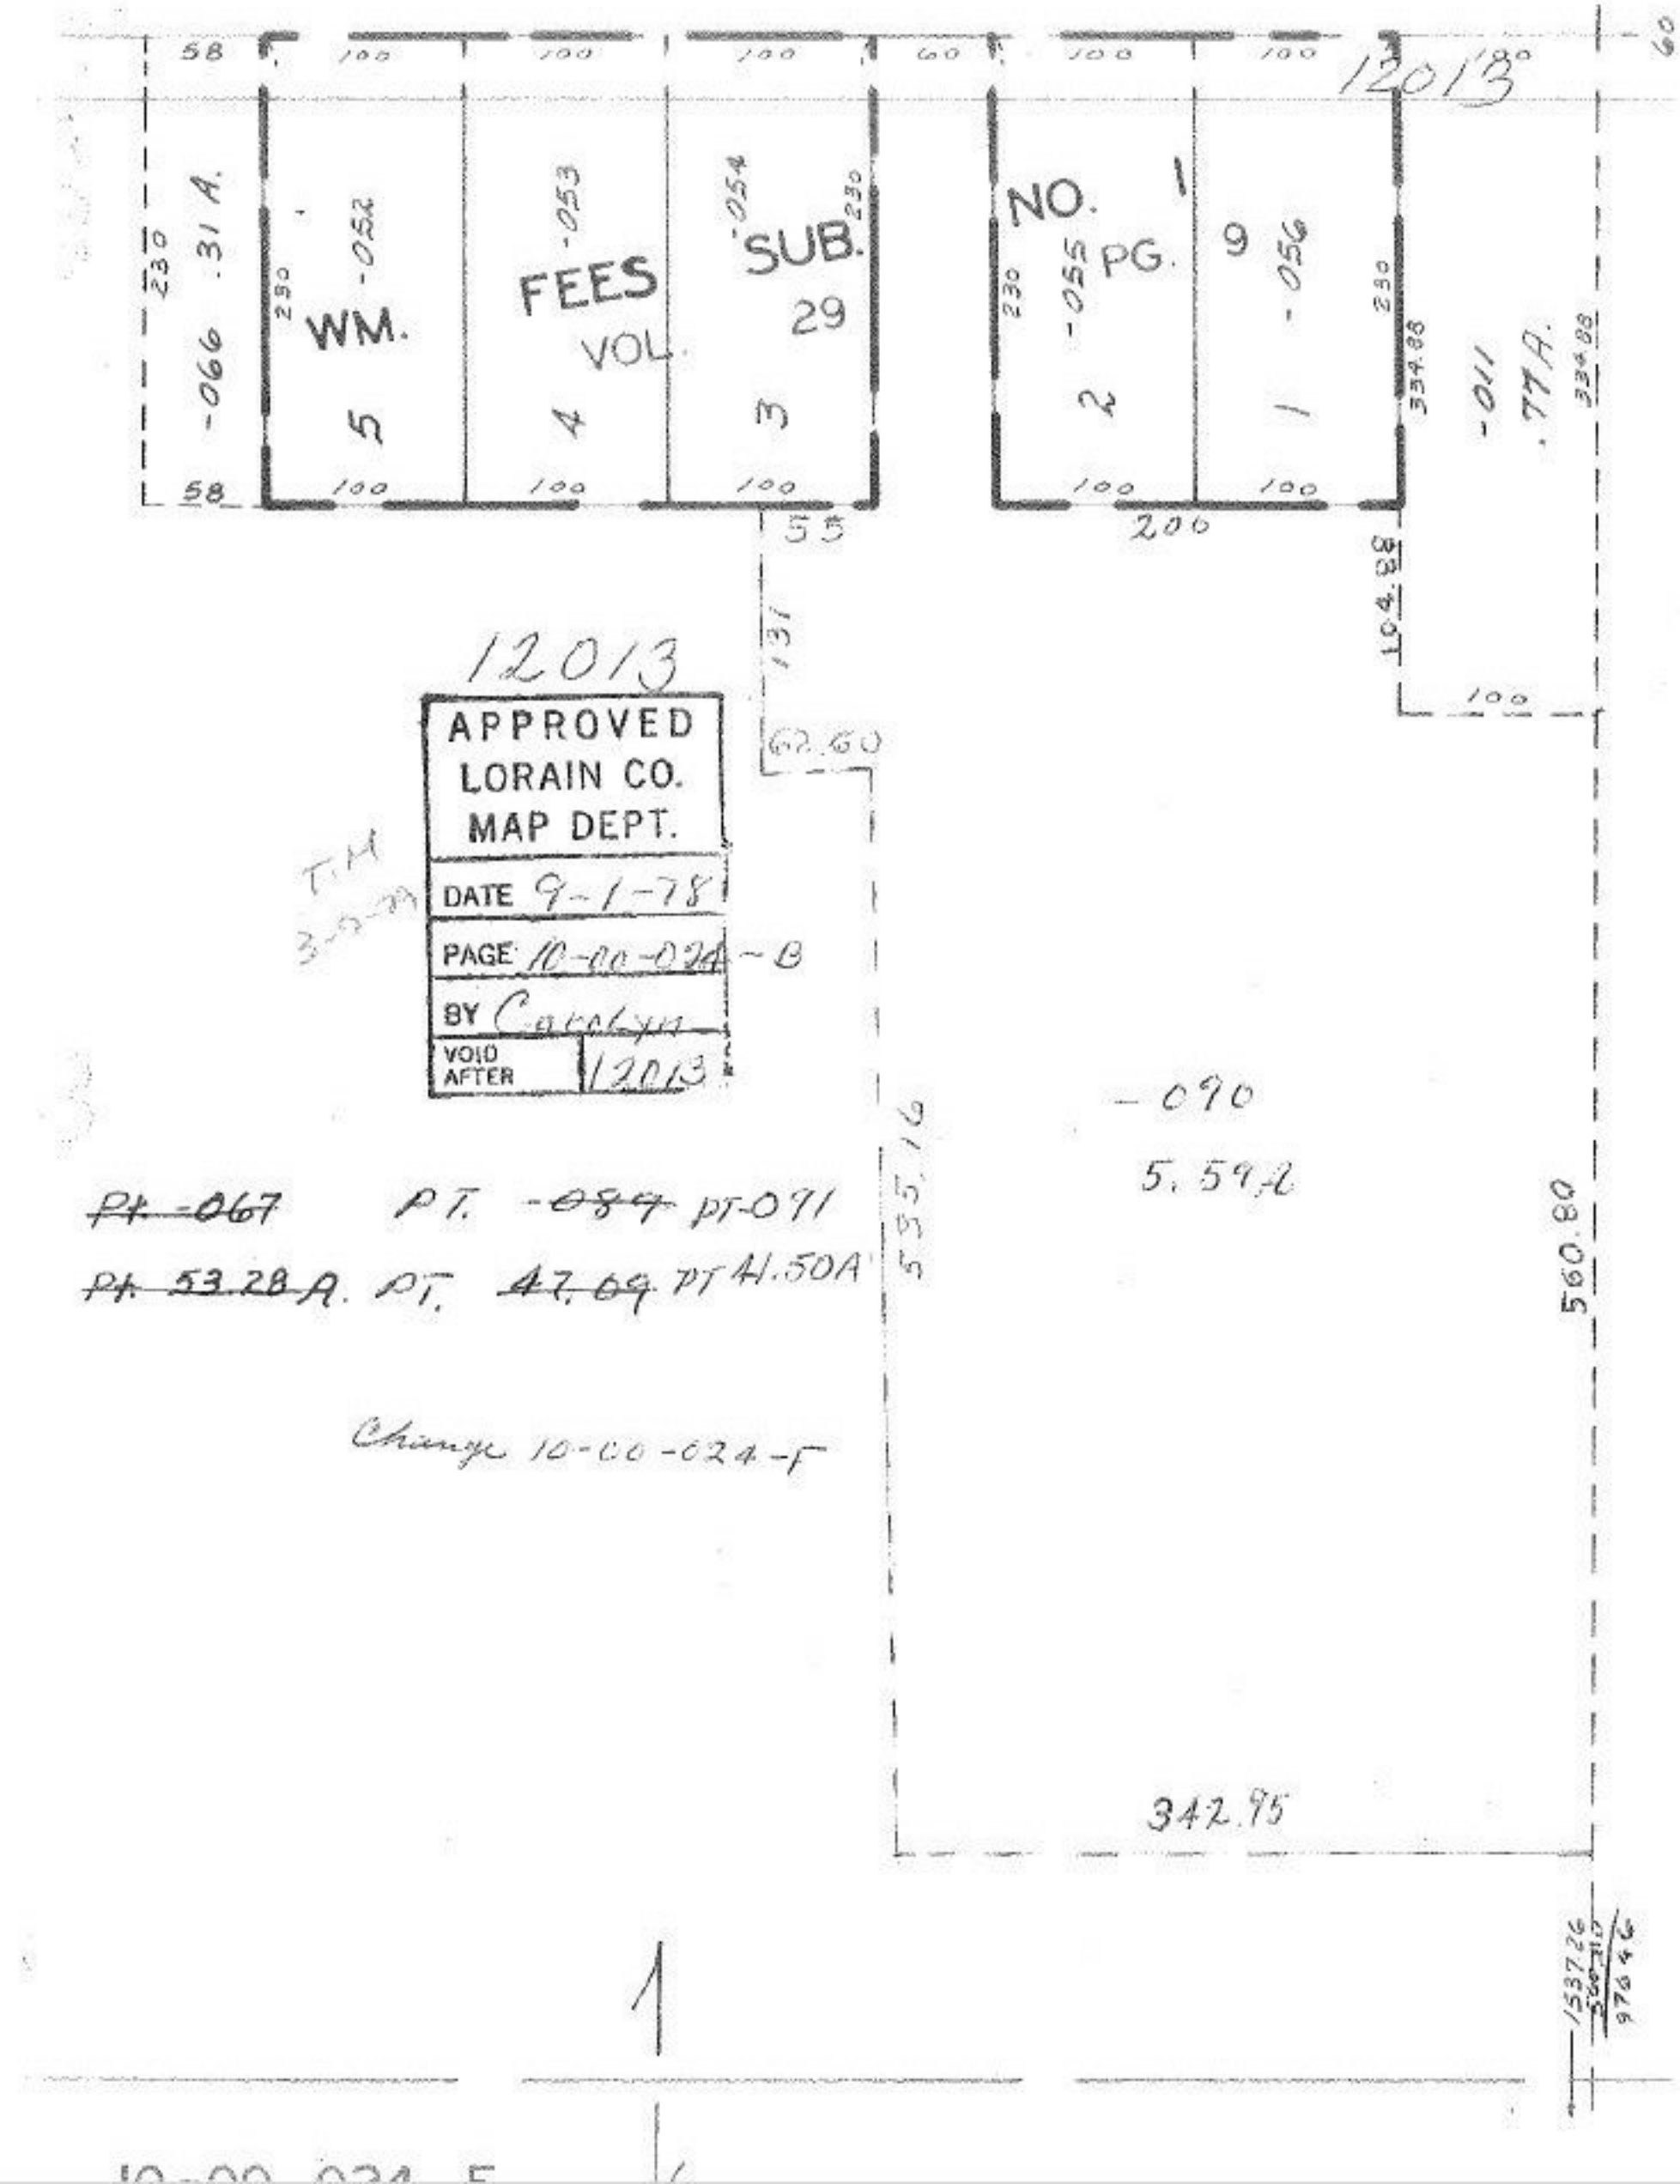
12013
58
100
100
100
60
100
100
100
60
230
-066 .31 A.
230
WM.
5
-052
FEES
VOL.
4
-053
SUB.
29
3
-054
230
NO. 1
PG. 9
2
-055
1
-056
230
334.88
-011
.77A.
334.88
58
100
100
100
100
100
55
200
104.88
131
100
62.60
12013
APPROVED
LORAIN CO.
MAP DEPT.
DATE 9-1-78
PAGE 10-00-024-B
BY Carolyn
VOID AFTER 12013
T.M
3-5-79
-090
5.59A
535.16
560.80
342.95
1537.26
560.80
976.46
Pt -067 PT. -089 PT-091
Pt 53.28 A. PT. 47.09 PT 41.50A
Change 10-00-024-F
10-00-024-F