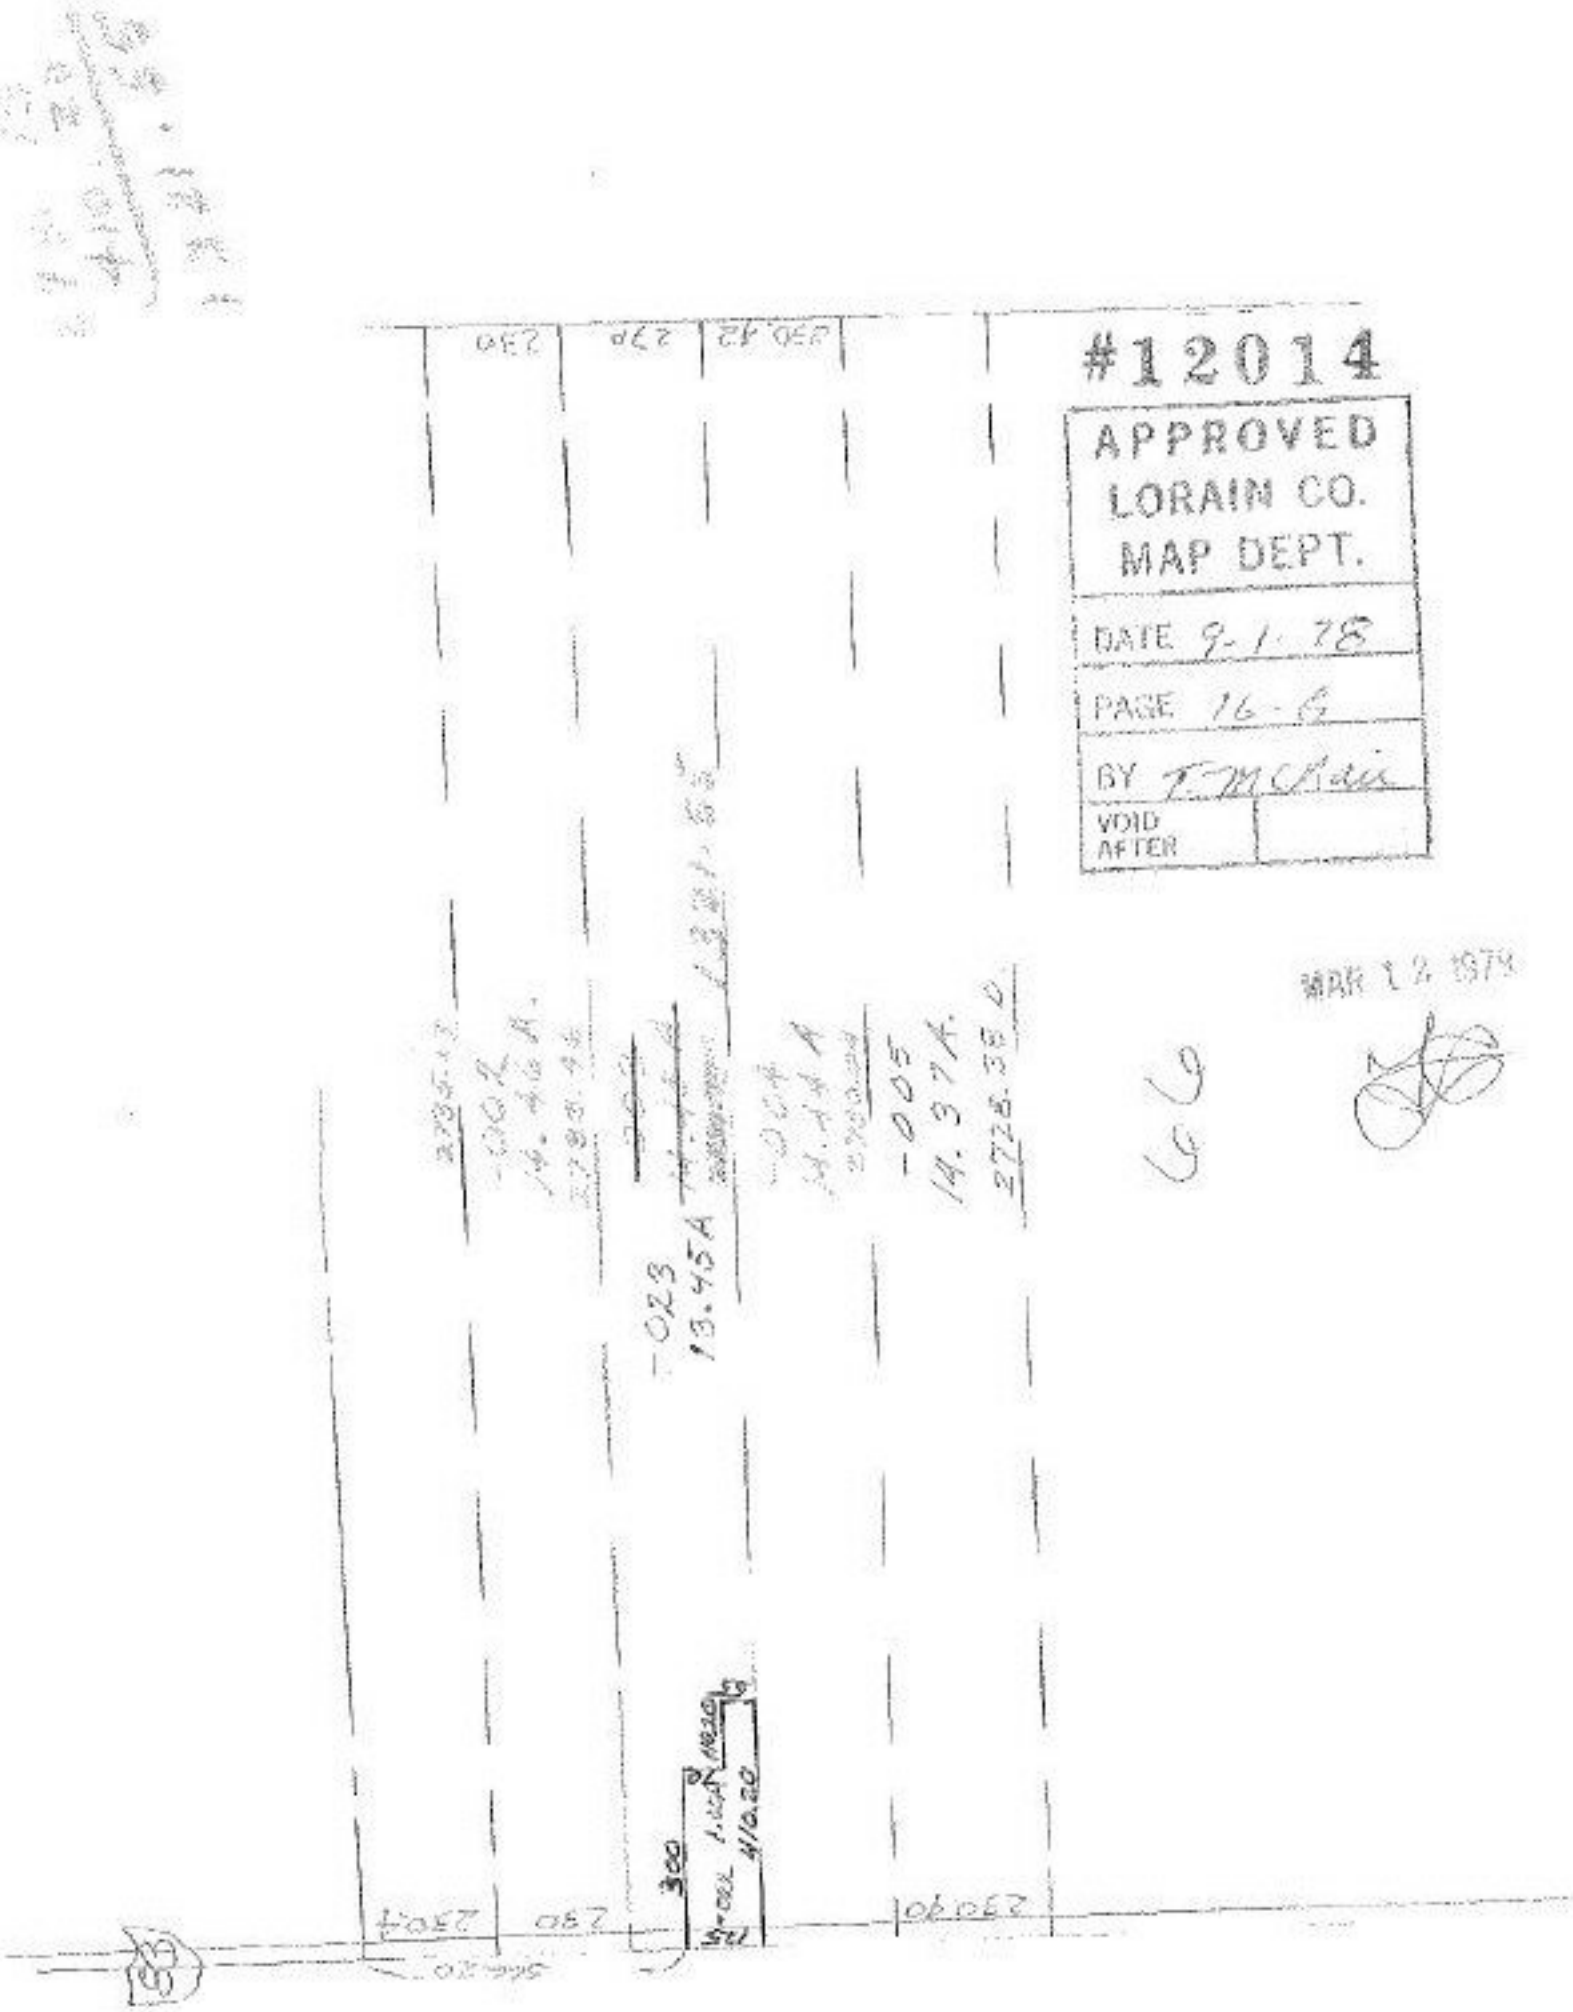

#12014
APPROVED
LORAIN CO.
MAP DEPT.
DATE 9-1-78
PAGE 16-6
BY T. McKain
VOID AFTER
MAR 12 1979
-023
13.45A
-005
14.37A.
2728.38 D
300
410.20