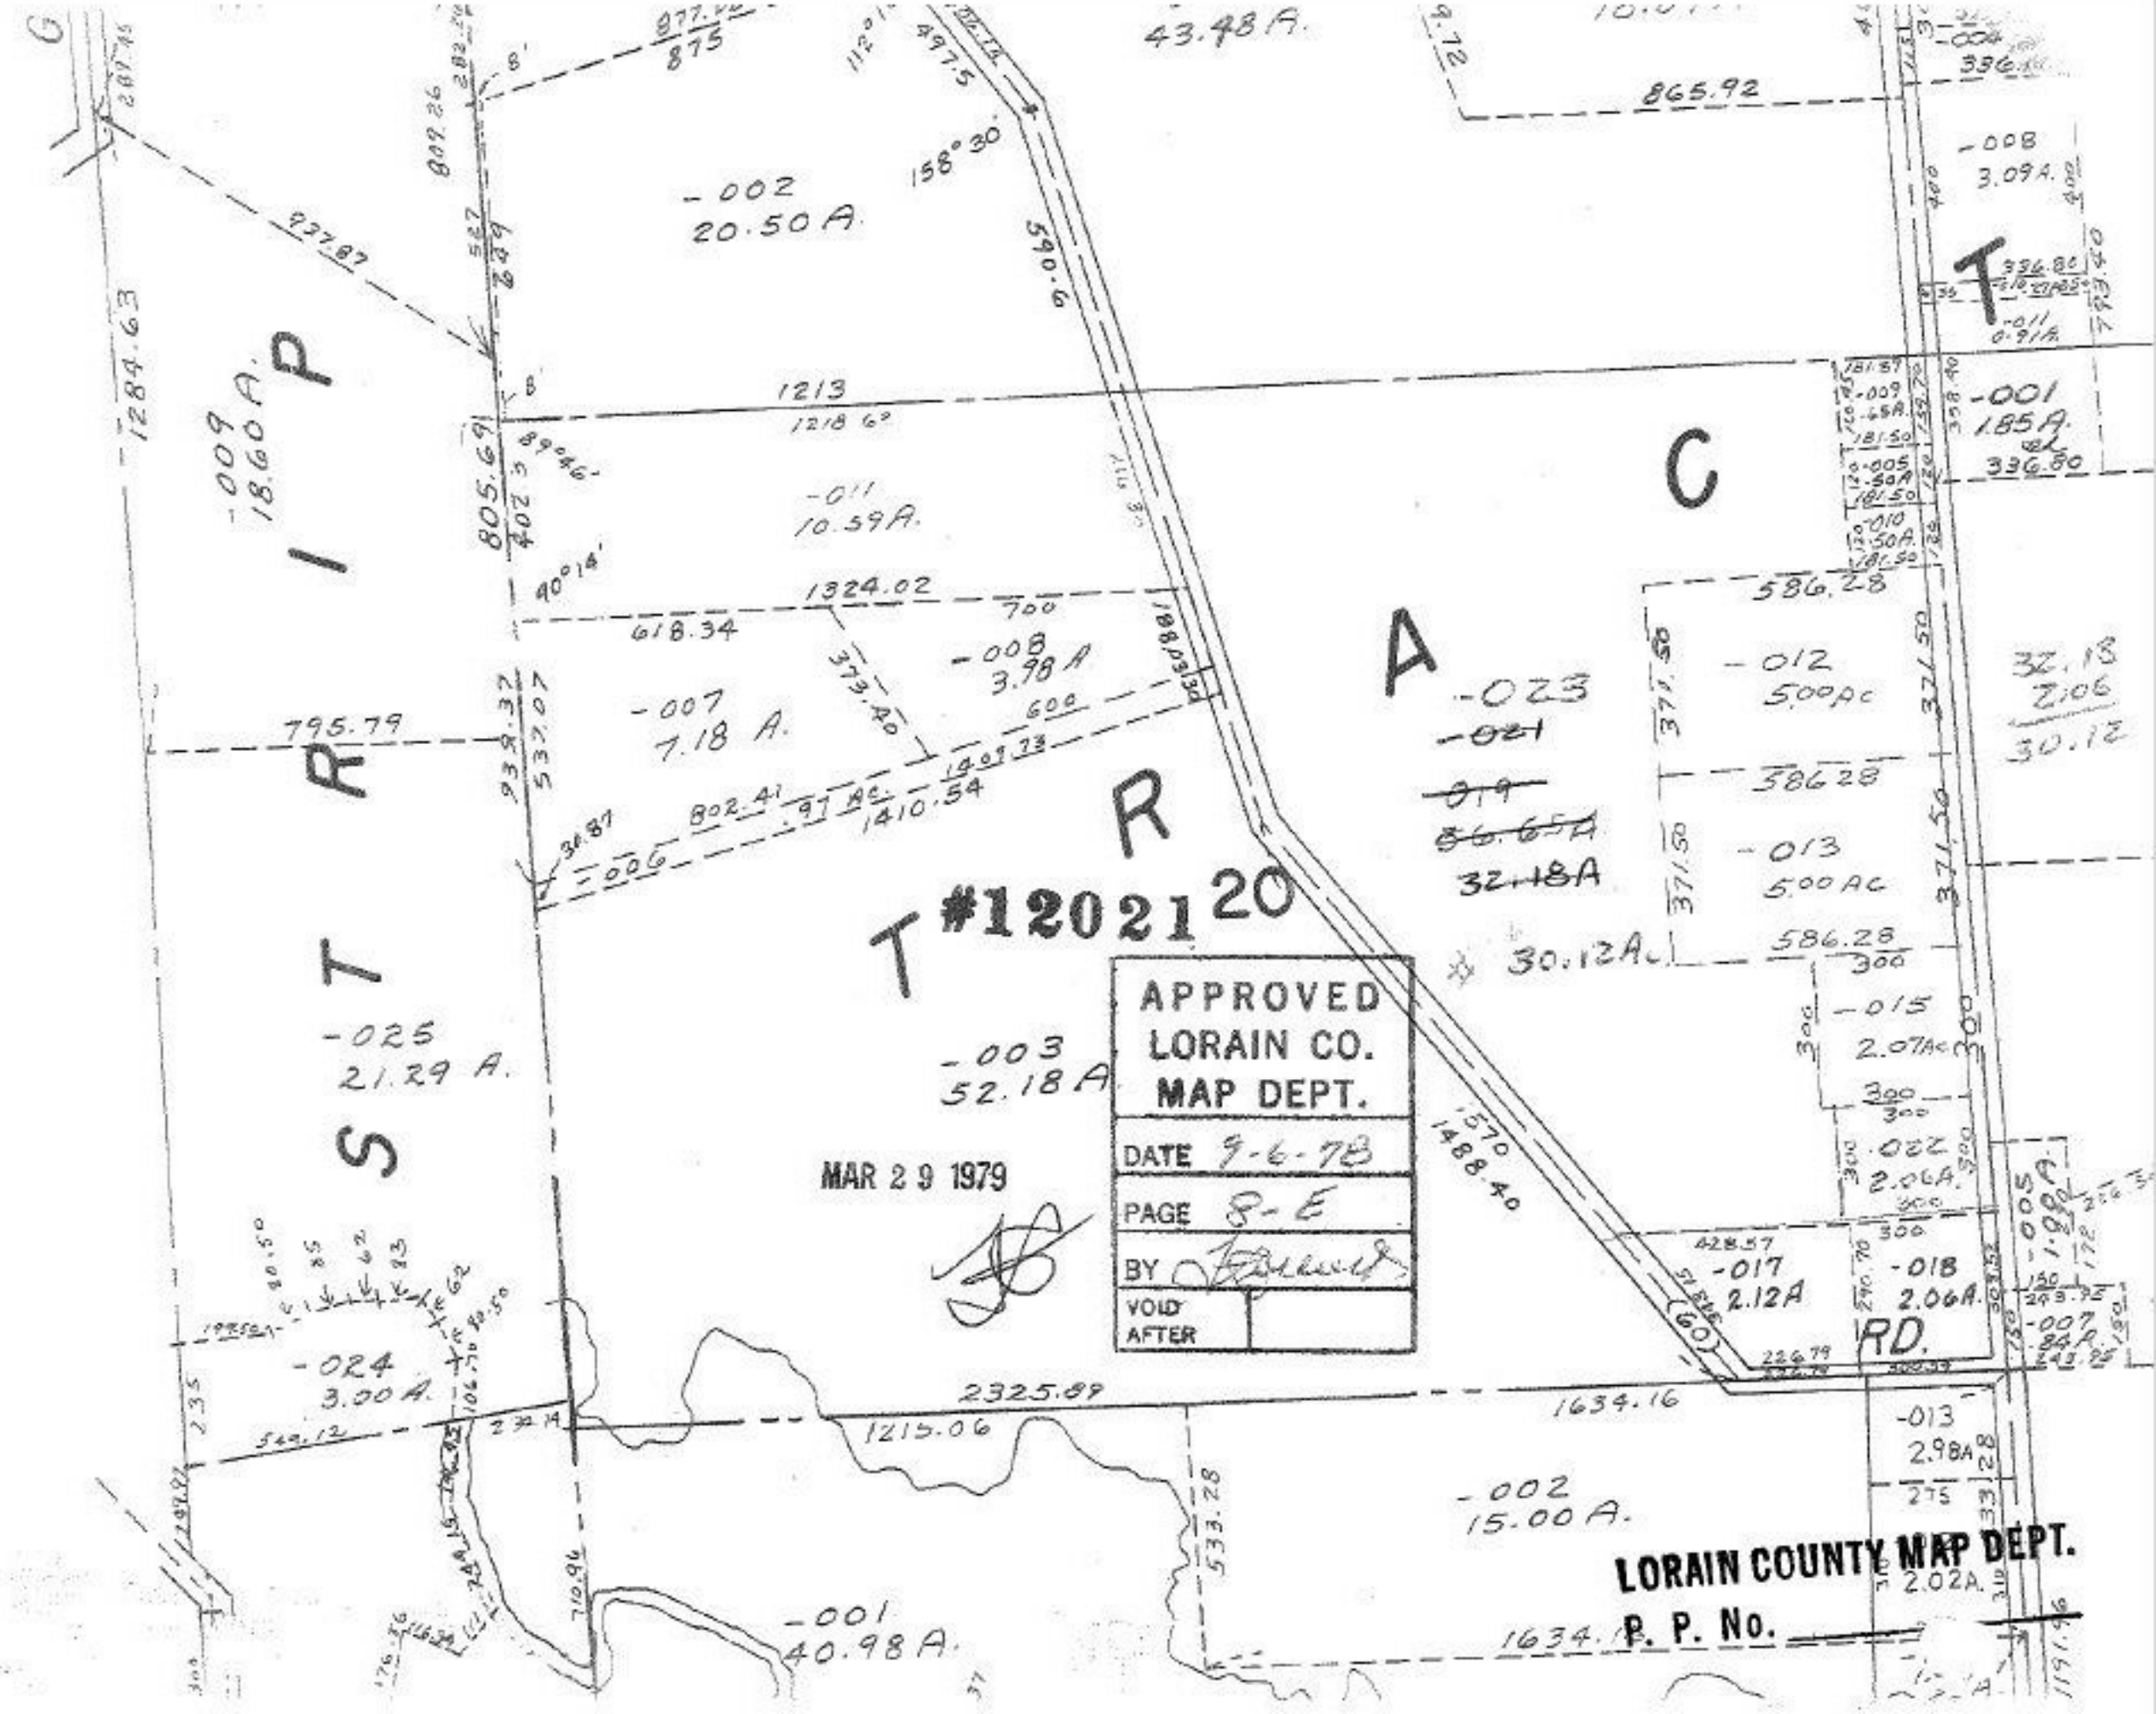

APPROVED
LORAIN CO.
MAP DEPT.
DATE 9-6-78
PAGE 8-E
BY
VOID AFTER

MAR 2 9 1979

#120212 0

LORAIN COUNTY MAP DEPT.

P. P. No.