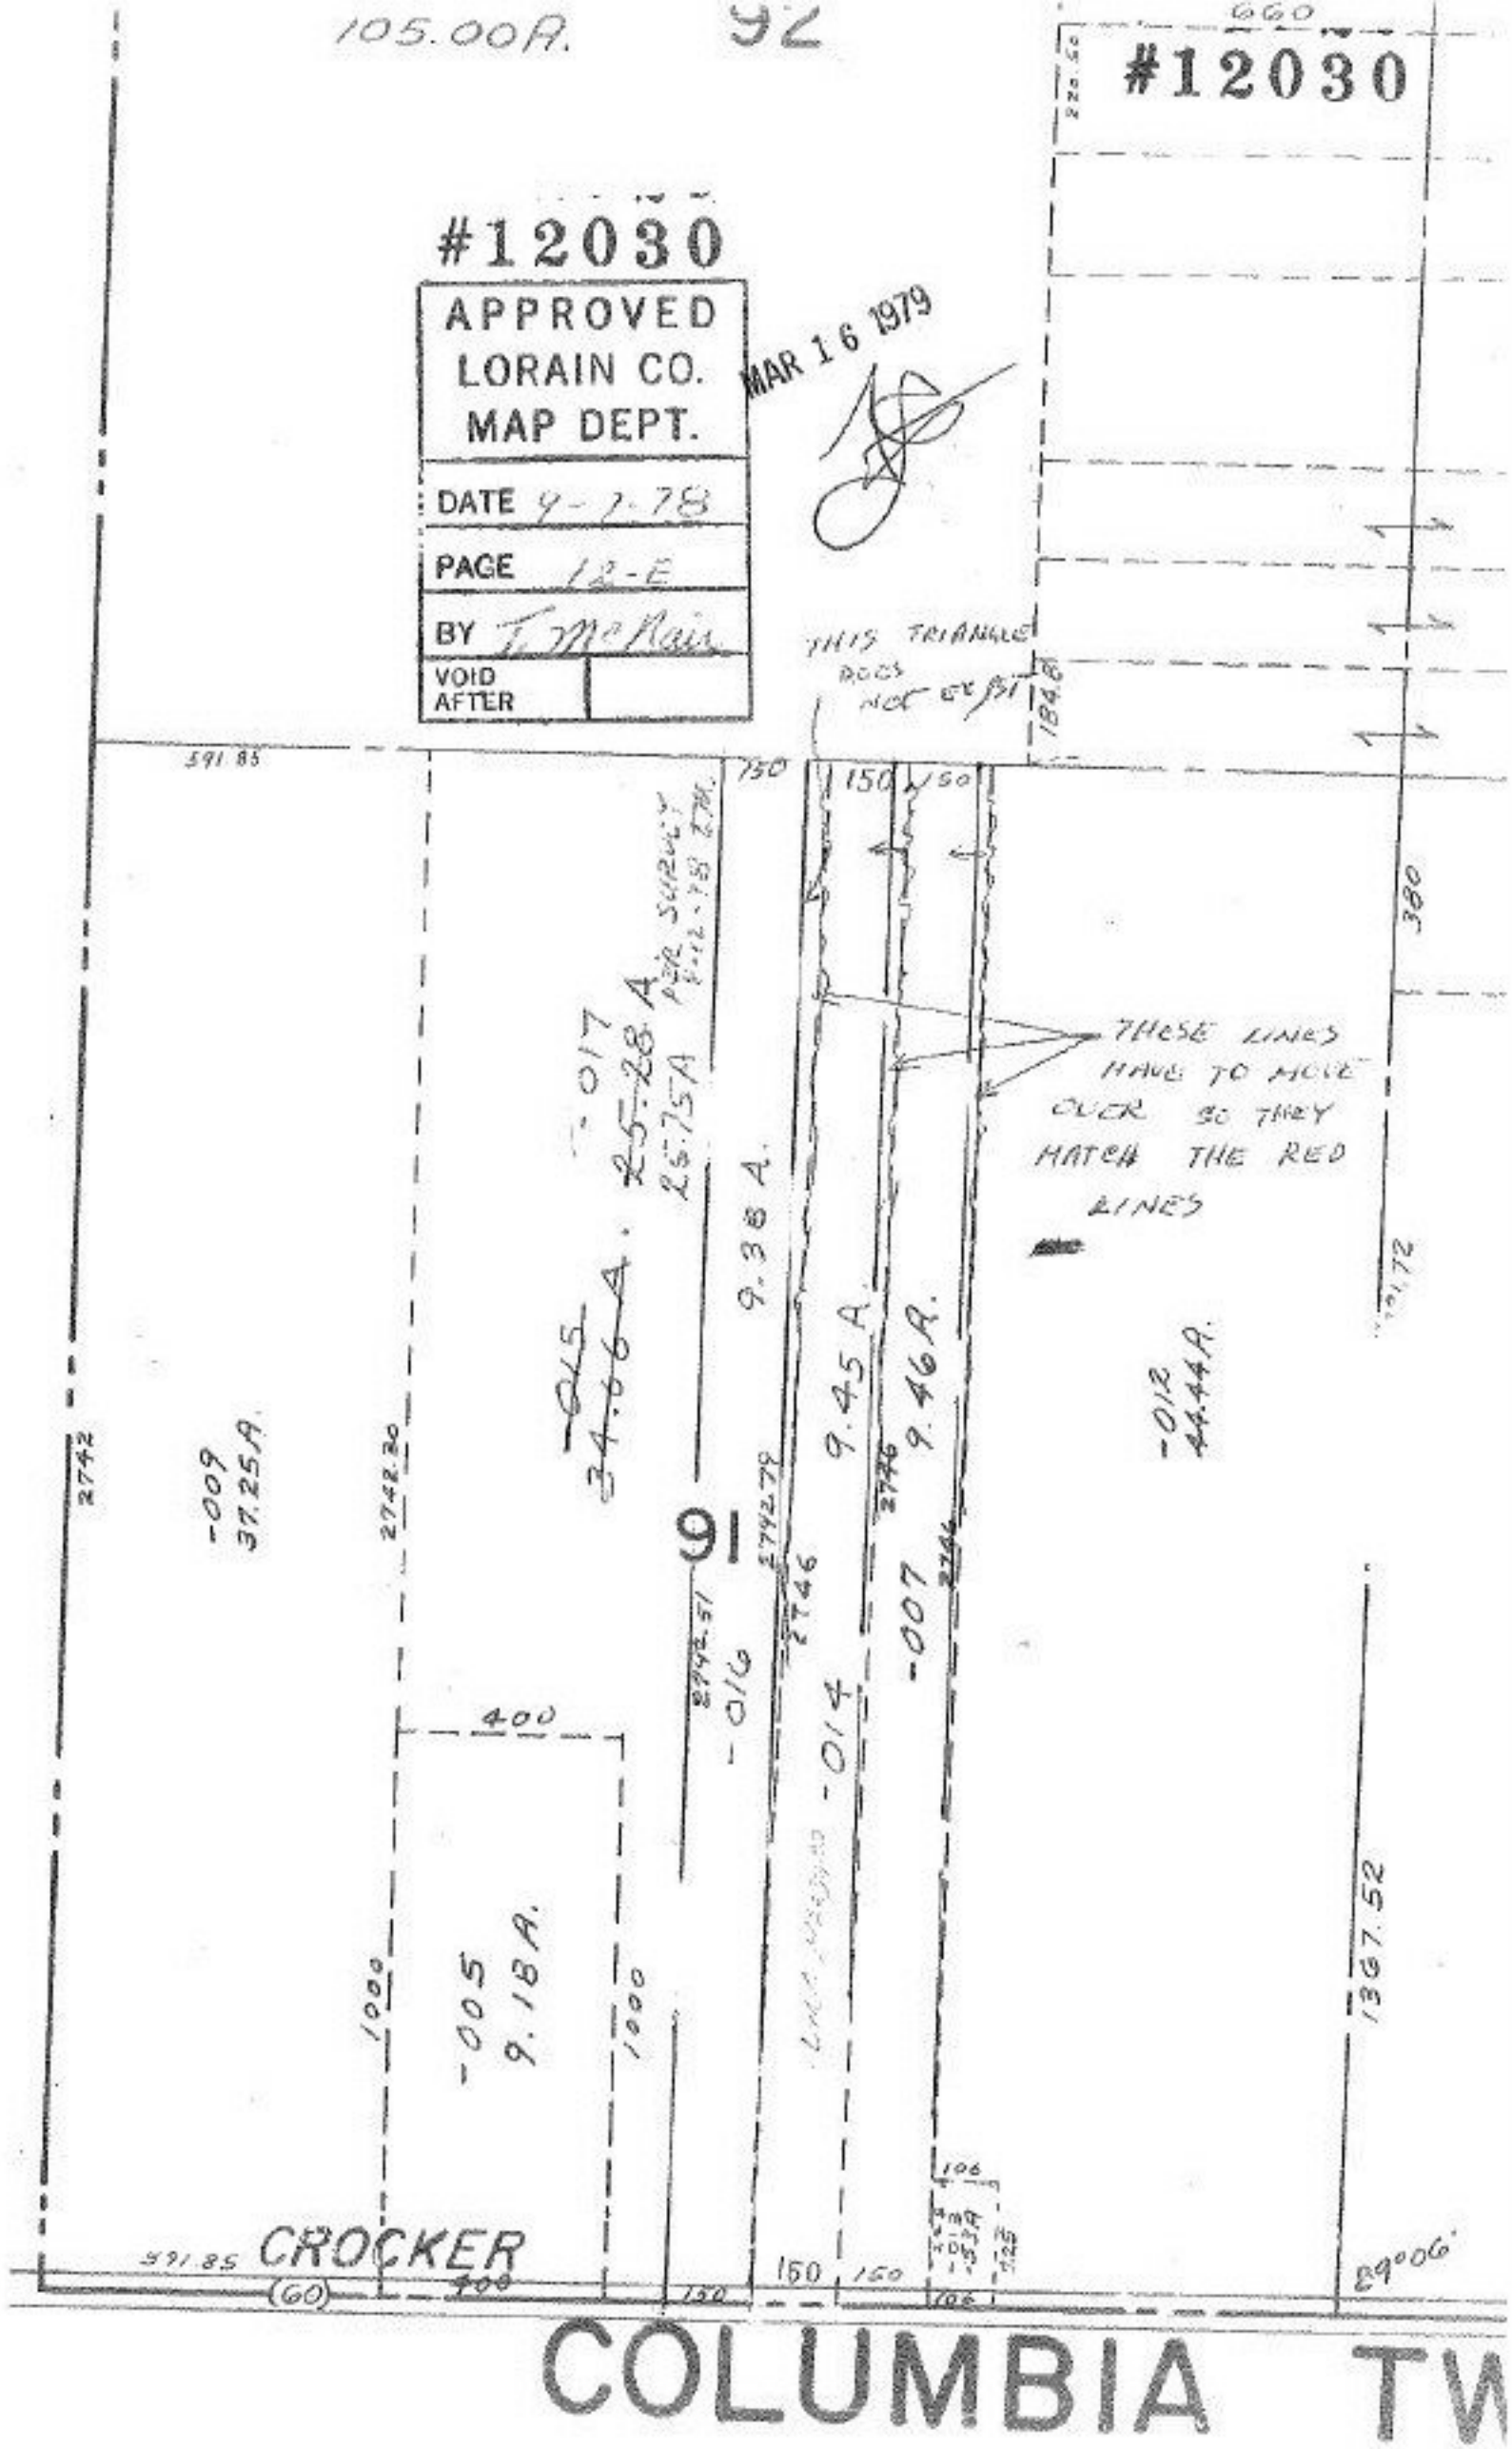
105.00A.
92
660
#12030
#12030
APPROVED
LORAIN CO.
MAP DEPT.
DATE 9-7-78
PAGE 12-E
BY T. McNair
VOID AFTER
MAR 16 1979
THIS TRIANGLE DOES NOT EXIST
591.85
150
150
150
184.81
380
THESE LINES HAVE TO MOVE OVER SO THEY MATCH THE RED LINES
-017
25.28 A
25.75A
PER SURVEY 9-12-78 T.M.
9.38 A.
9.45 A.
9.46 A.
-015
34.66 A.
-012
44.44 A.
-009
37.25 A.
2742
2742.30
2742.79
2746
2746
2746
91
2742.51
-016
-014
-007
400
-005
9.18 A.
1000
1000
1367.52
106
591.85
CROCKER
(60)
400
150
150
150
106
89°06'
COLUMBIA TW

162

E