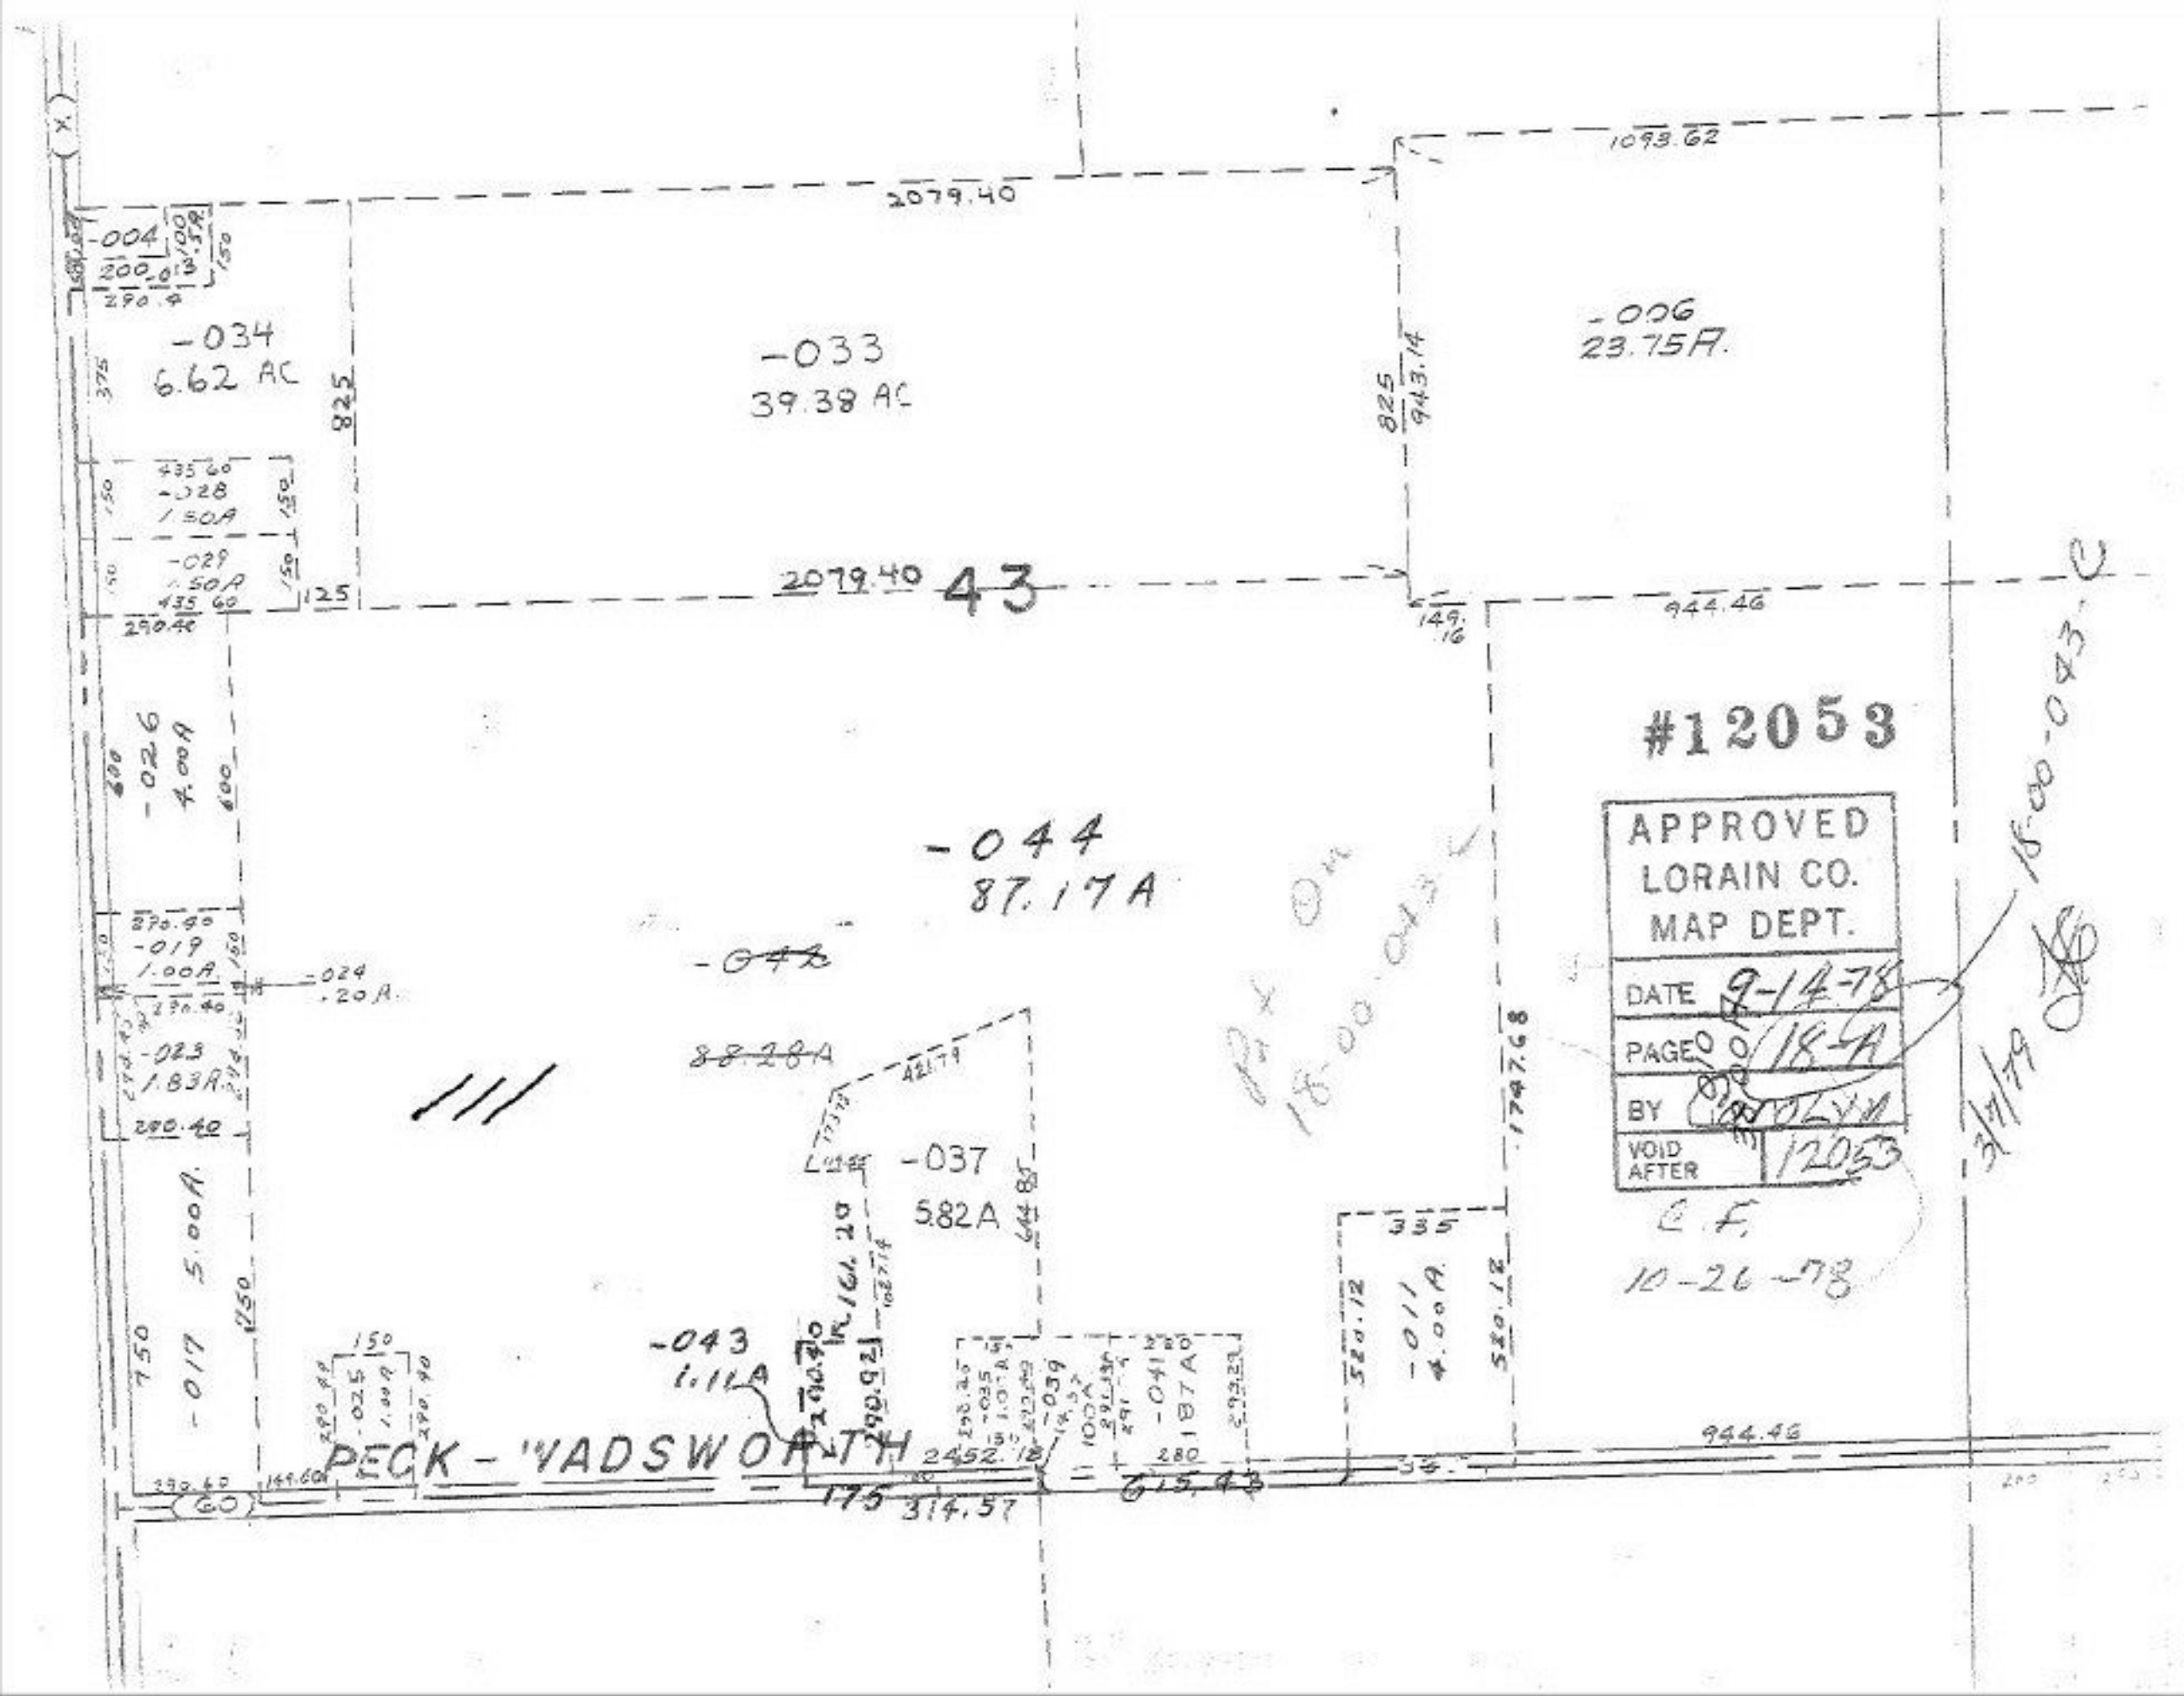

2079.40
1093.62
-004
200.013
290.4
-034
6.62 AC
825
-033
39.38 AC
825
943.14
-006
23.75A.
435.60
-028
1.50A
-029
1.50A
435.60
290.40
125
2079.40
43
149.16
944.46
#12053
APPROVED
LORAIN CO.
MAP DEPT.
DATE 9-14-78
PAGE 18-A
BY
VOID AFTER 12053
C.F.
10-26-78
18-00-043-C
3/7/79
-026
4.00A
-044
87.17A
-019
1.00A.
-024
.20A.
-023
1.83A.
290.40
-037
5.82A
1747.68
335
-011
4.00A.
520.12
-017
5.00A.
750
-043
1.11A
PECK - WADSWORTH
2452.18
175
314.57
615.43
944.46