12055

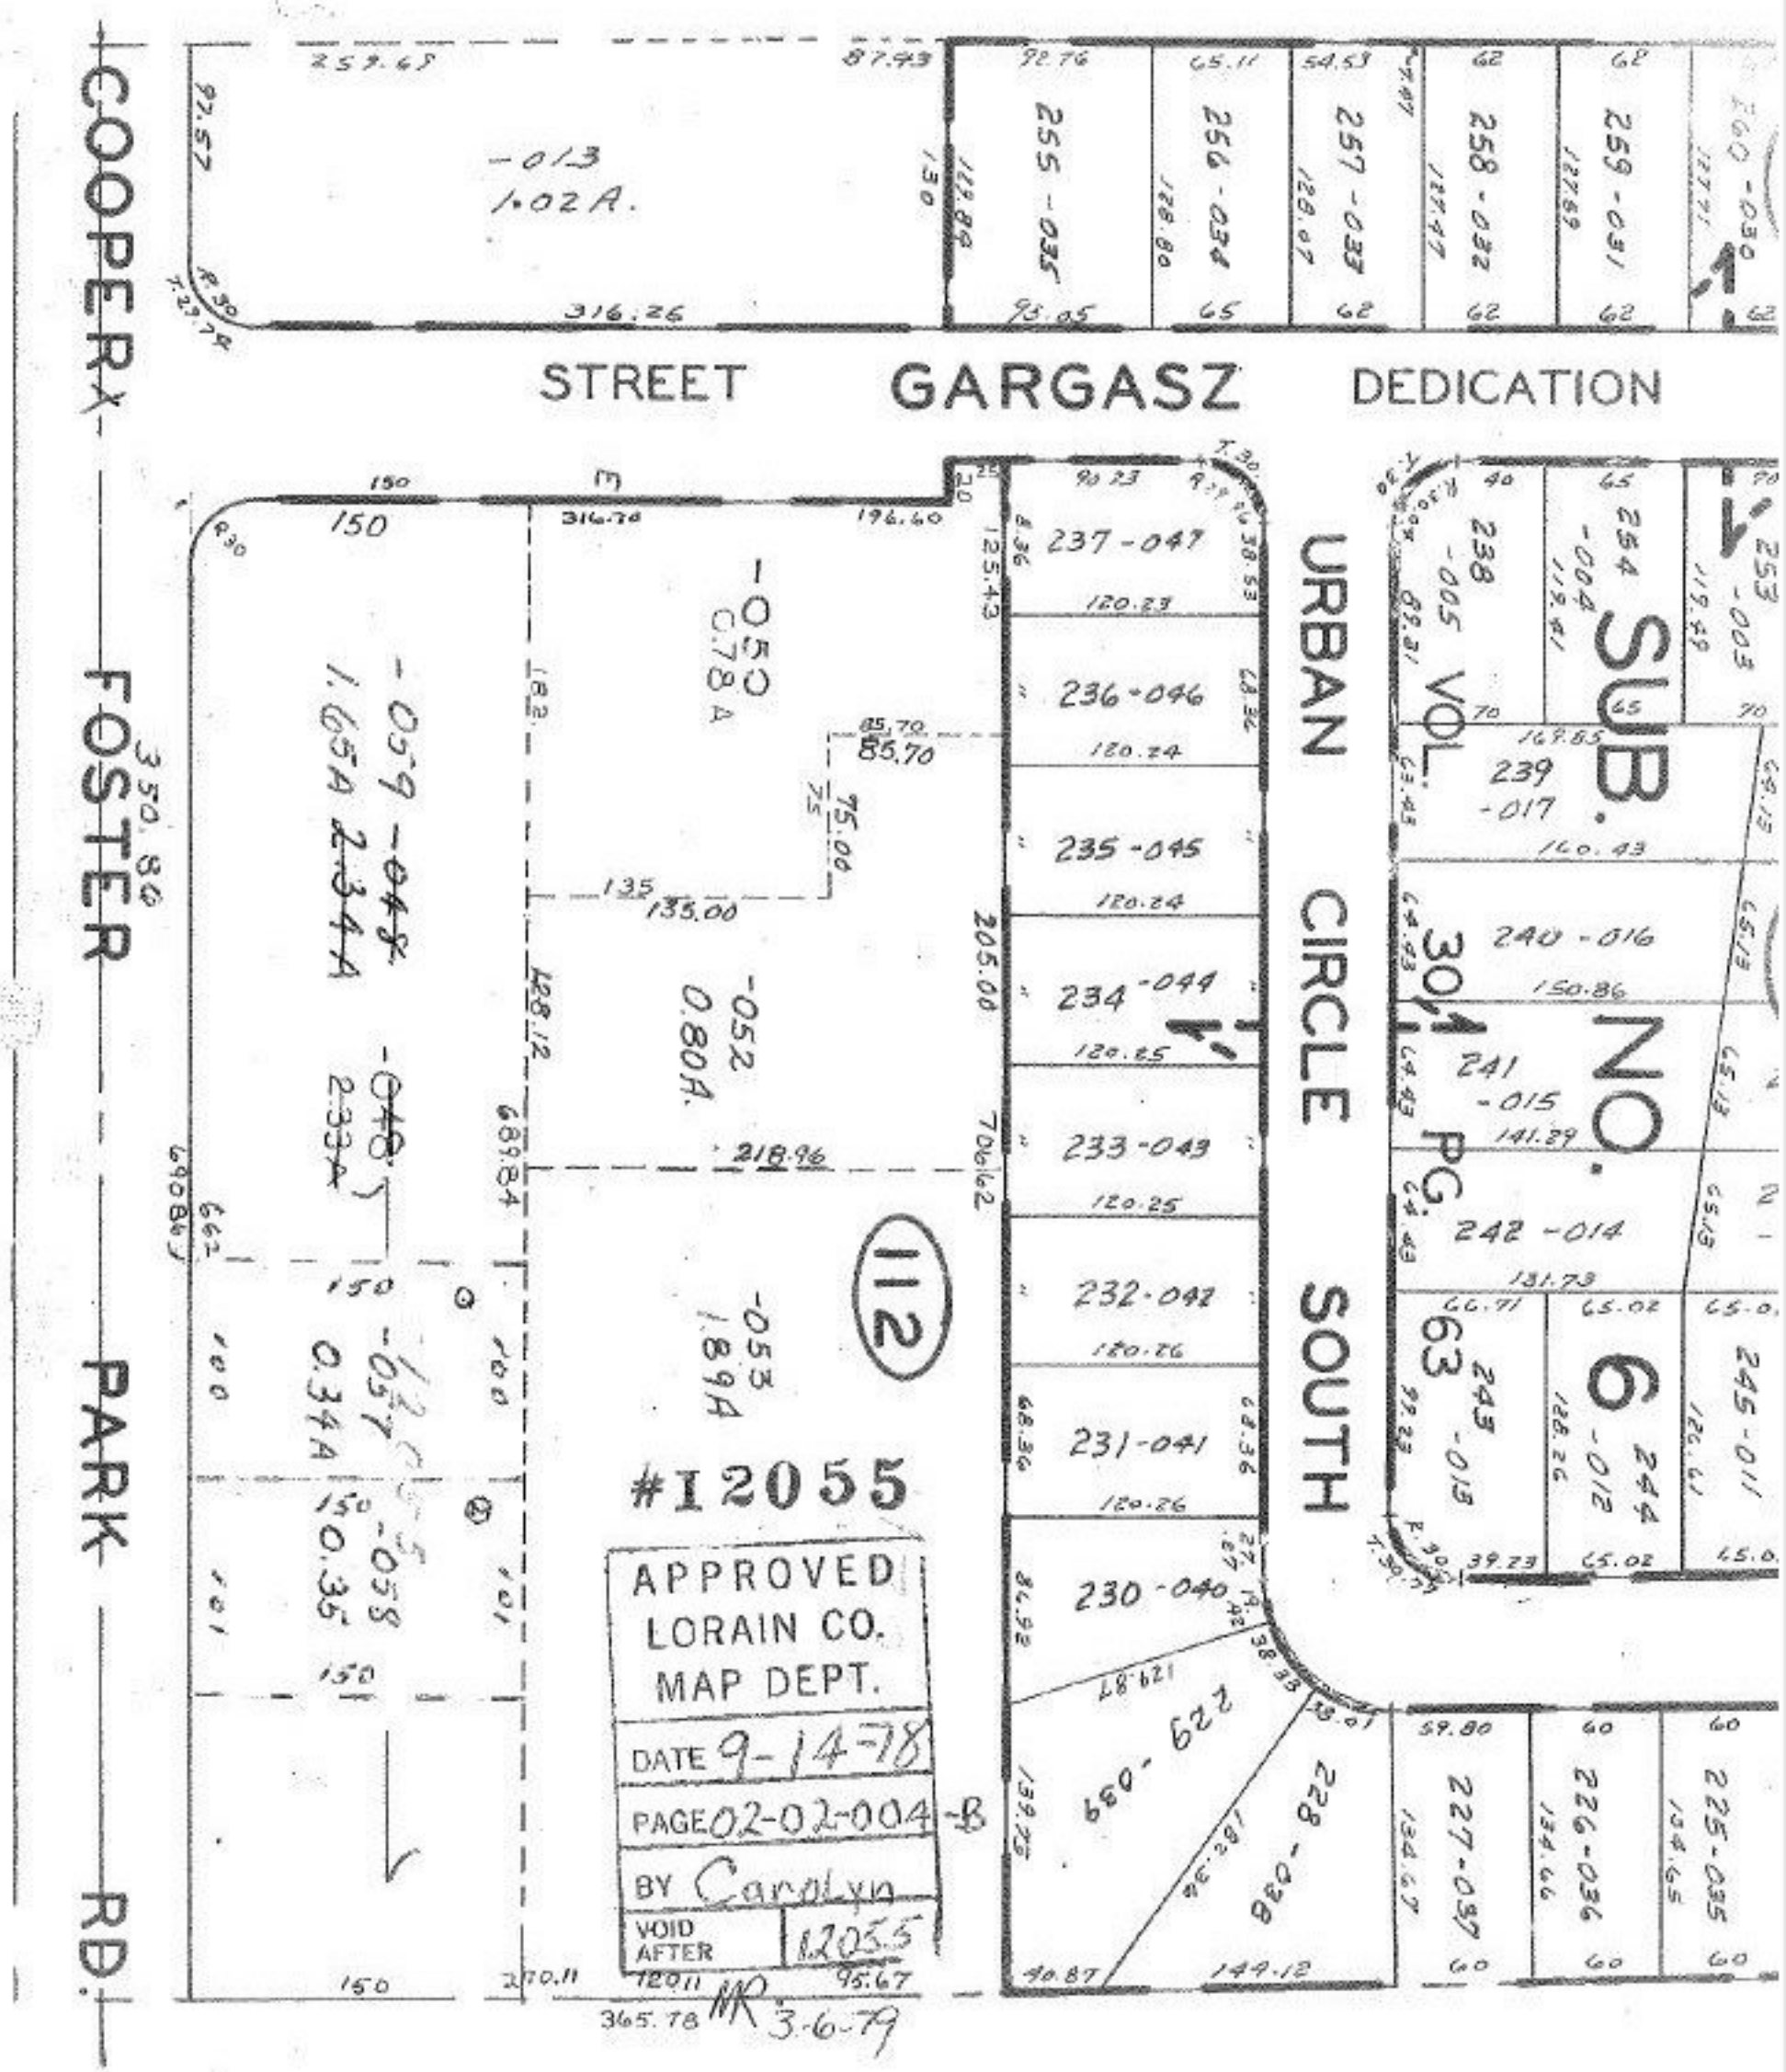

COOPER
FOSTER
PARK
RD.
STREET
GARGASZ
DEDICATION
URBAN
CIRCLE
SOUTH
SUB.
NO.
6
VOL.
30
PG.
63
-013
1.02A.
255-035
256-034
257-033
258-032
259-031
237-047
236-046
235-045
234-044
233-043
232-042
231-041
230-040
229-039
228-038
227-037
226-036
225-035
-050
0.78A
-052
0.80A.
-053
1.89A
-059
1.65A
-048
2.34A
-057
0.34A
-058
0.35
112
#12055
APPROVED
LORAIN CO.
MAP DEPT.
DATE 9-14-78
PAGE 02-02-004-B
BY Carolyn
VOID AFTER 12055
MR 3-6-79