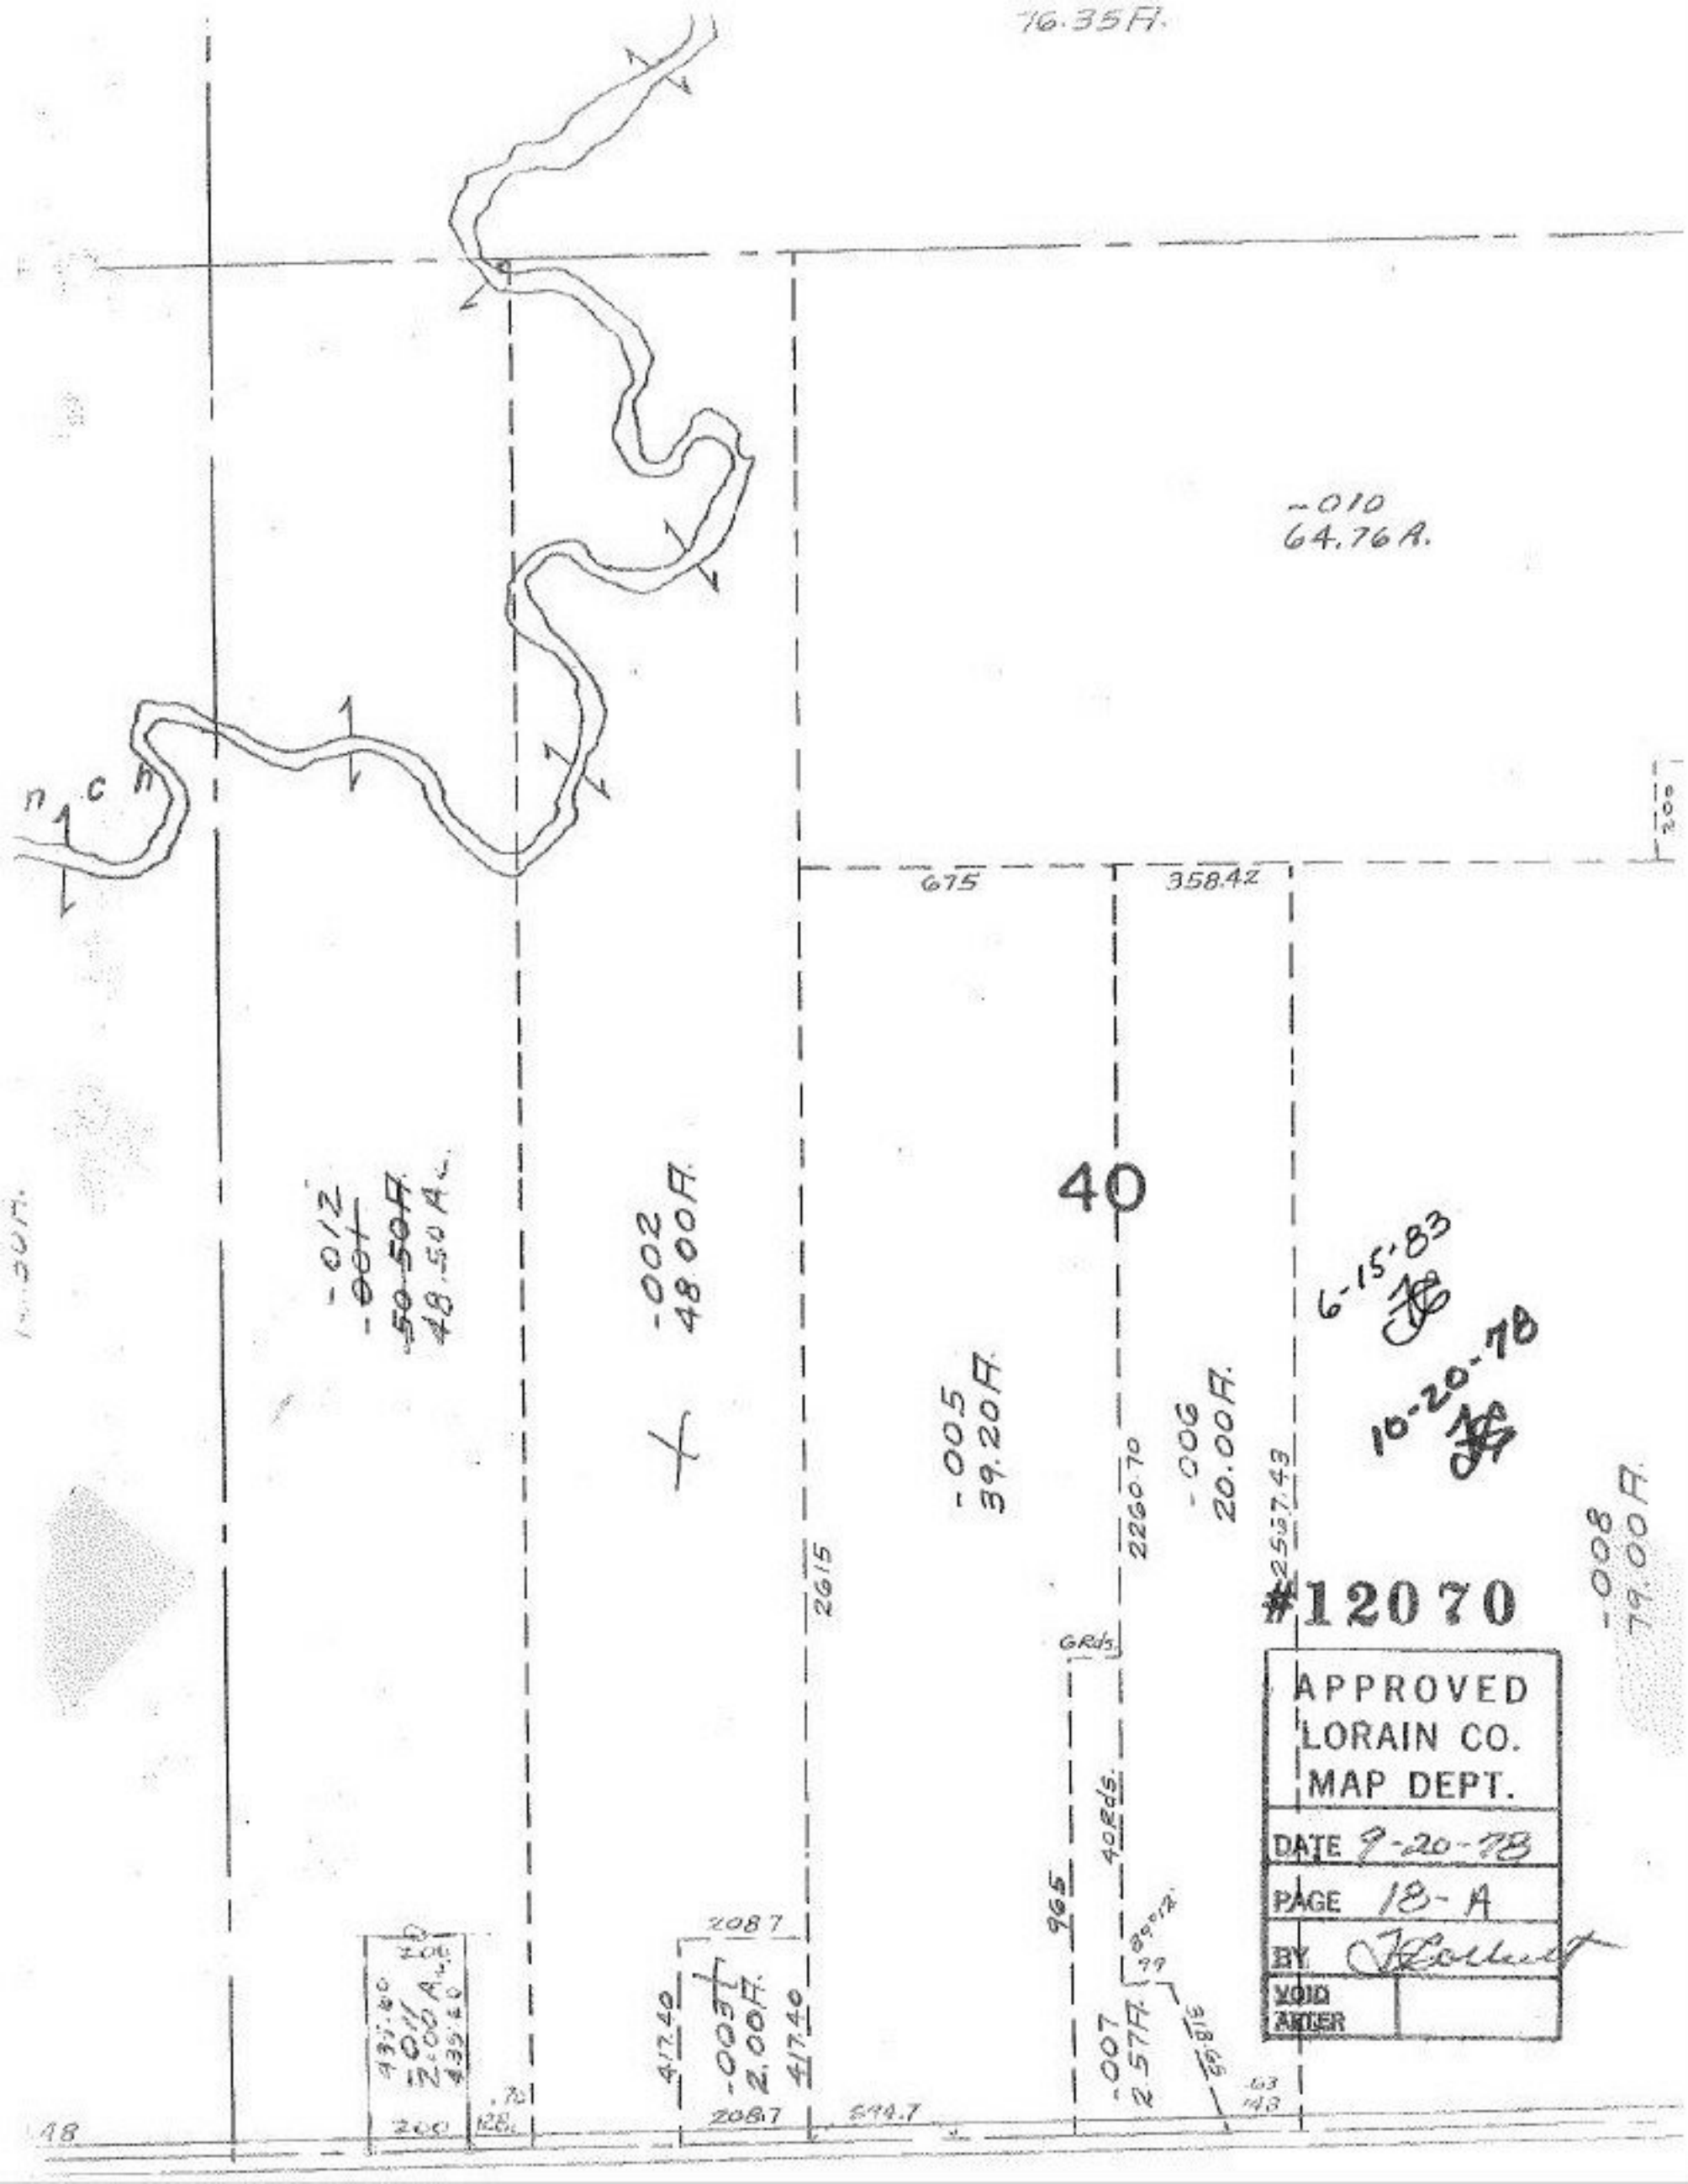
76.35A.
-010
64.76A.
675
358.42
40
-012
-001
50.50A.
48.50A.
-002
48.00A.
-005
39.20A.
-006
20.00A.
-008
79.00A.
6-15-83
10-20-78
2260.70
2567.43
2615
GRds.
40Rds.
965
-007
2.57A.
-003
2.00A.
417.40
208.7
594.7
#12070
APPROVED
LORAIN CO.
MAP DEPT.
DATE 9-20-78
PAGE 18-A
BY
VOID
AFTER