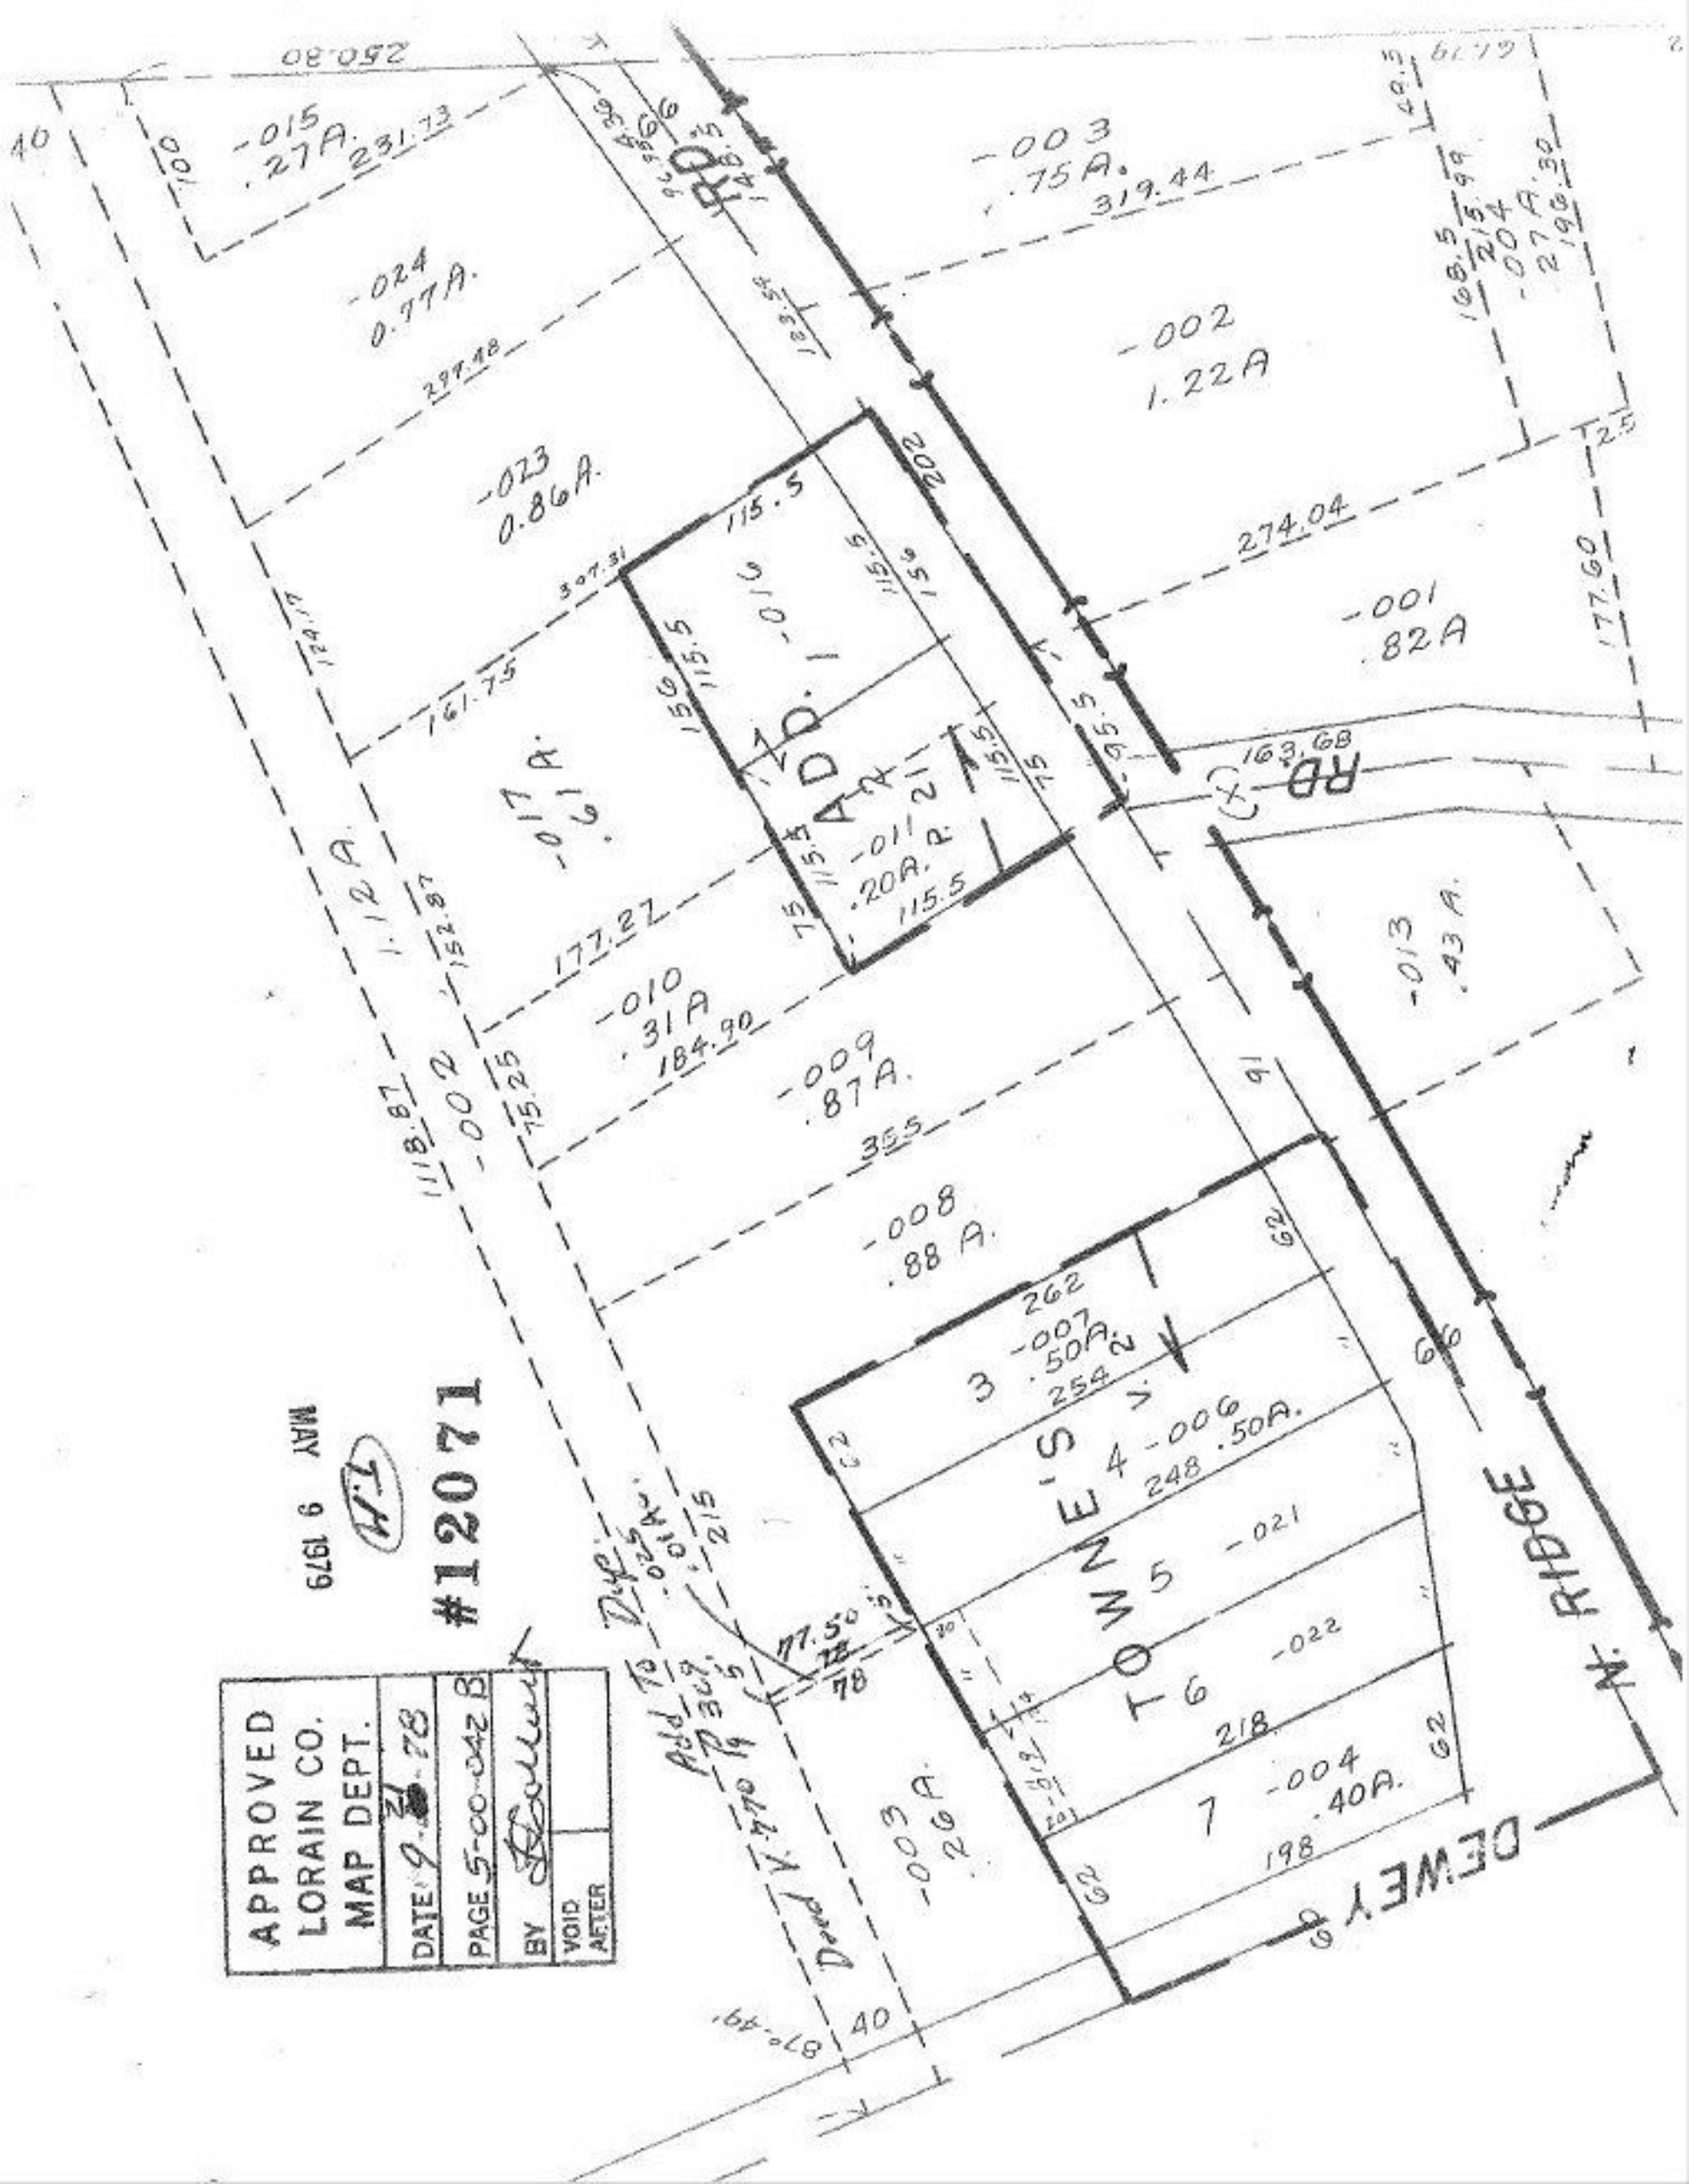

APPROVED
LORAIN CO.
MAP DEPT.
DATE 9-21-78
PAGE 5-00-042 B
BY
VOID AFTER
#12071
MAY 9 1979
-015 .27A. 231.73
-024 0.77A.
-023 0.86A.
-003 .75A. 319.44
-002 1.22A
-001 .82A
-017 .61A.
-010 .31A 184.90
-009 .87A.
-008 .88 A.
-013 .43 A.
-003 .26A.
-011 .20A.
-016
ADD. 1
TOWNE'S
3 -007 .50A. 254
4 -006 .50A. 248
5 -021
6 -022 218
7 -004 .40A. 198
N. RIDGE
DEWEY
RD