12082

12082

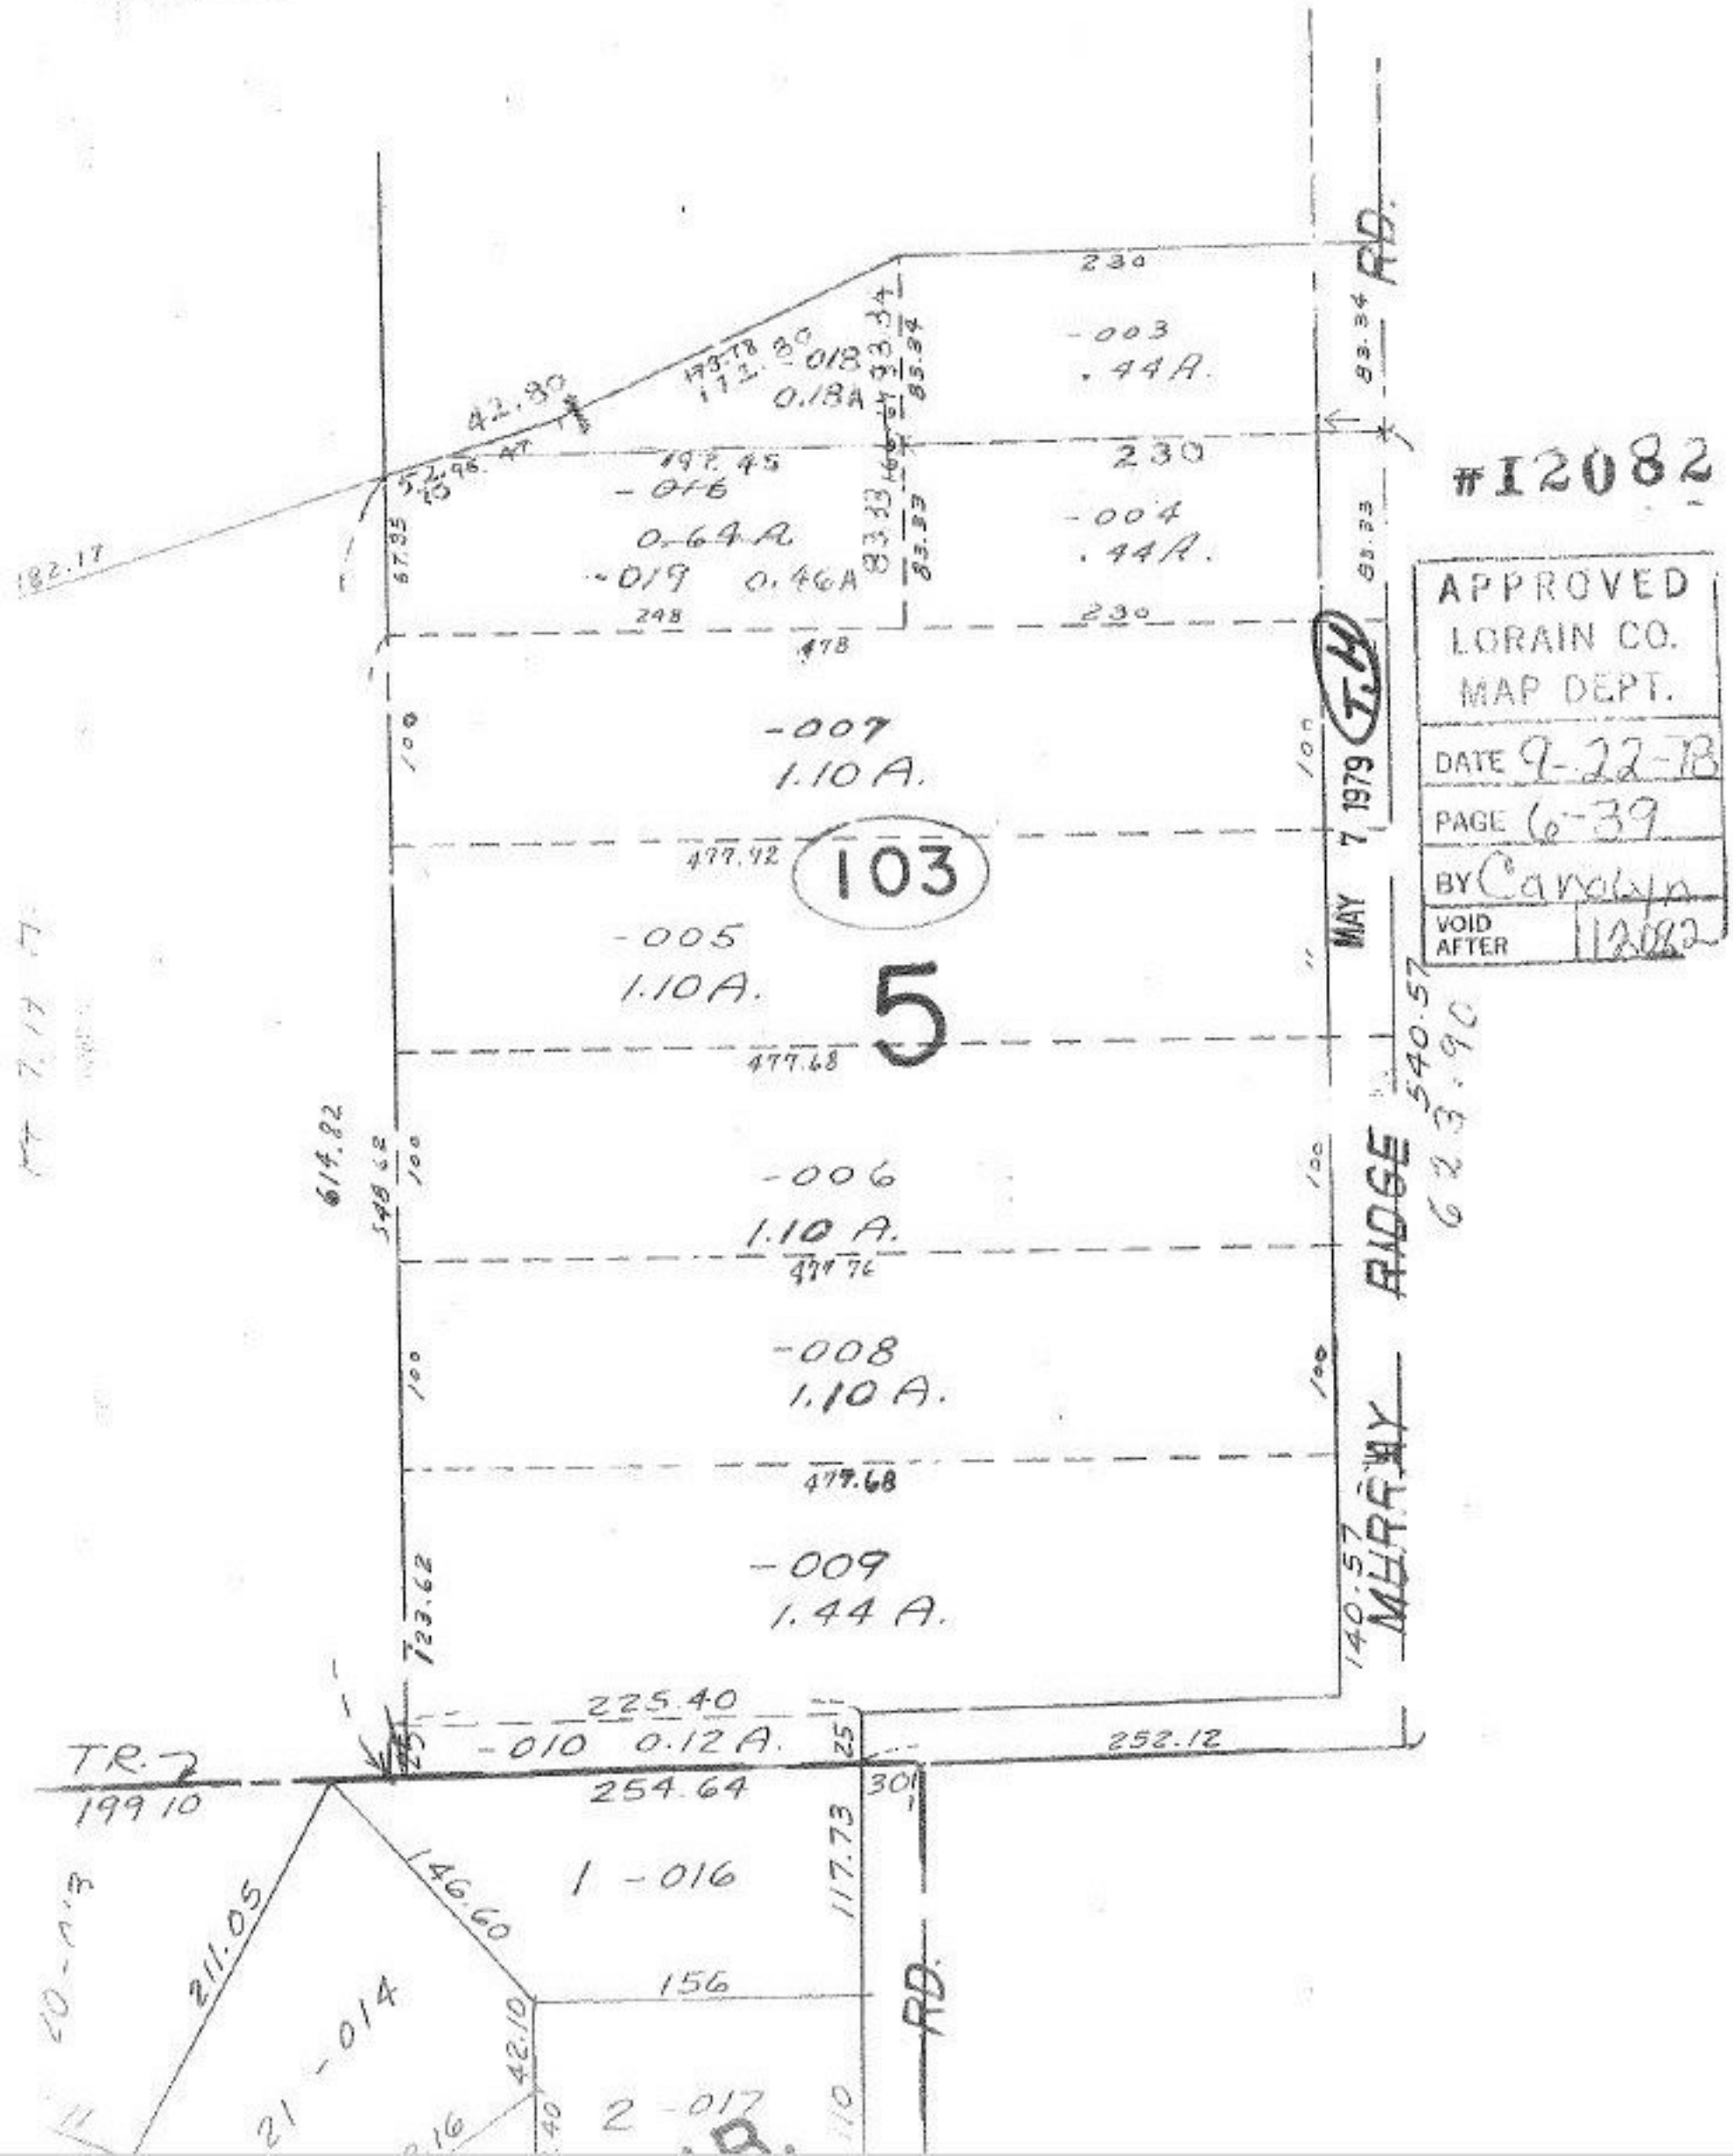

#12082

APPROVED
LORAIN CO.
MAP DEPT.
DATE 9-22-78
PAGE 6-39
BY Carolyn
VOID AFTER 12082