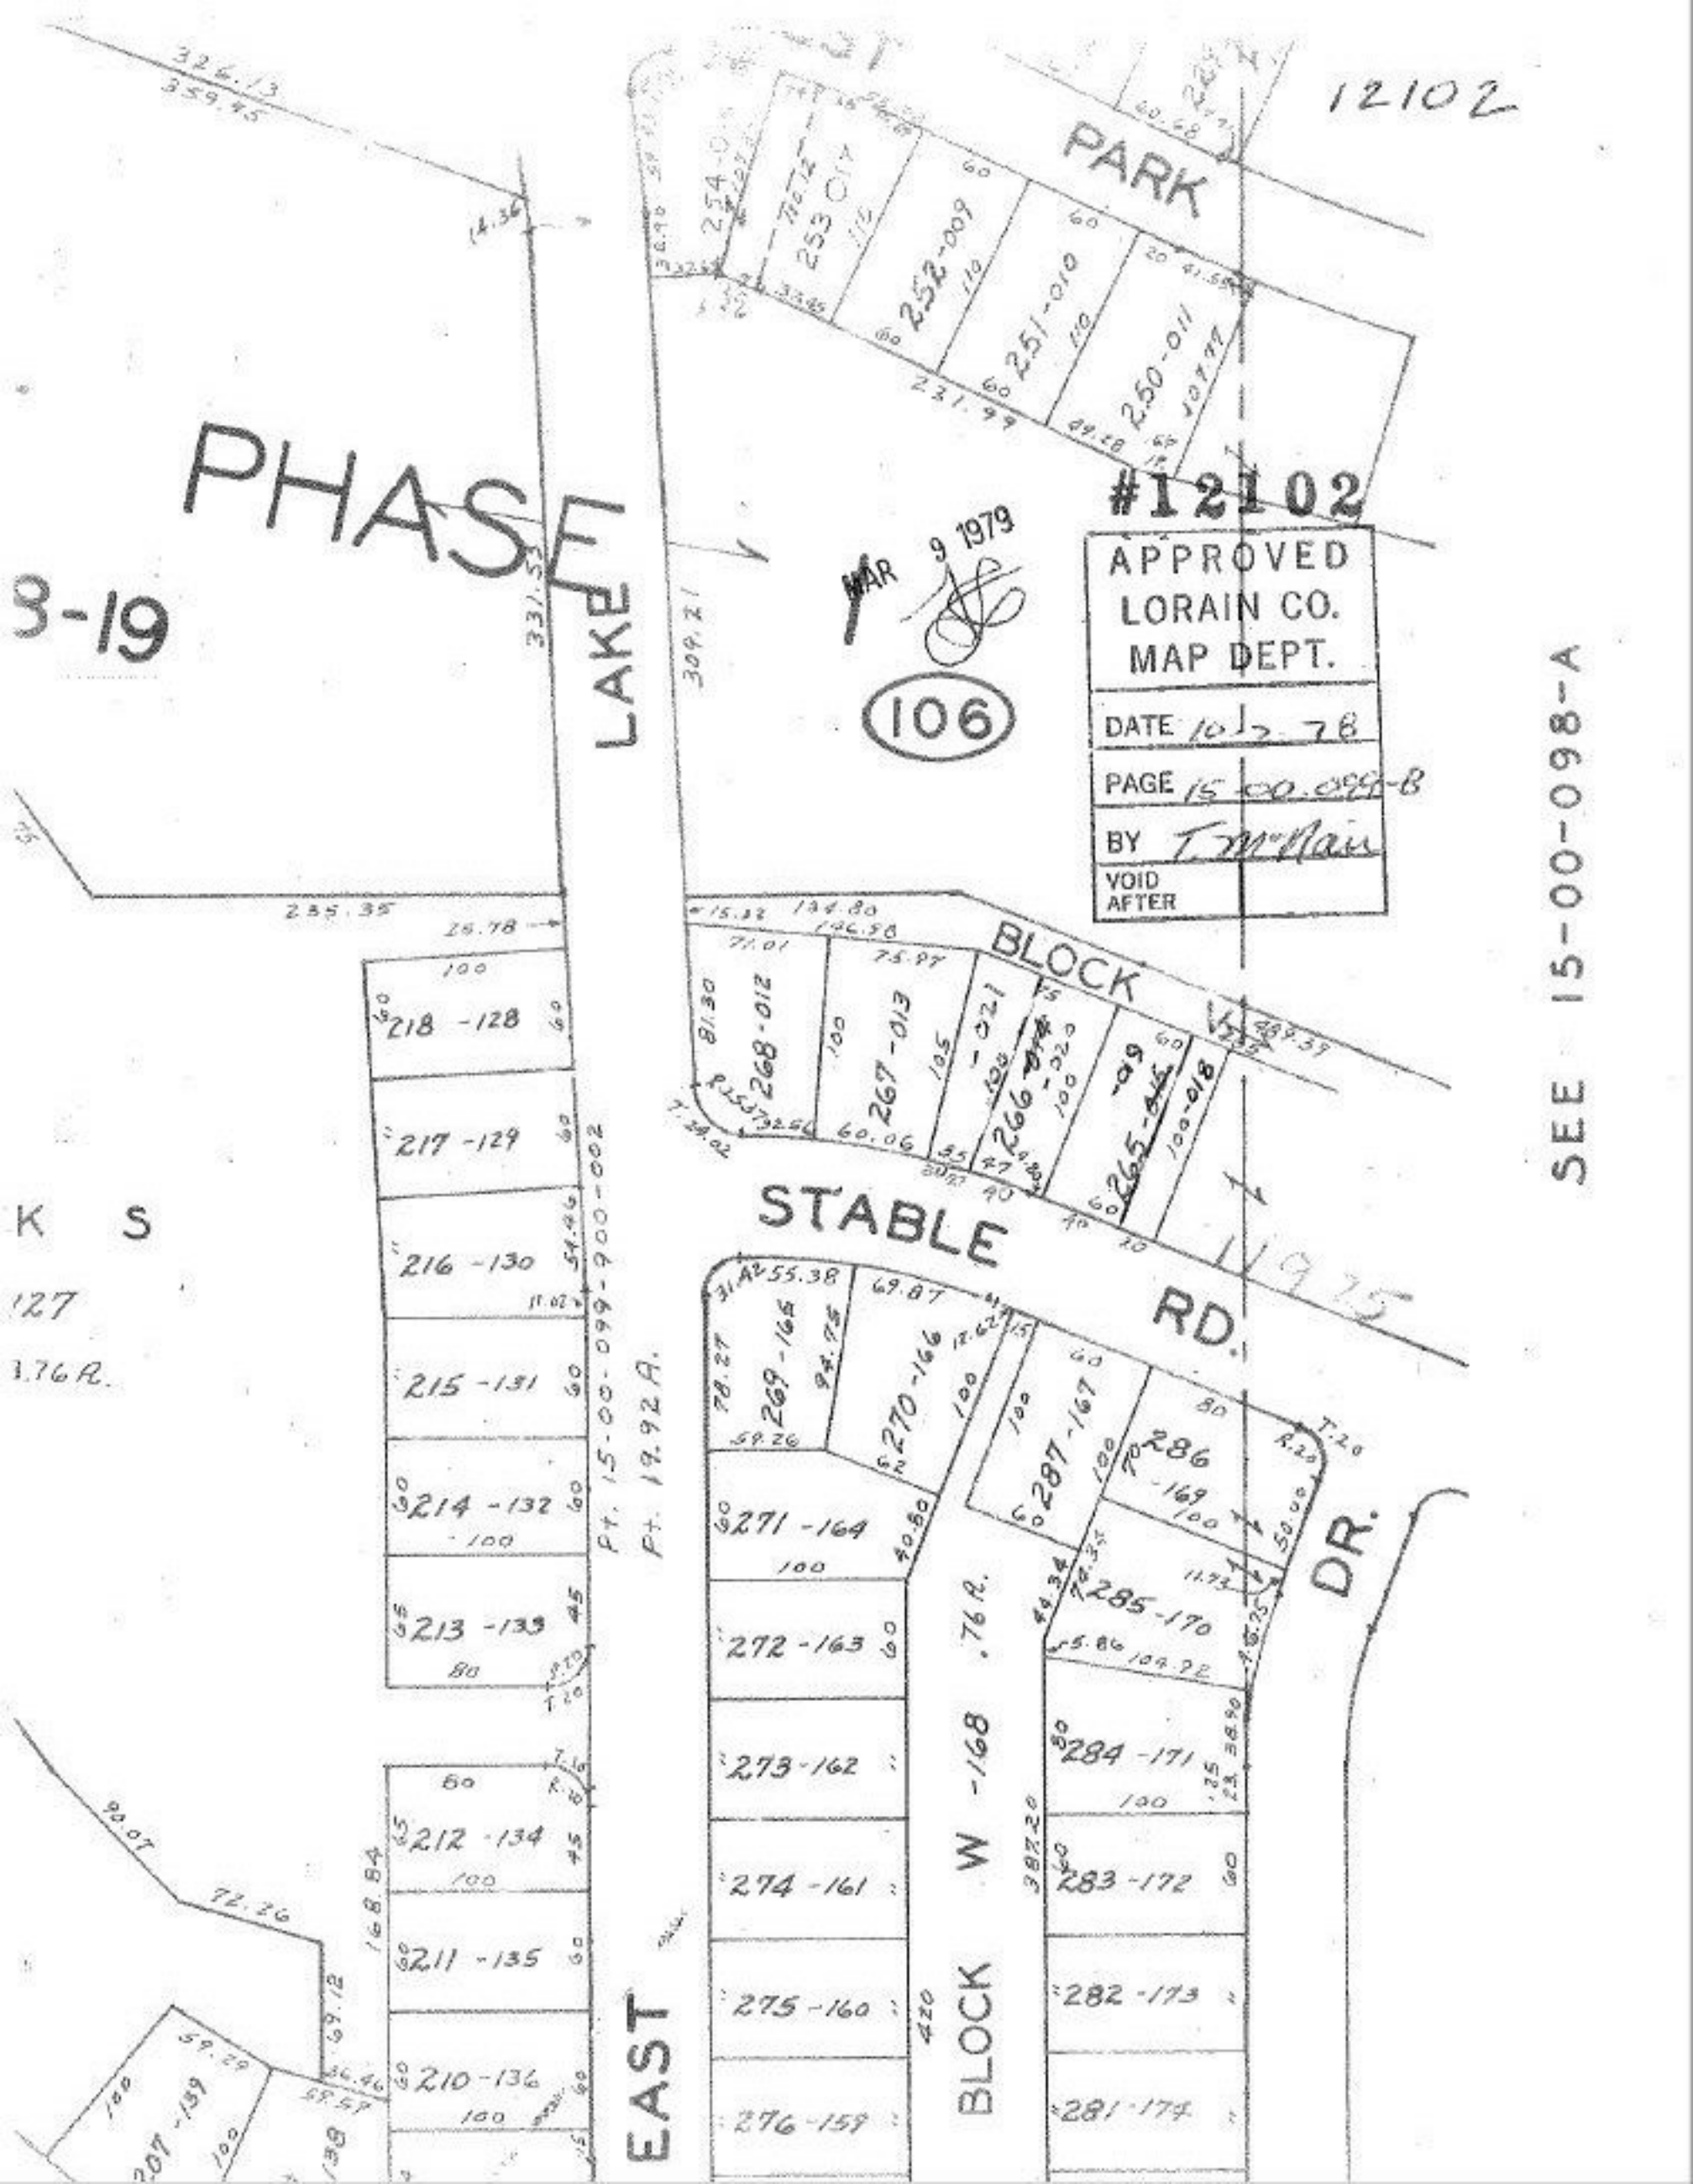
12102
PARK
PHASE
8-19
LAKE
#12102
APPROVED
LORAIN CO.
MAP DEPT.
DATE 10-2-78
PAGE 15-00-099-B
BY T. McNair
VOID AFTER
MAR 9 1979
106
BLOCK
STABLE RD.
DR.
EAST
BLOCK W -168 .76 A.
Pt. 15-00-099-900-002
Pt. 19.92 A.
SEE 15-00-098-A
K S
127
3.76 A.
218 -128
217 -129
216 -130
215 -131
214 -132
213 -133
212 -134
211 -135
210 -136
268-012
267-013
266-014
265-015
269-165
270-166
271-164
272-163
273-162
274-161
275-160
276-159
287-167
286-169
285-170
284-171
283-172
282-173
281-174
253-017
252-009
251-010
250-011
254-016
235.35
331.53
309.21
231.99
326.13
359.45
90.07
72.26
168.84
387.20
420