12104

Walk-way 10 ft wide.

#12104

VACATED WALK-way.

VACATED Equally To Abutting property owners. Each Abutting owner will Receive 5' ft. The length of his or her's sublot.

APPROVED
LORAIN CO.
MAP DEPT.
DATE 10-3-78
PAGE 6-82
BY Carolyn
VOID AFTER 12104
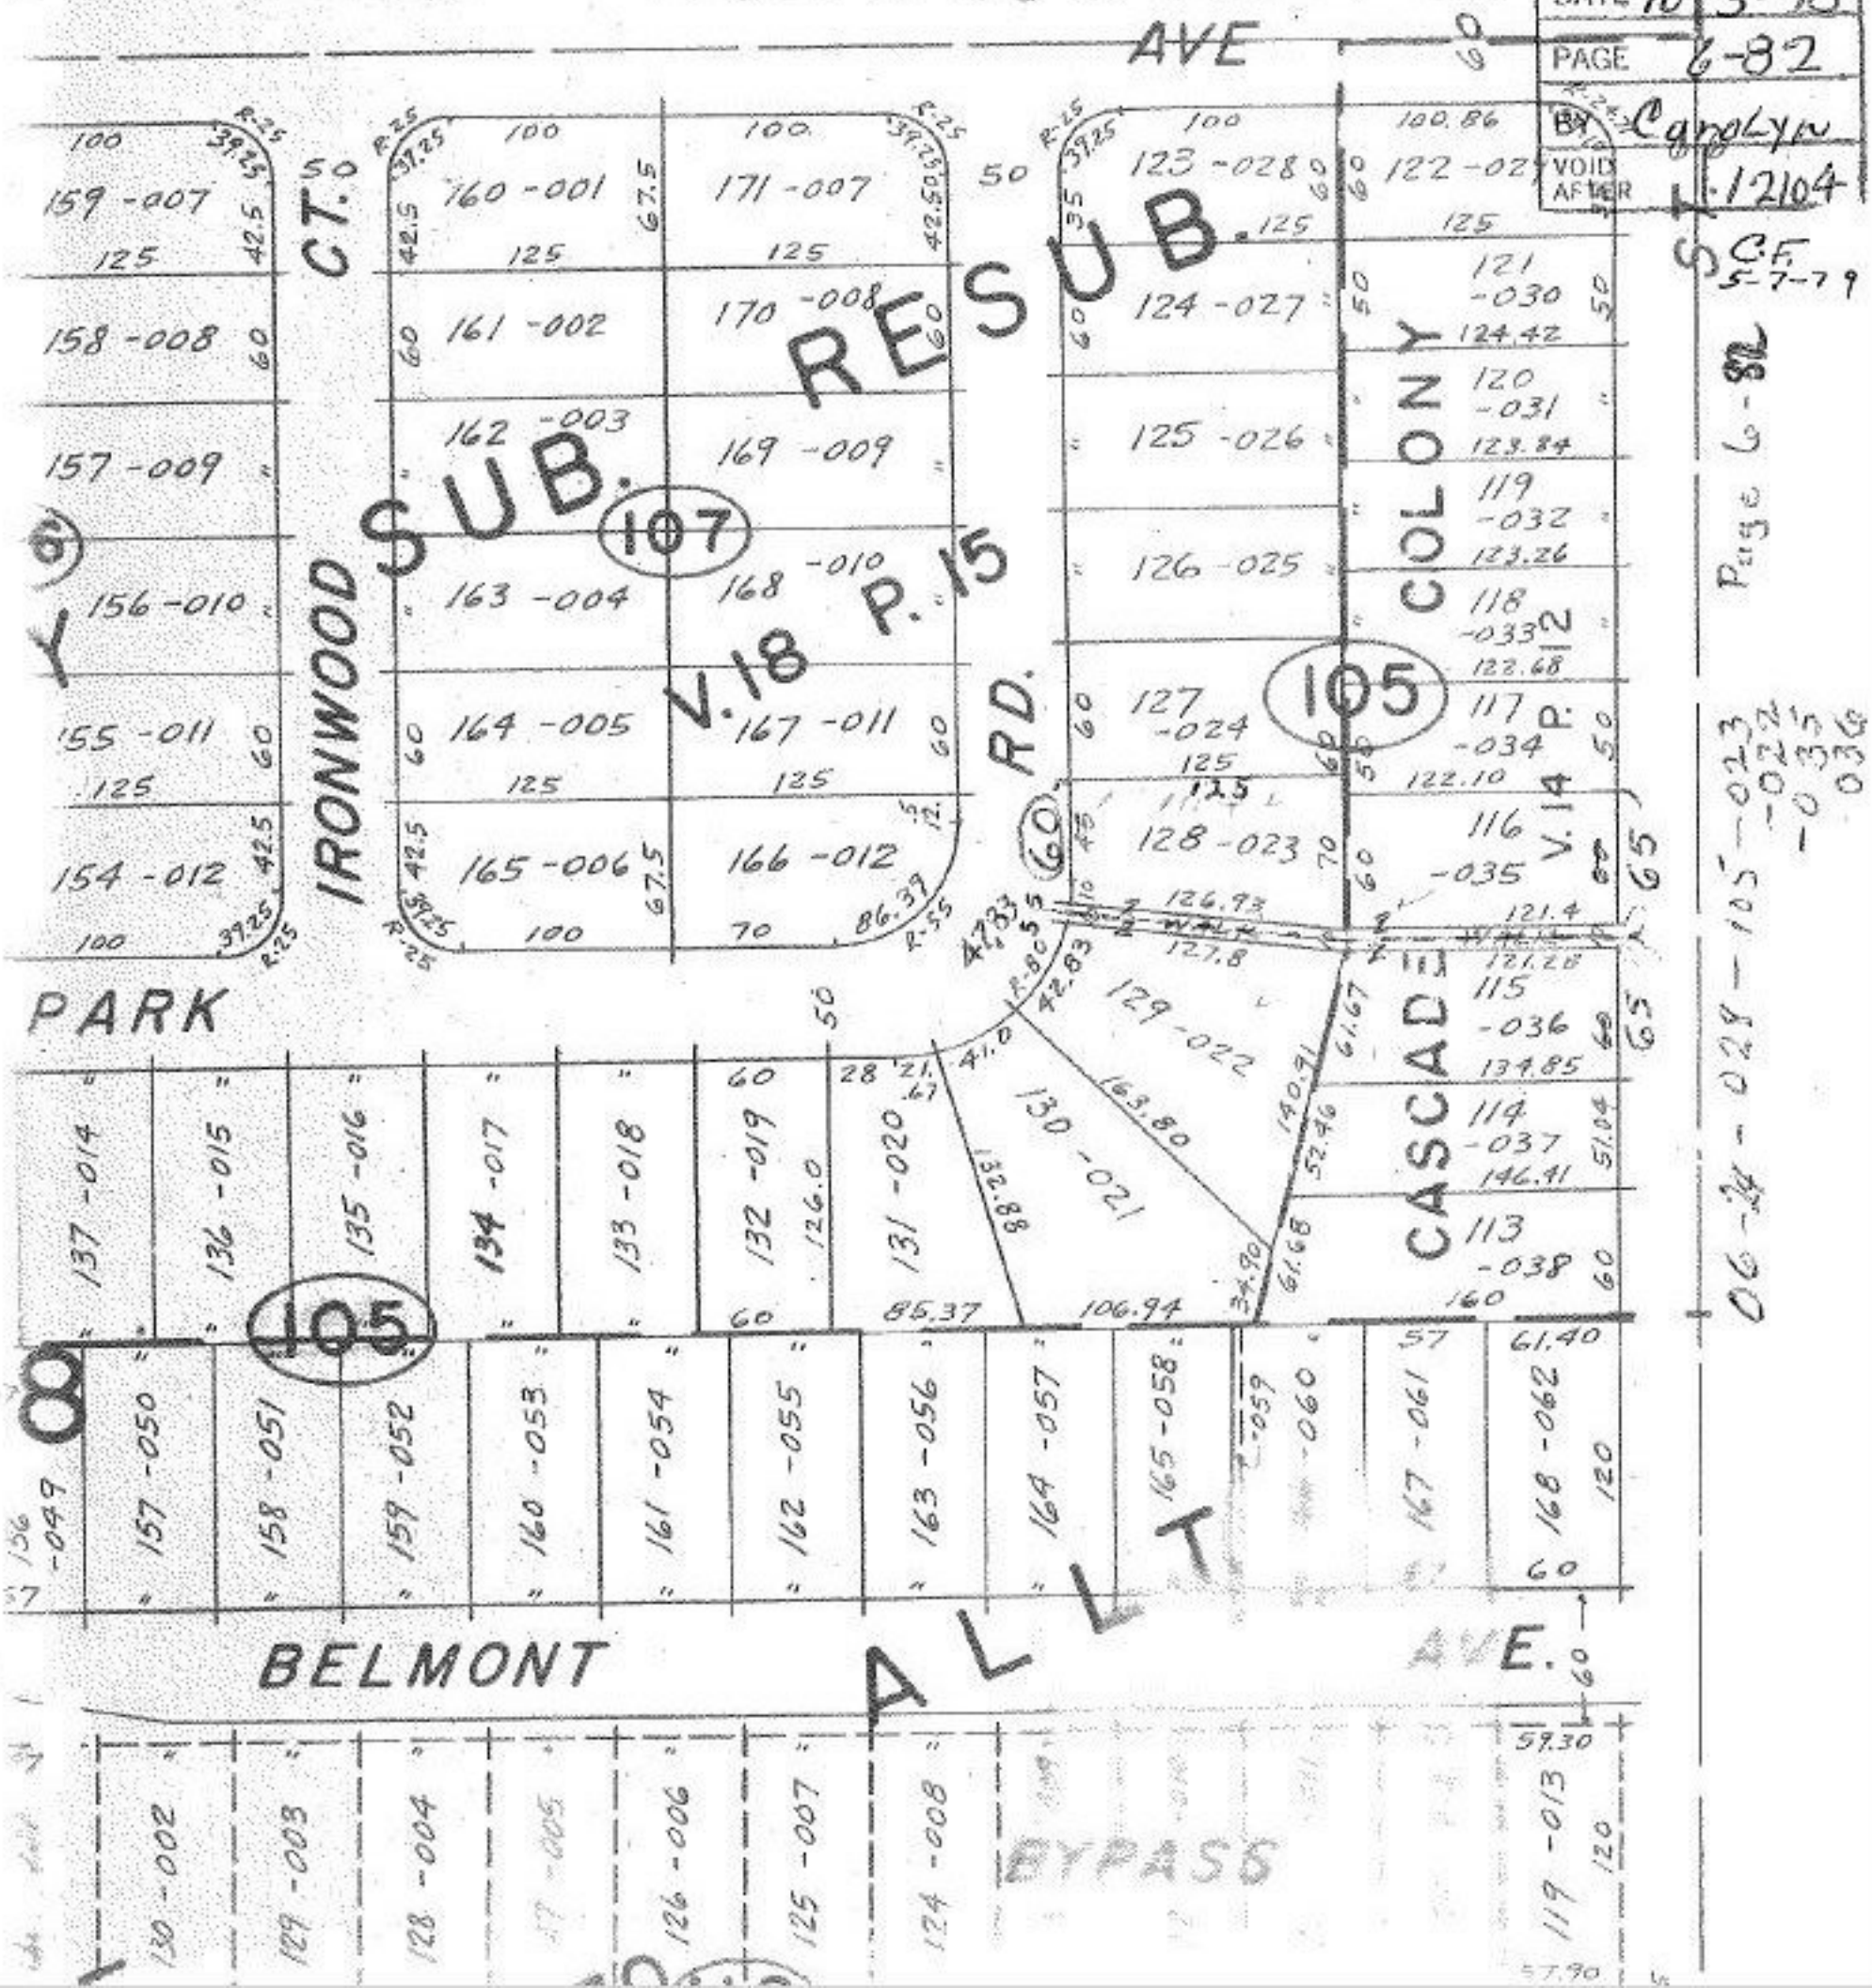
C.F. 5-7-79