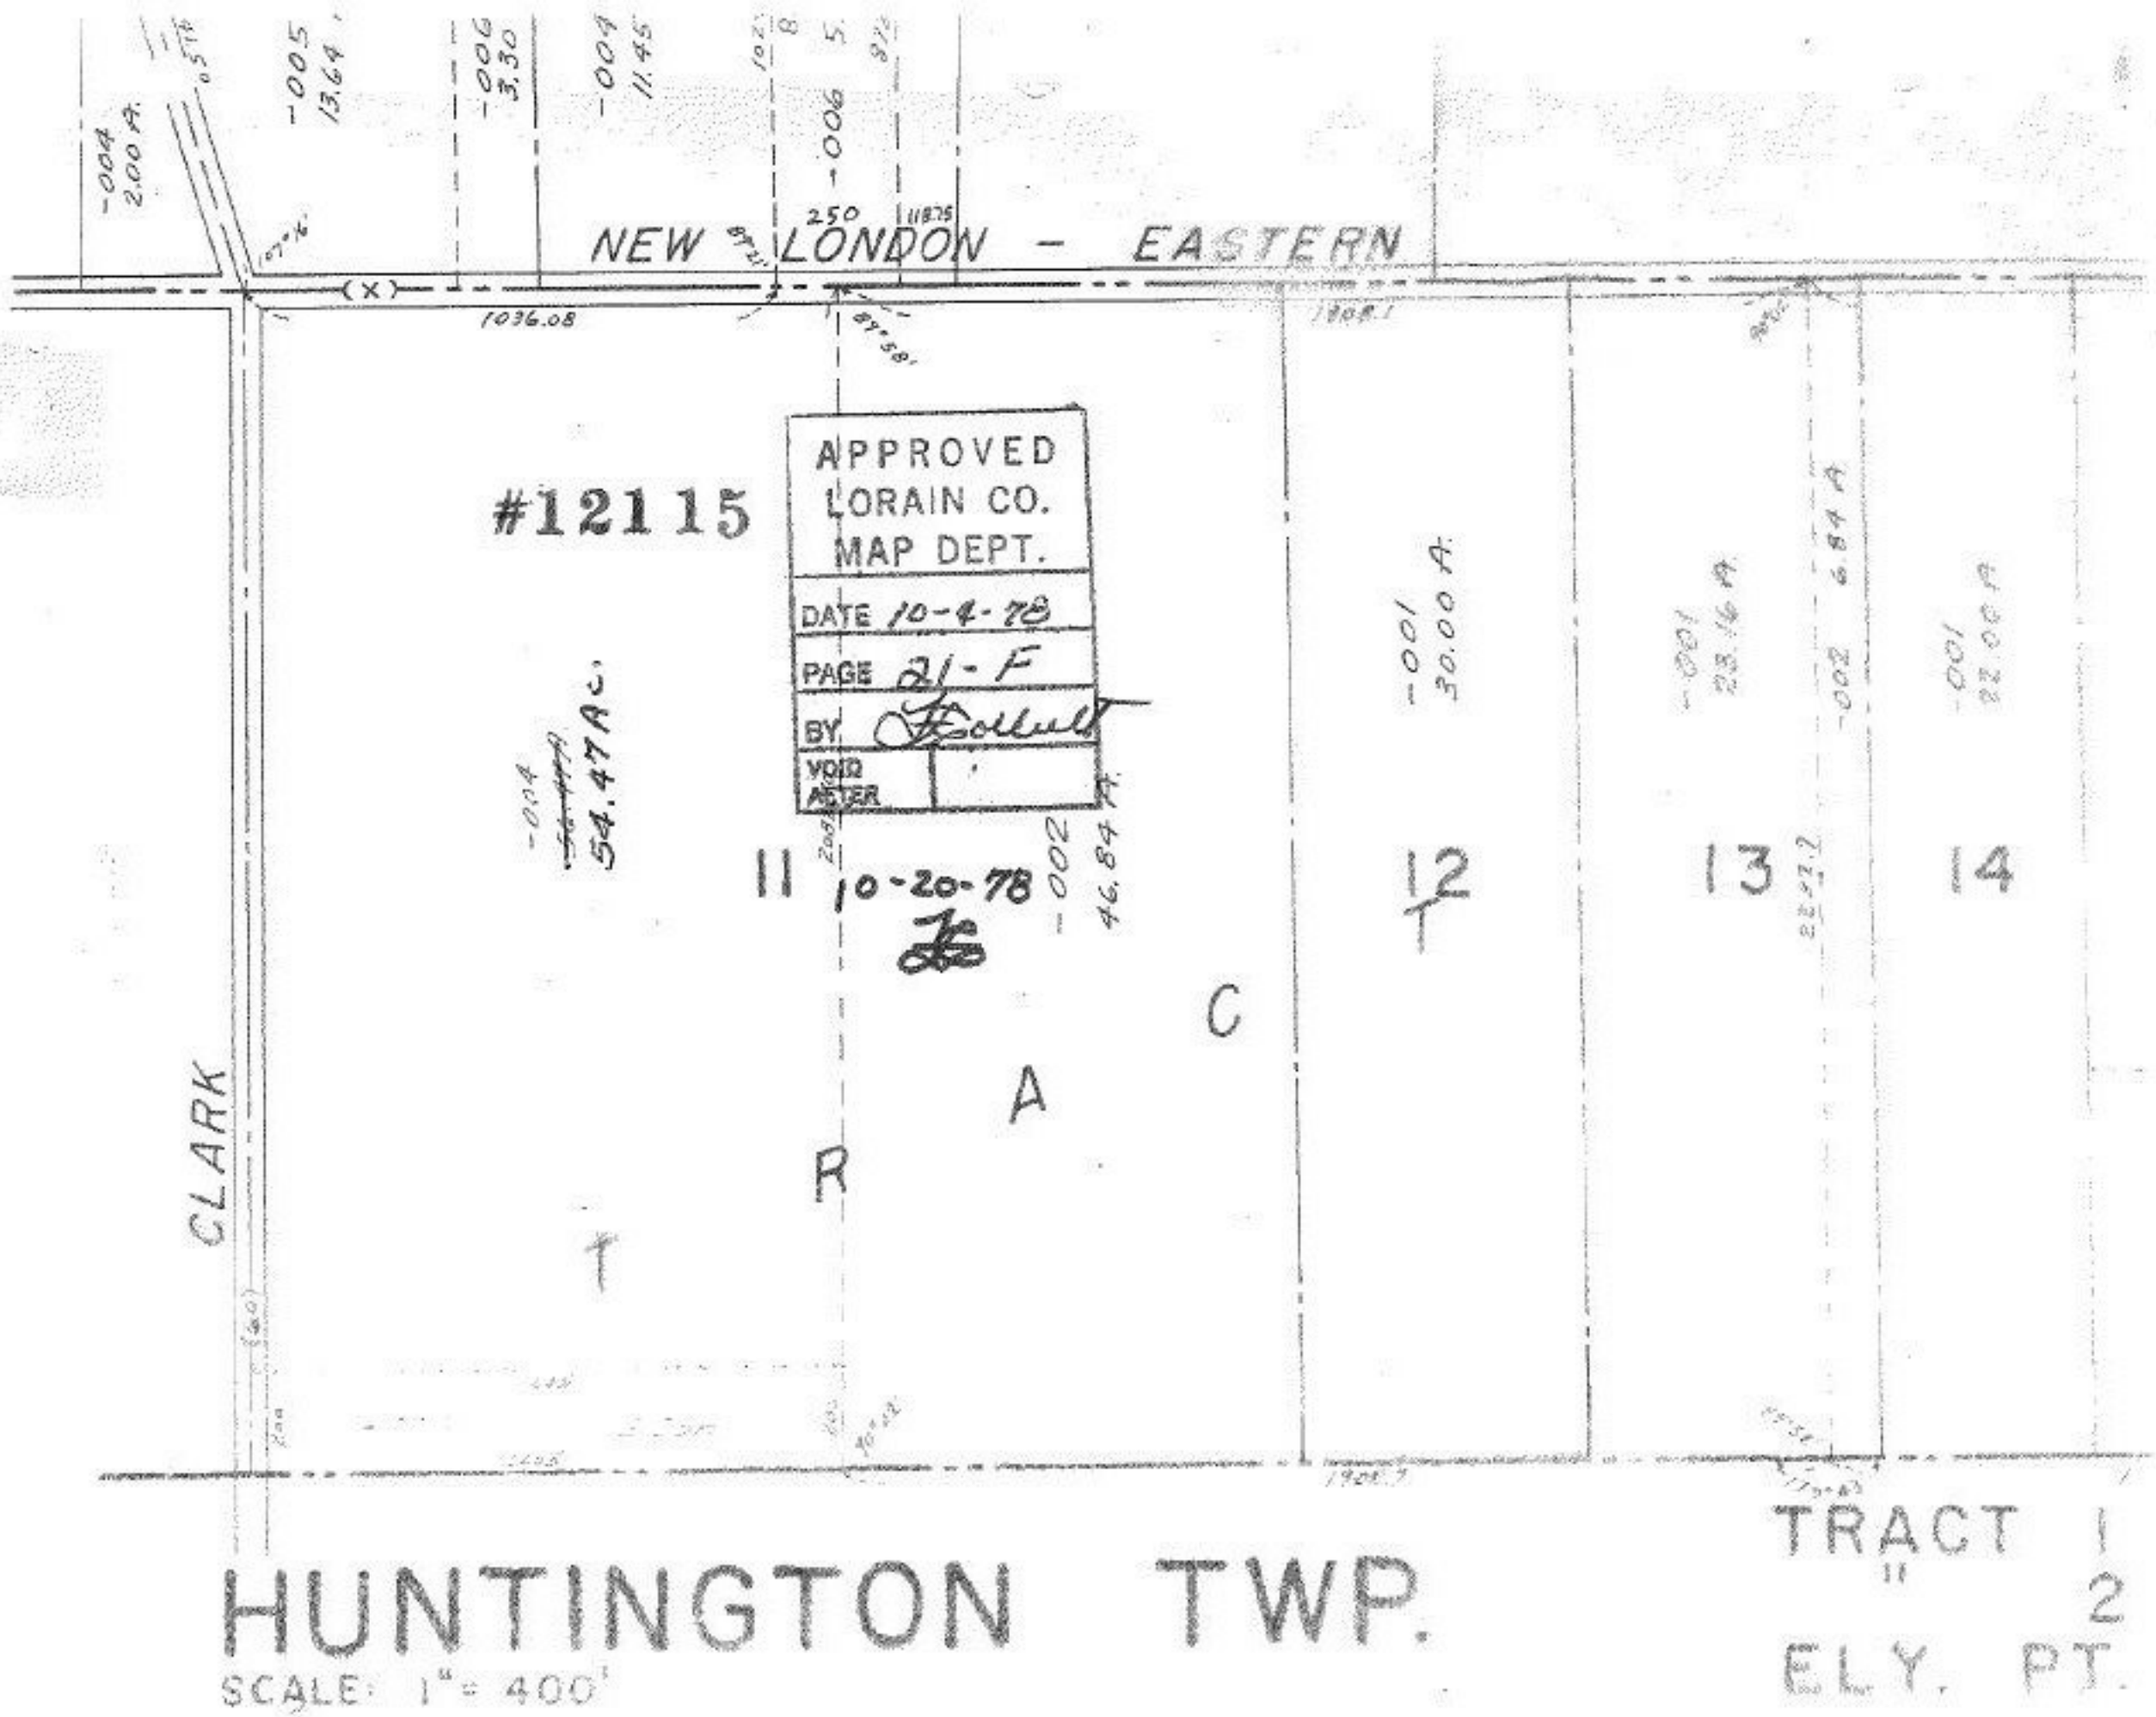

NEW LONDON - EASTERN
CLARK
#12115
APPROVED
LORAIN CO.
MAP DEPT.
DATE 10-4-78
PAGE 21-F
BY
VOID AFTER
-004 2.00 A.
-005 13.64
-006 3.30
-004 11.45
-006
250
1036.08
-004 54.47 Ac.
-002 46.84 A.
-001 30.00 A.
-001 23.16 A.
-002 6.84 A.
-001 22.00 A.
11
10-20-78
12
13
14
T R A C T
TRACT 1
" 2
ELY. PT.
HUNTINGTON TWP.
SCALE: 1" = 400'