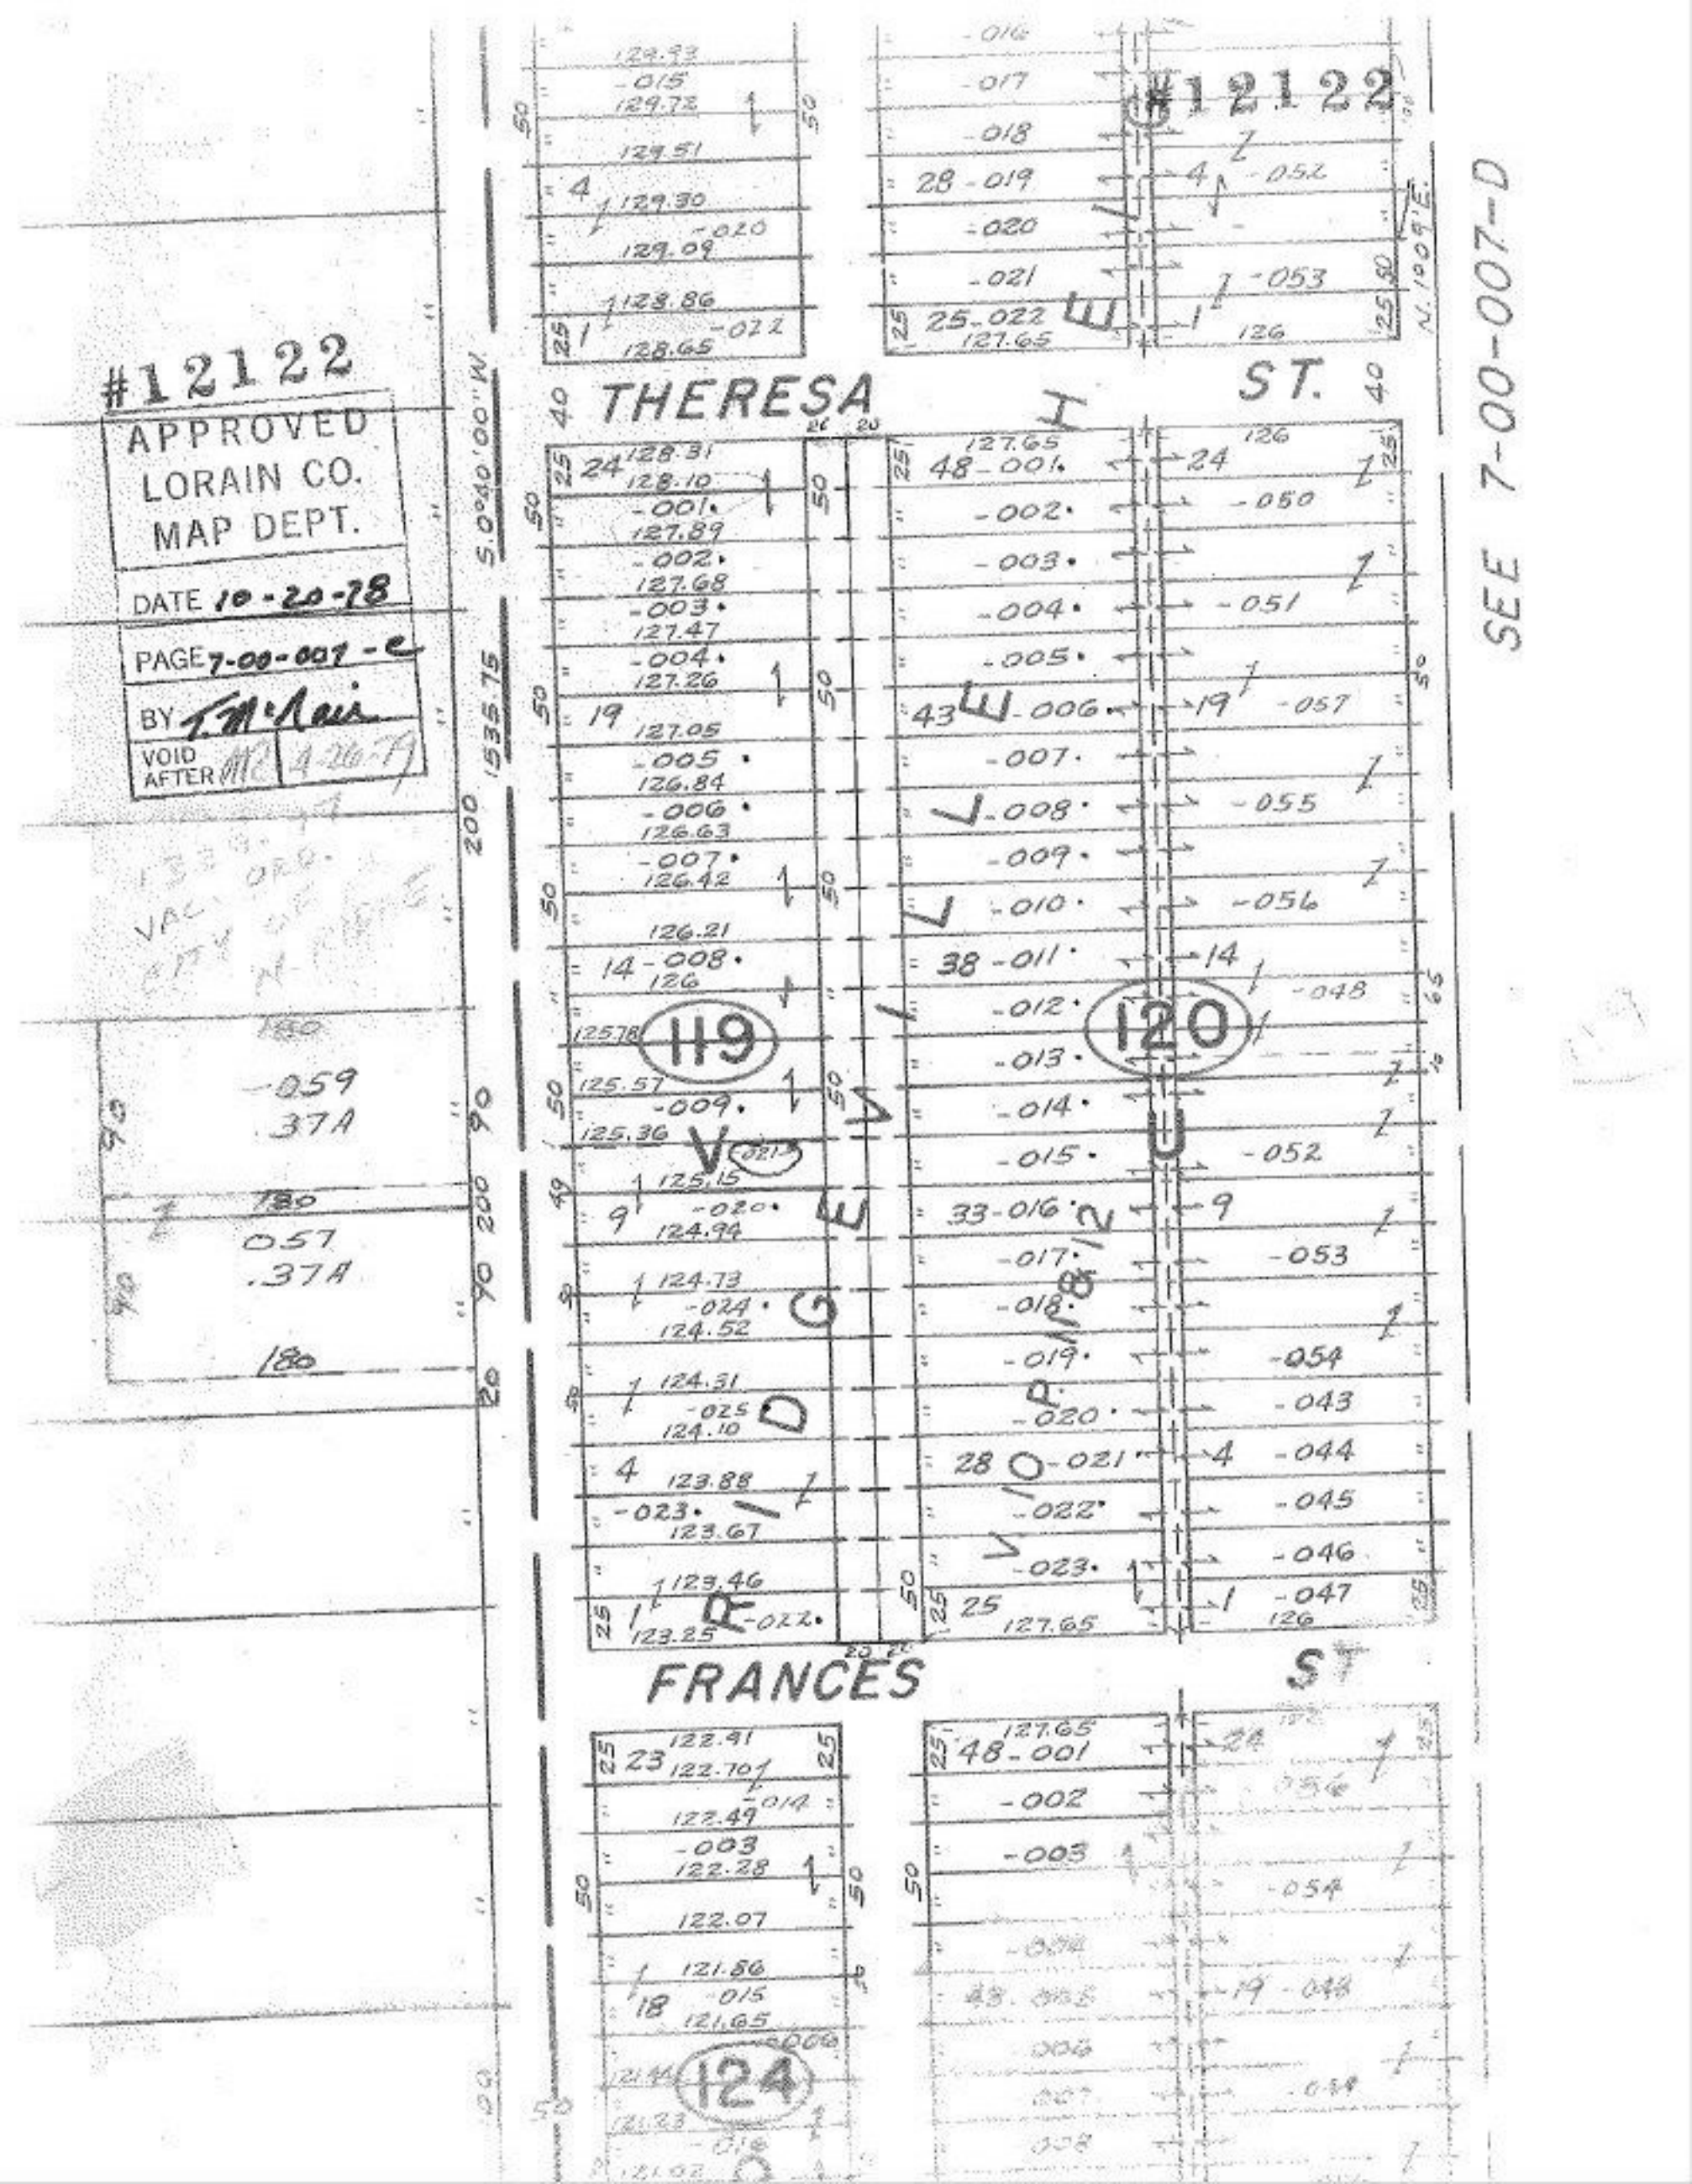
#12122
APPROVED
LORAIN CO.
MAP DEPT.
DATE 10-20-78
PAGE 7-00-007-C
BY T. McNair
VOID AFTER
#12122
THERESA ST.
FRANCES ST
SEE 7-00-007-D
119
120
124
S.0°40'00"W.
1535.75
N.1°09'E.