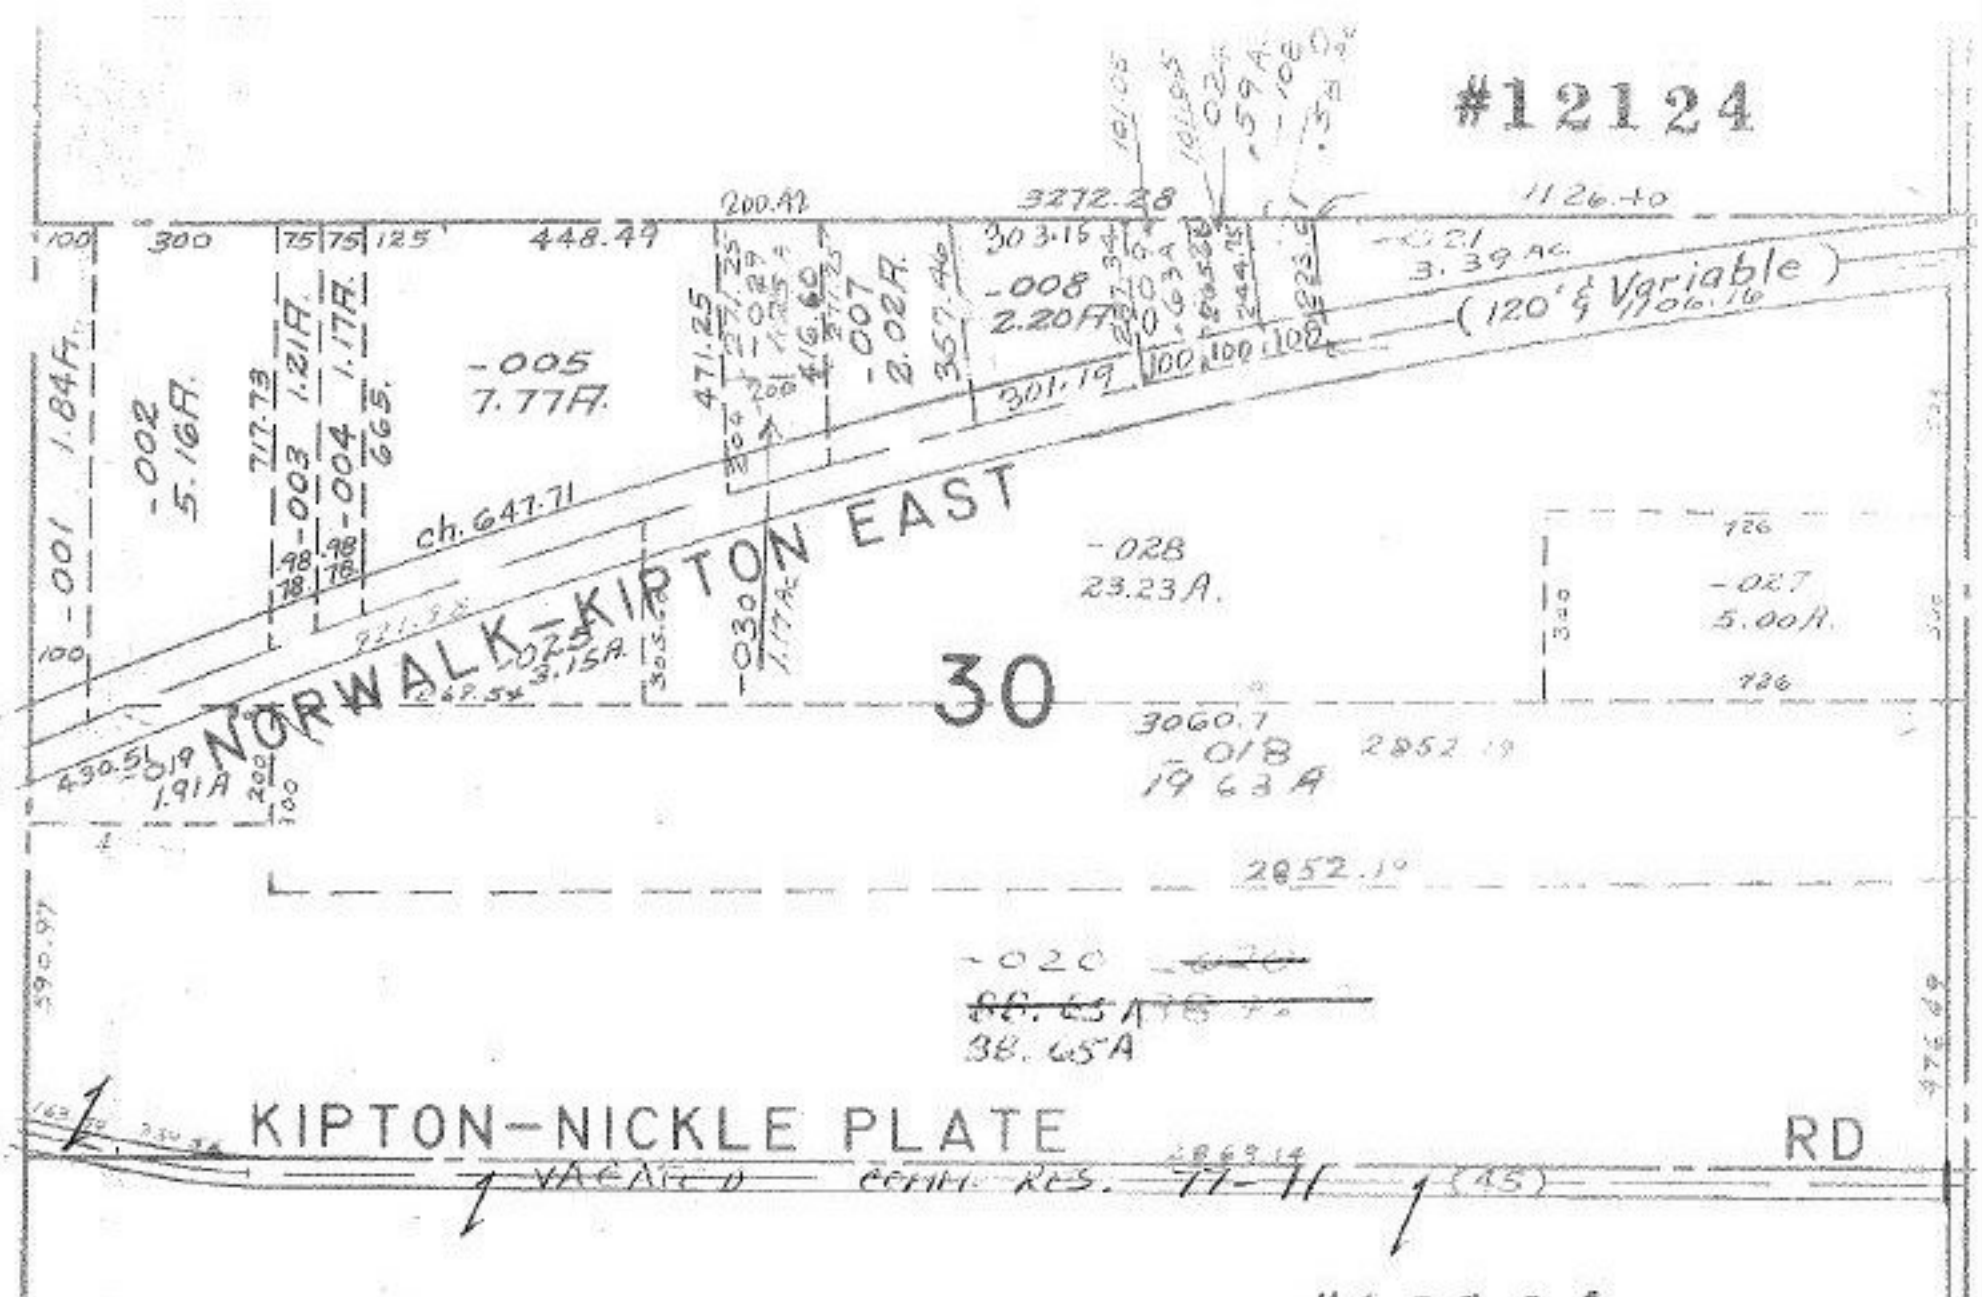

#12124

APPROVED
LORAIN CO.
MAP DEPT.

DATE 10-20-78

PAGE 13-D & 14A

BY T. McNair

VOID AFTER

TAH 1.8.85

31

-001
~~131.00A.~~
134.05 A

-001
77.00A.