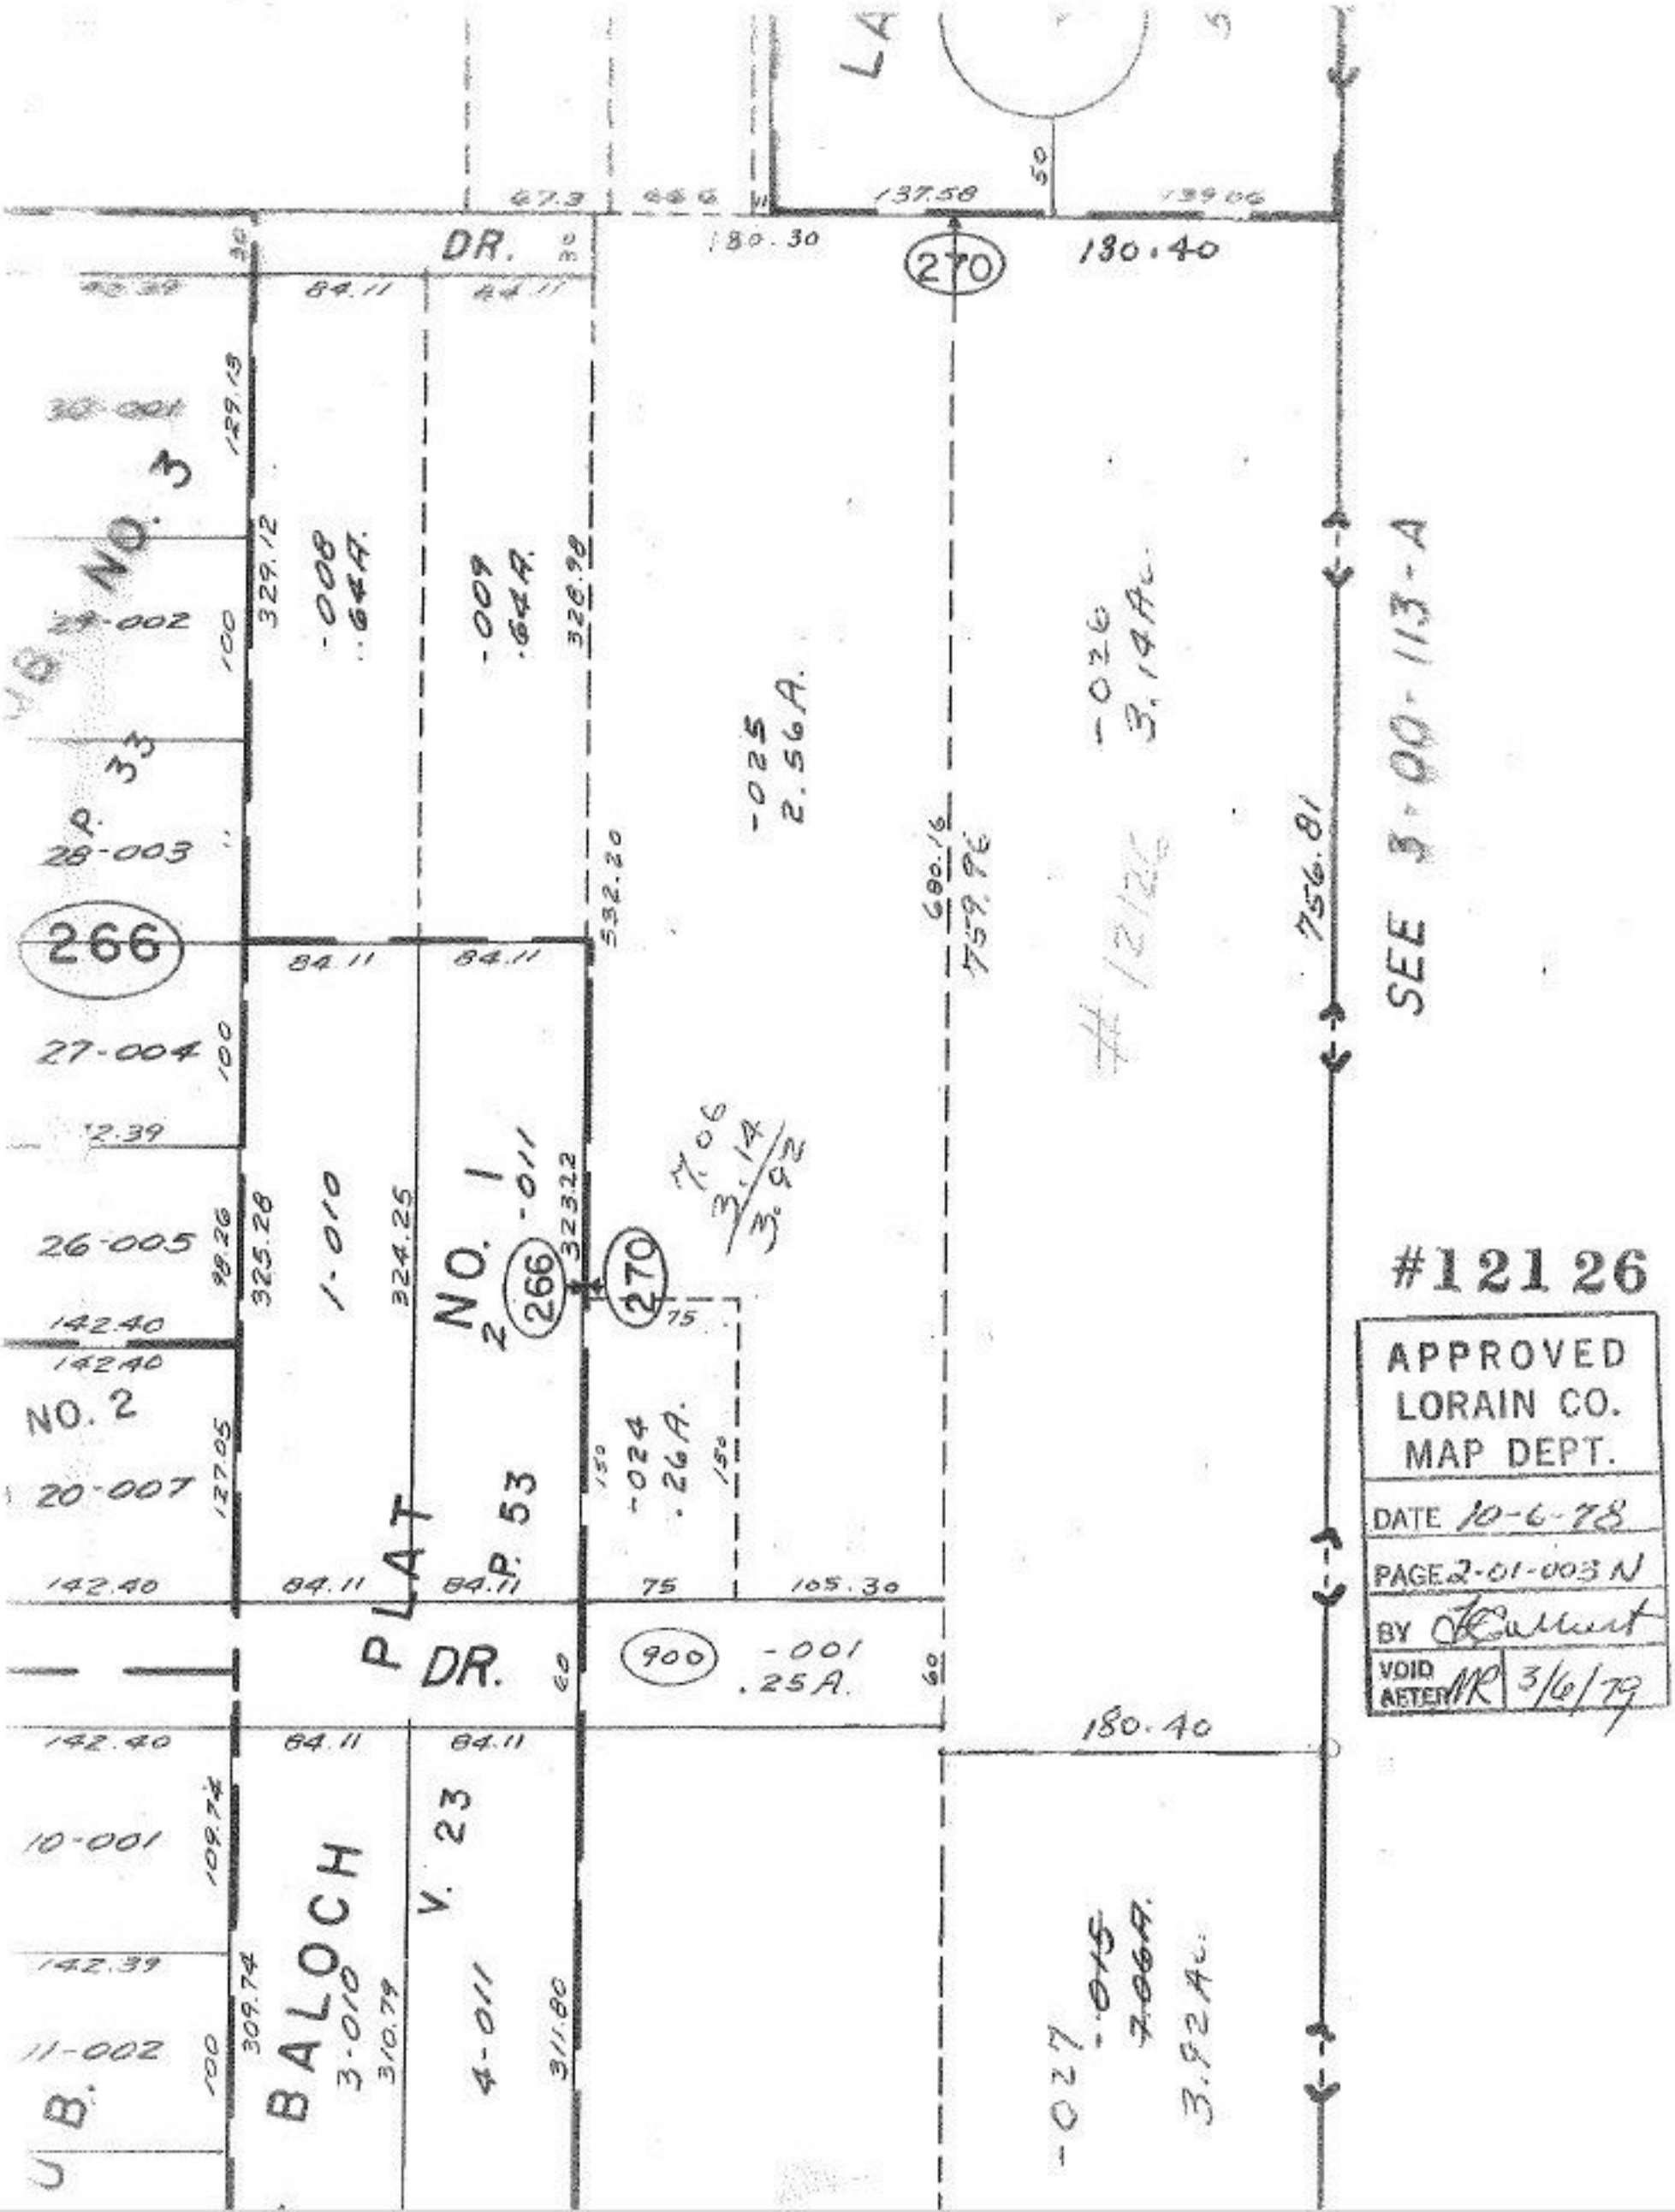

#12126

APPROVED
LORAIN CO.
MAP DEPT.

DATE 10-6-78

PAGE 2-01-003 N

BY [signature]

VOID AFTER MR 3/6/79