#12133

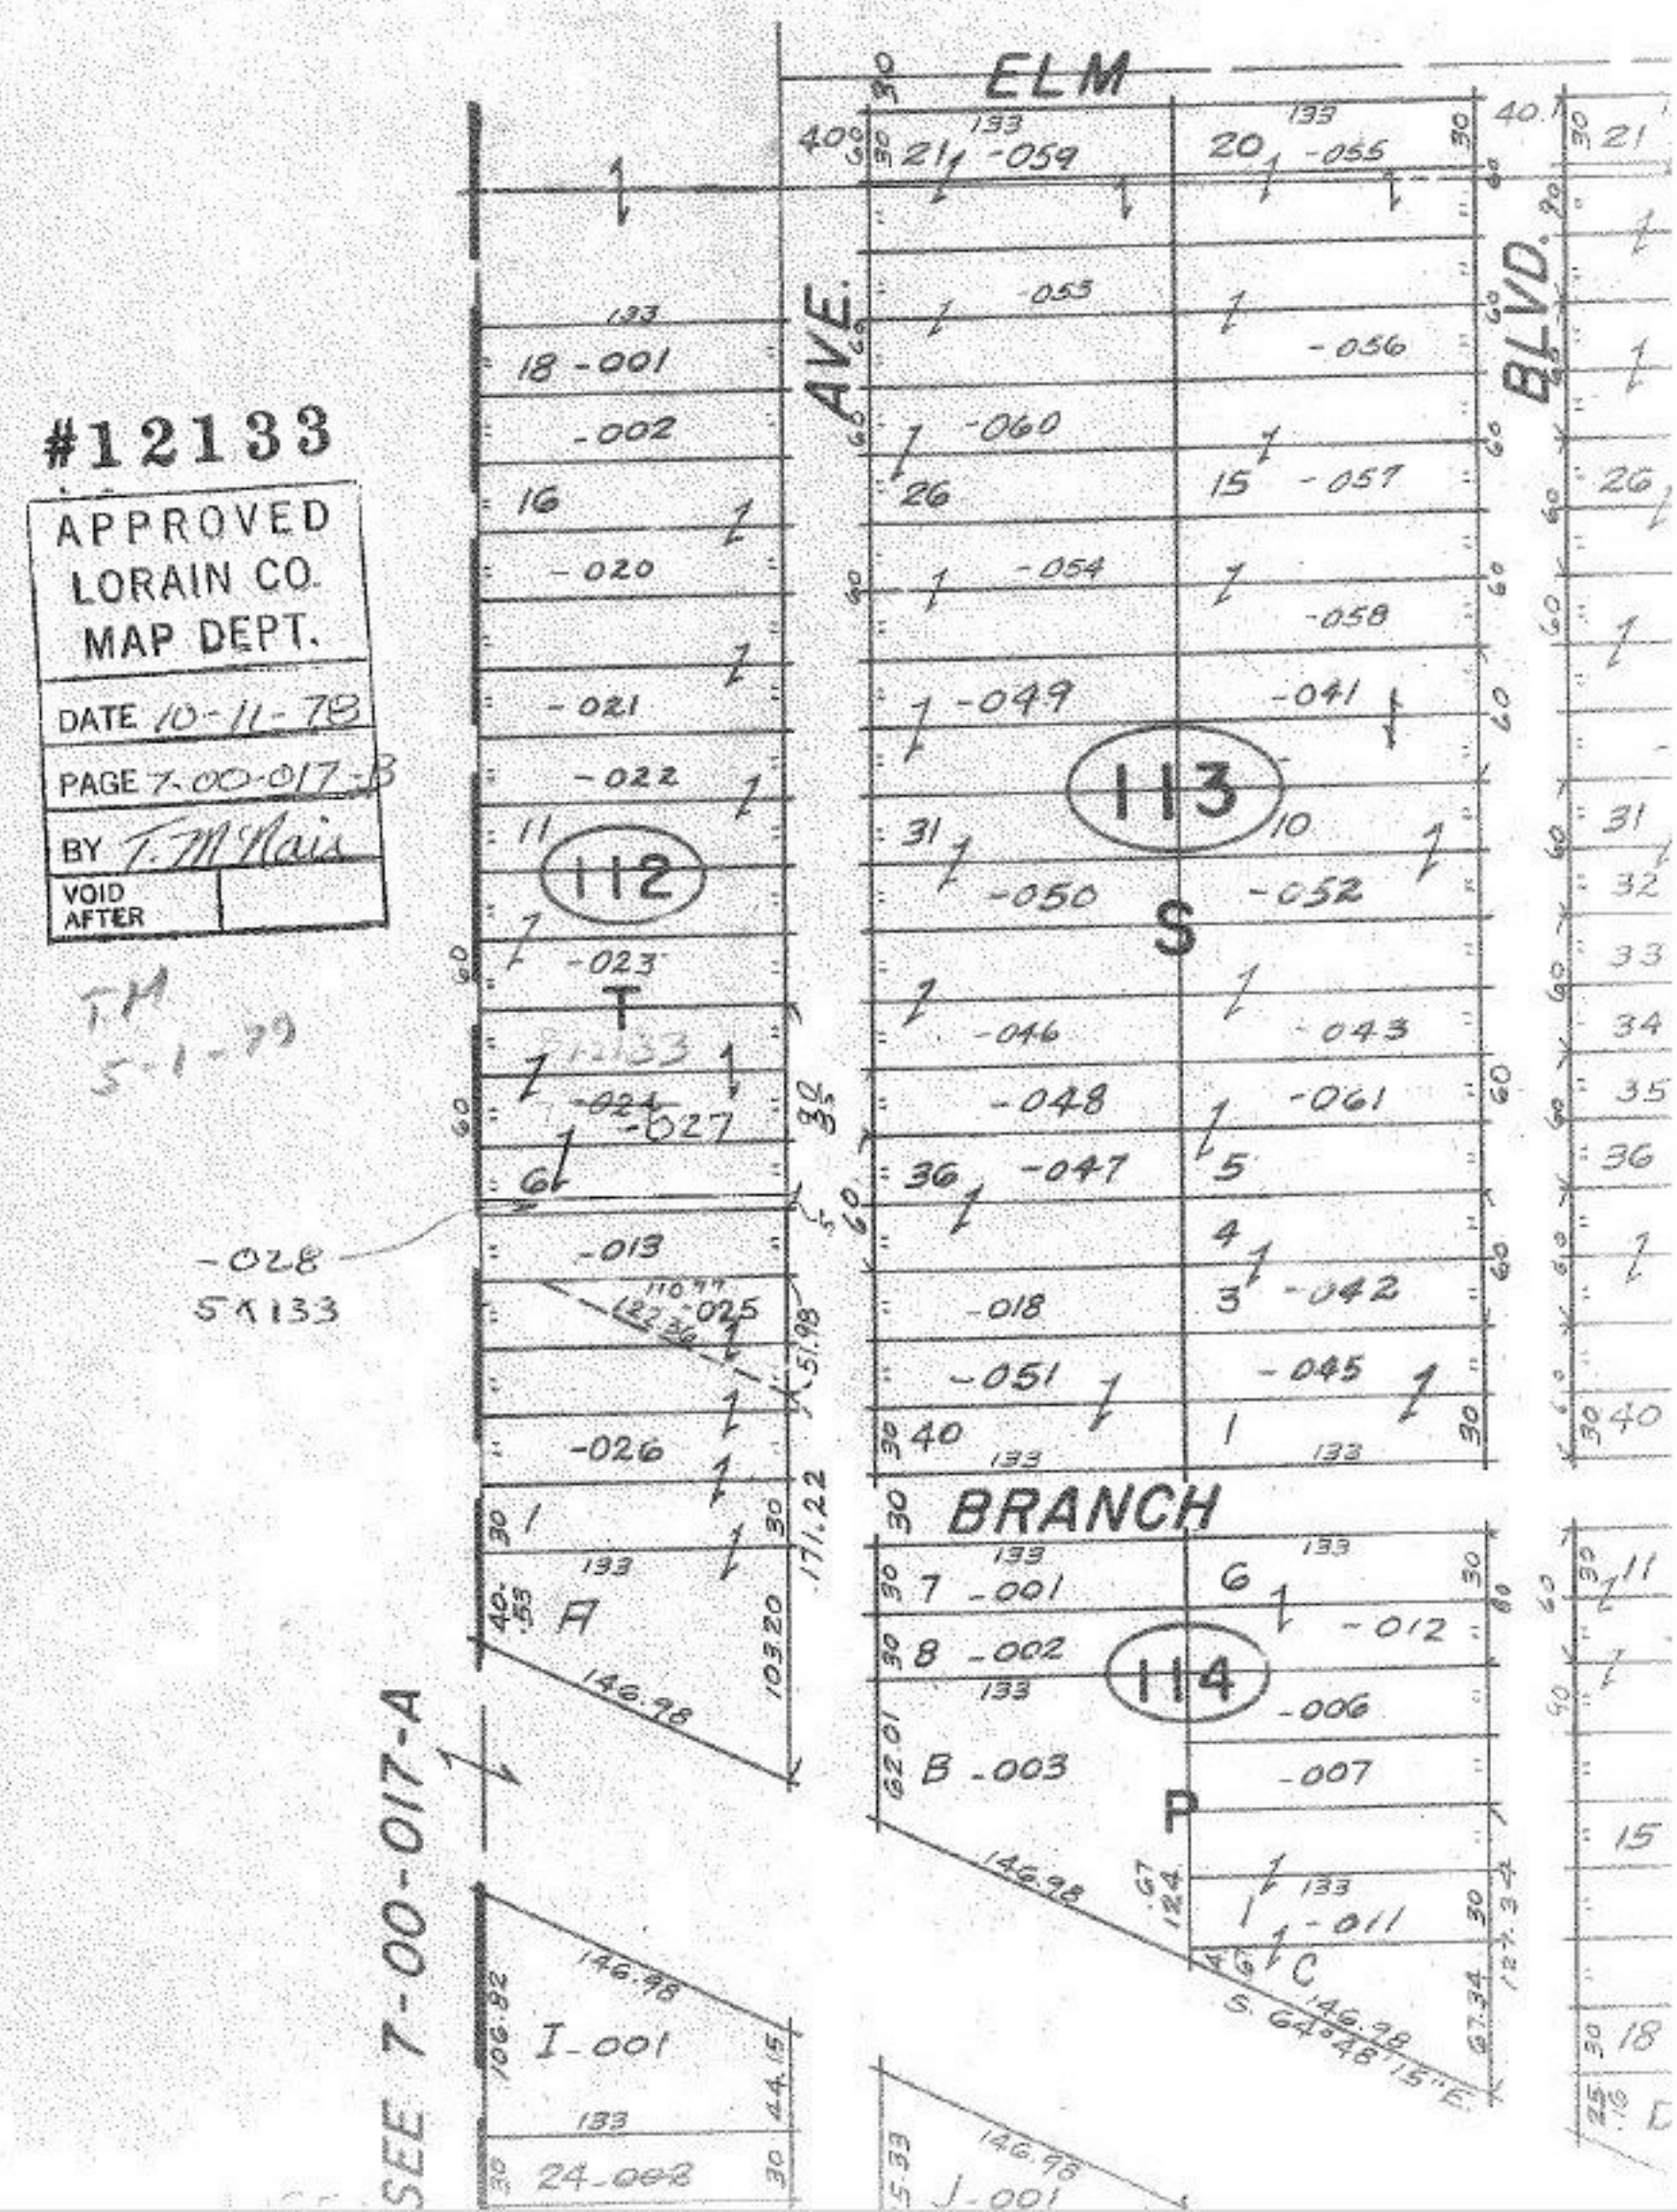

#12133
APPROVED
LORAIN CO.
MAP DEPT.
DATE 10-11-78
PAGE 7-00-017-B
BY T. McNair
VOID AFTER
T.M.
5-1-79
ELM
AVE.
BLVD.
BRANCH
112
113
114
T
S
P
A
B
C
I-001
J-001
24-002
-028
5X133
SEE 7-00-017-A