MAY 7 1979

#12139

APPROVED
LORAIN CO.
MAP DEPT.

DATE 10-12-78

PAGE 6-105

BY T. McNair
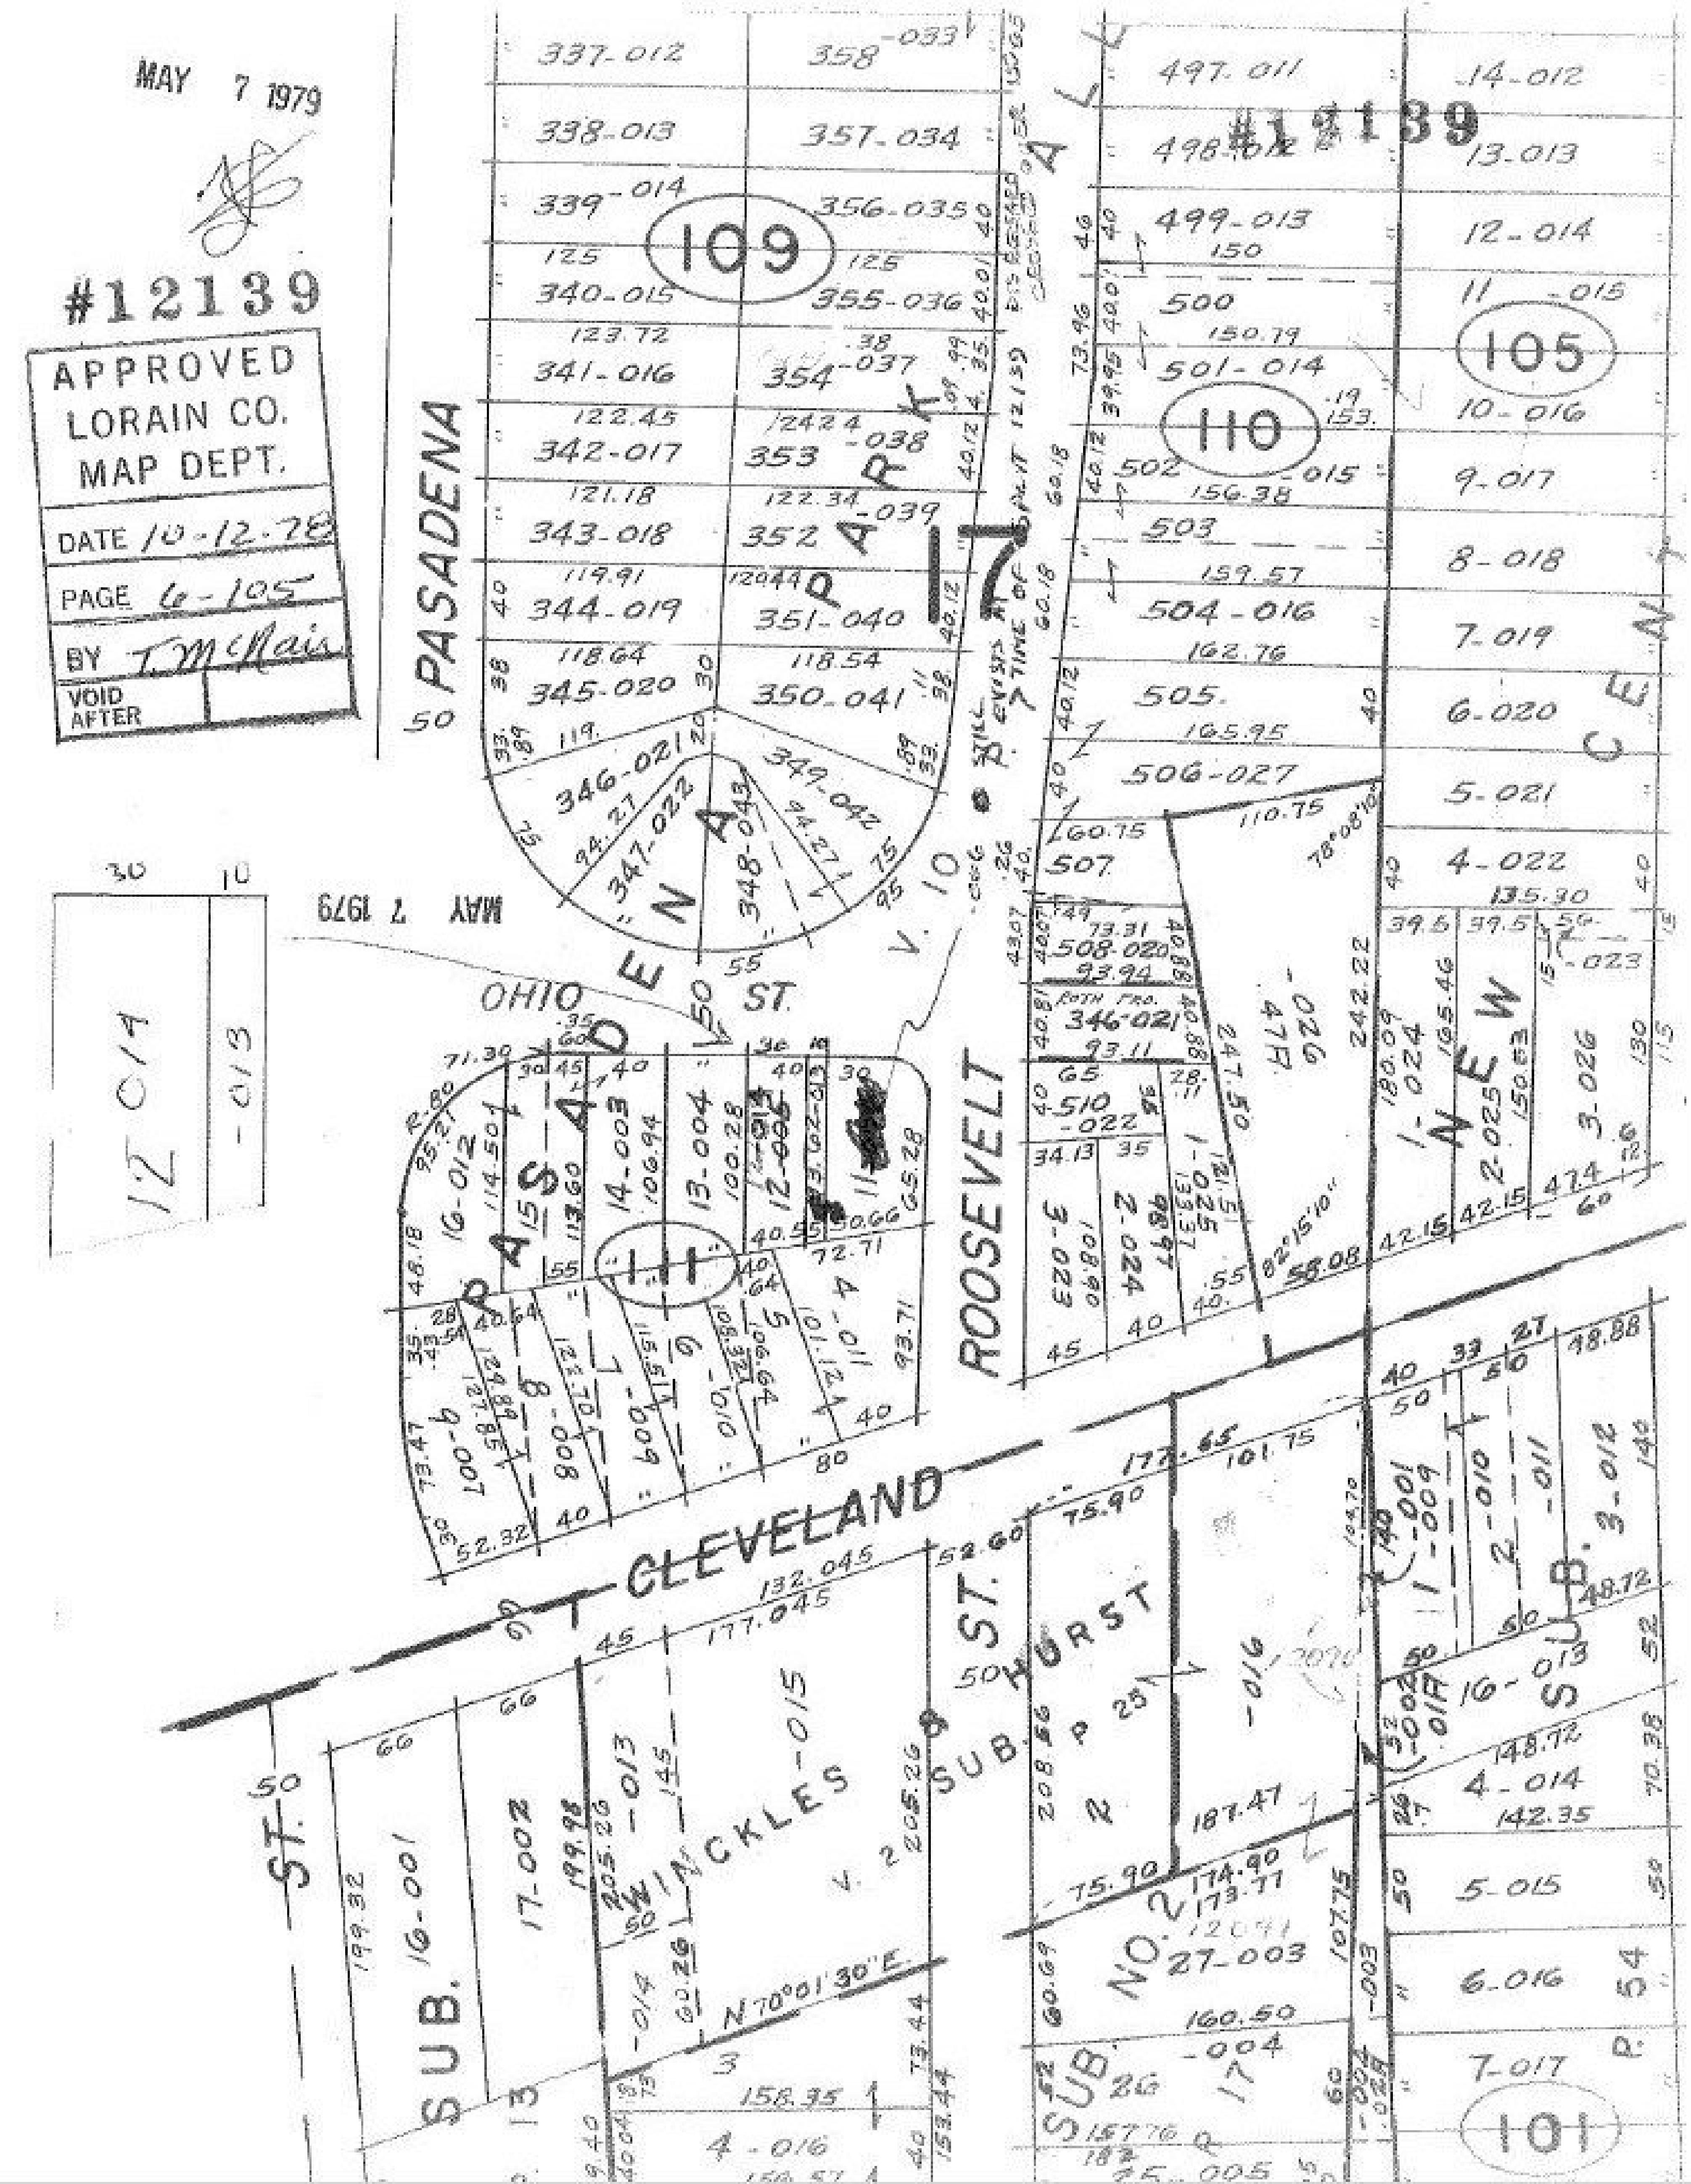
VOID AFTER