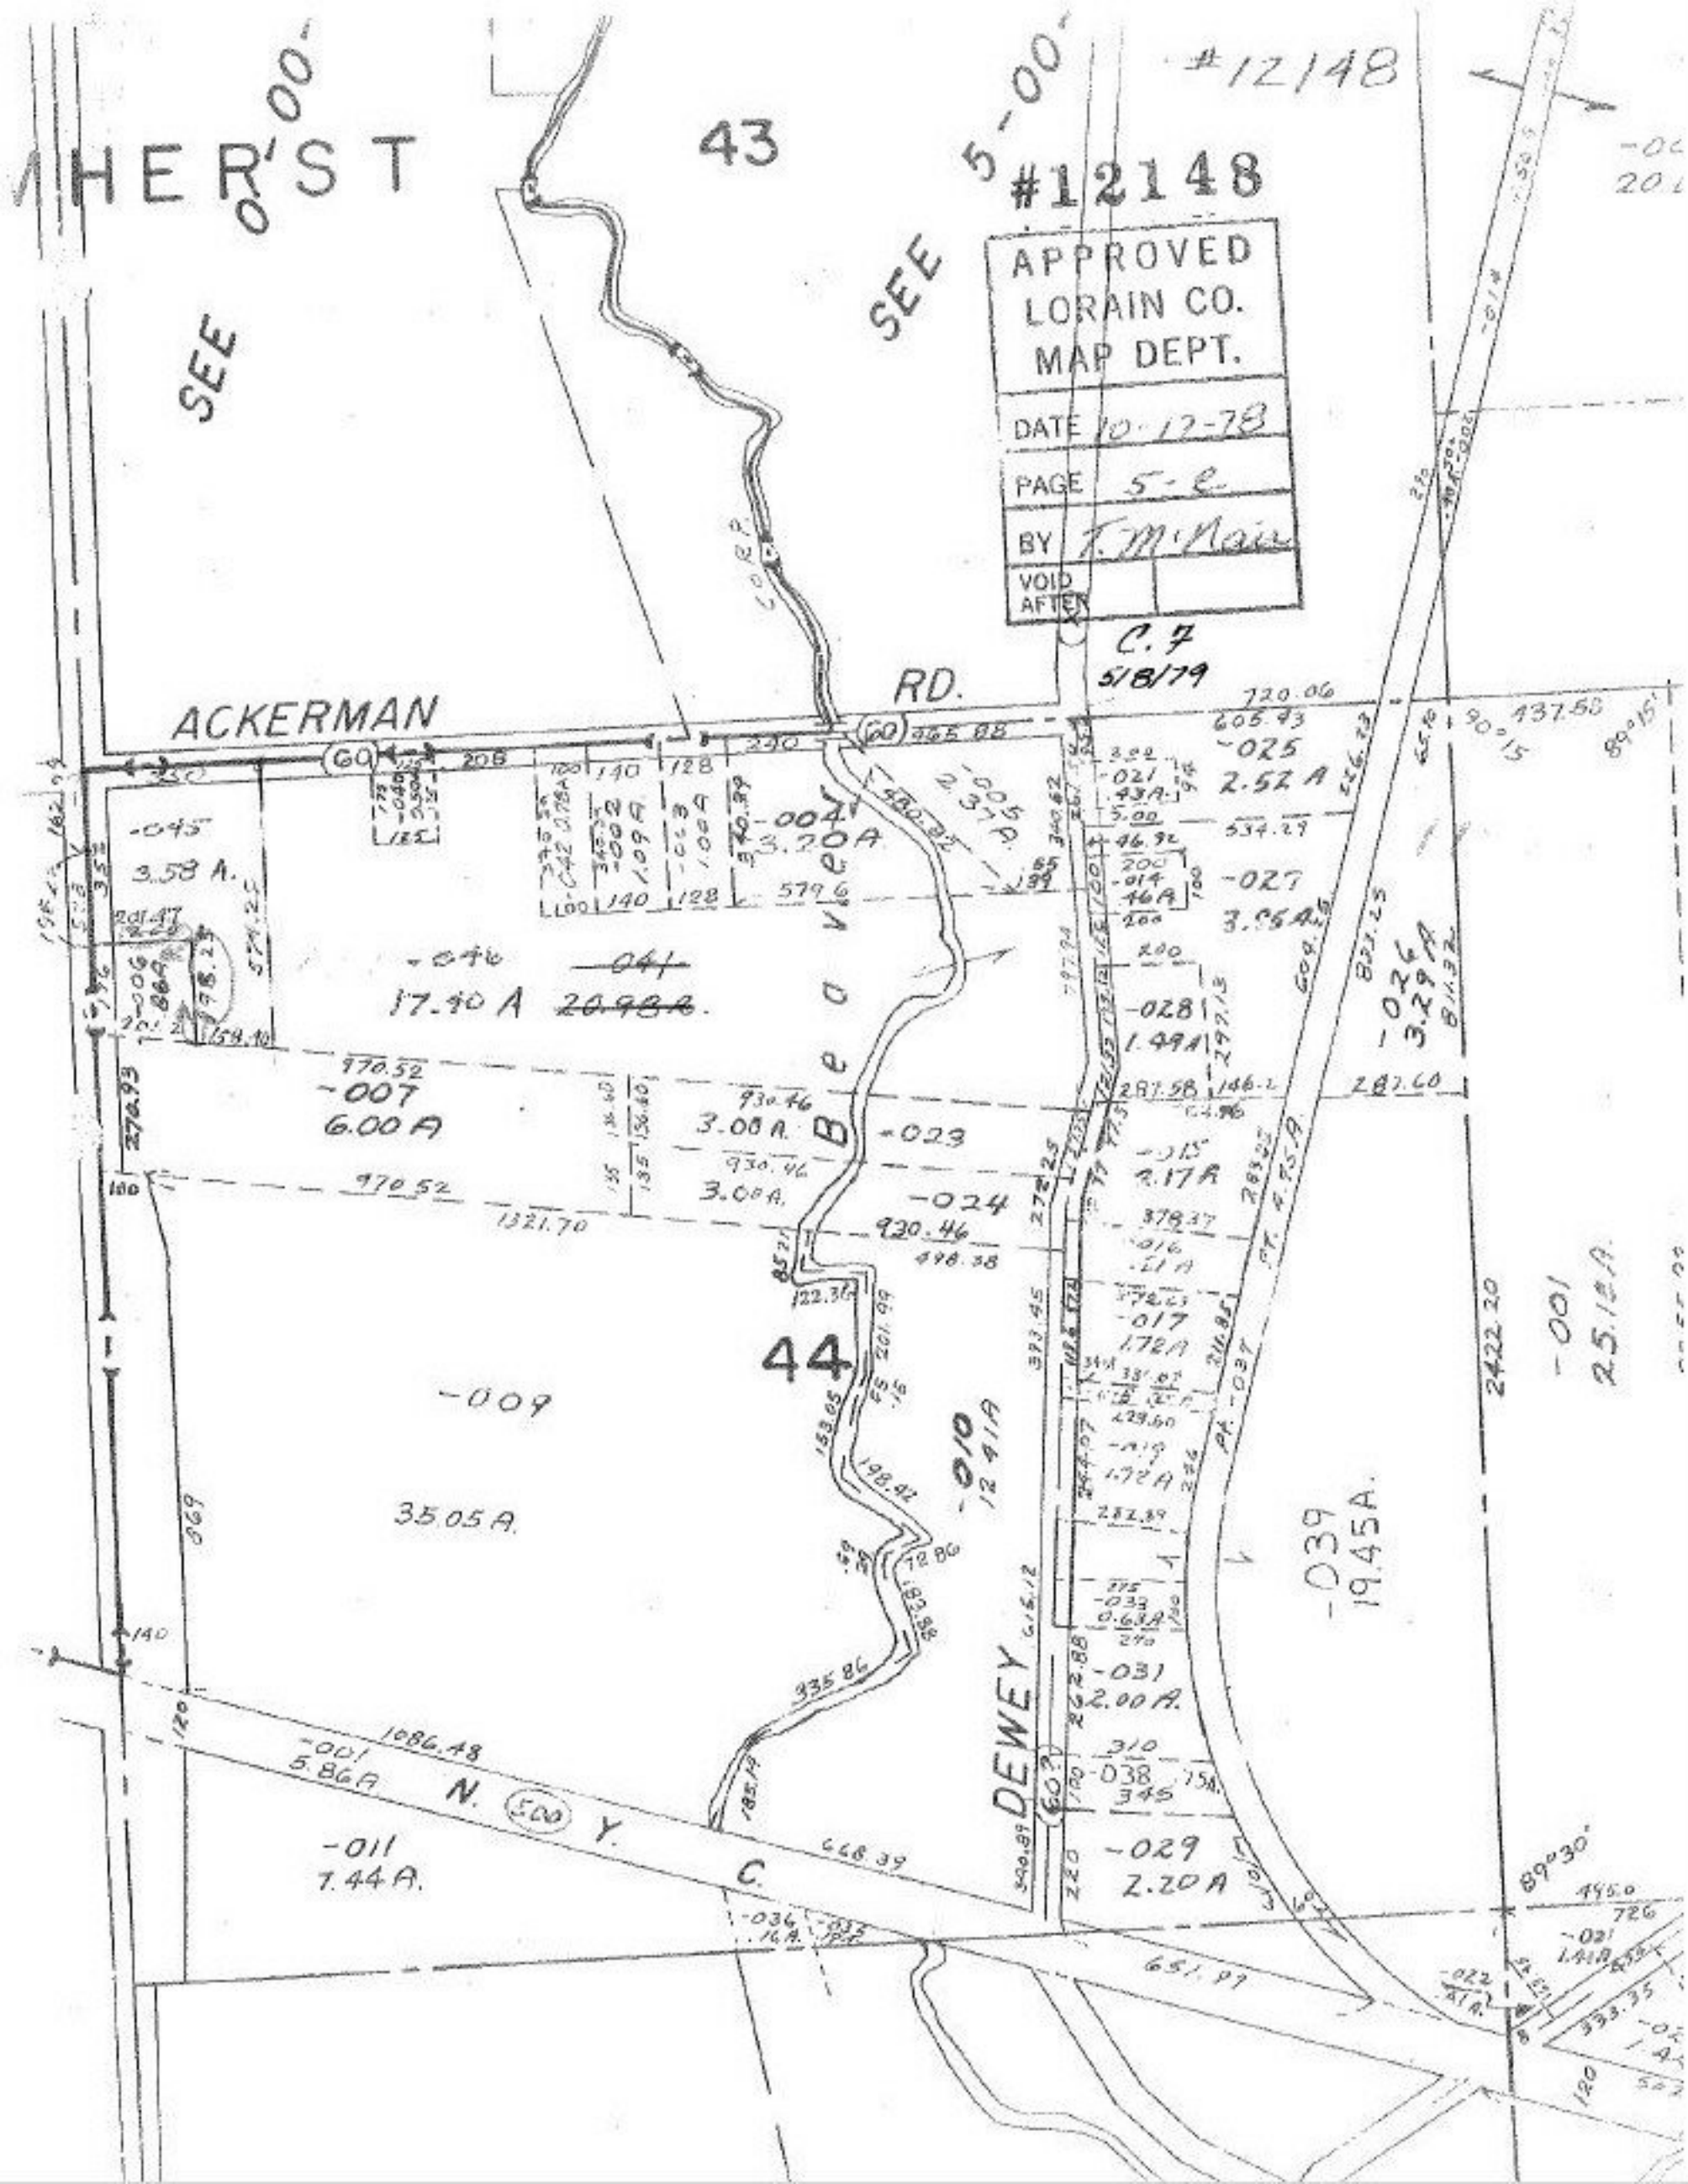

#12148
#12148
APPROVED
LORAIN CO.
MAP DEPT.
DATE 10-17-78
PAGE 5-e
BY T. McNair
VOID AFTER
C.7
5/8/79
SEE 0-00
SEE 5-00
43
44
ACKERMAN RD.
DEWEY
N. Y. C.
-045 3.58 A.
-046 17.40 A
-041 20.98 A.
-007 6.00 A
-004 3.20 A
-005 2.37 A
-025 2.52 A
-027 3.95 A
-028 1.49 A
-026 3.29 A
-023 3.00 A.
-024 3.00 A.
-015 2.17 A
-017 1.72 A
-009 35.05 A.
-010 12.41 A
-039 19.45 A.
-001 25.18 A.
-031 2.00 A.
-038 345
-029 2.20 A
-011 7.44 A.
-001 5.86 A