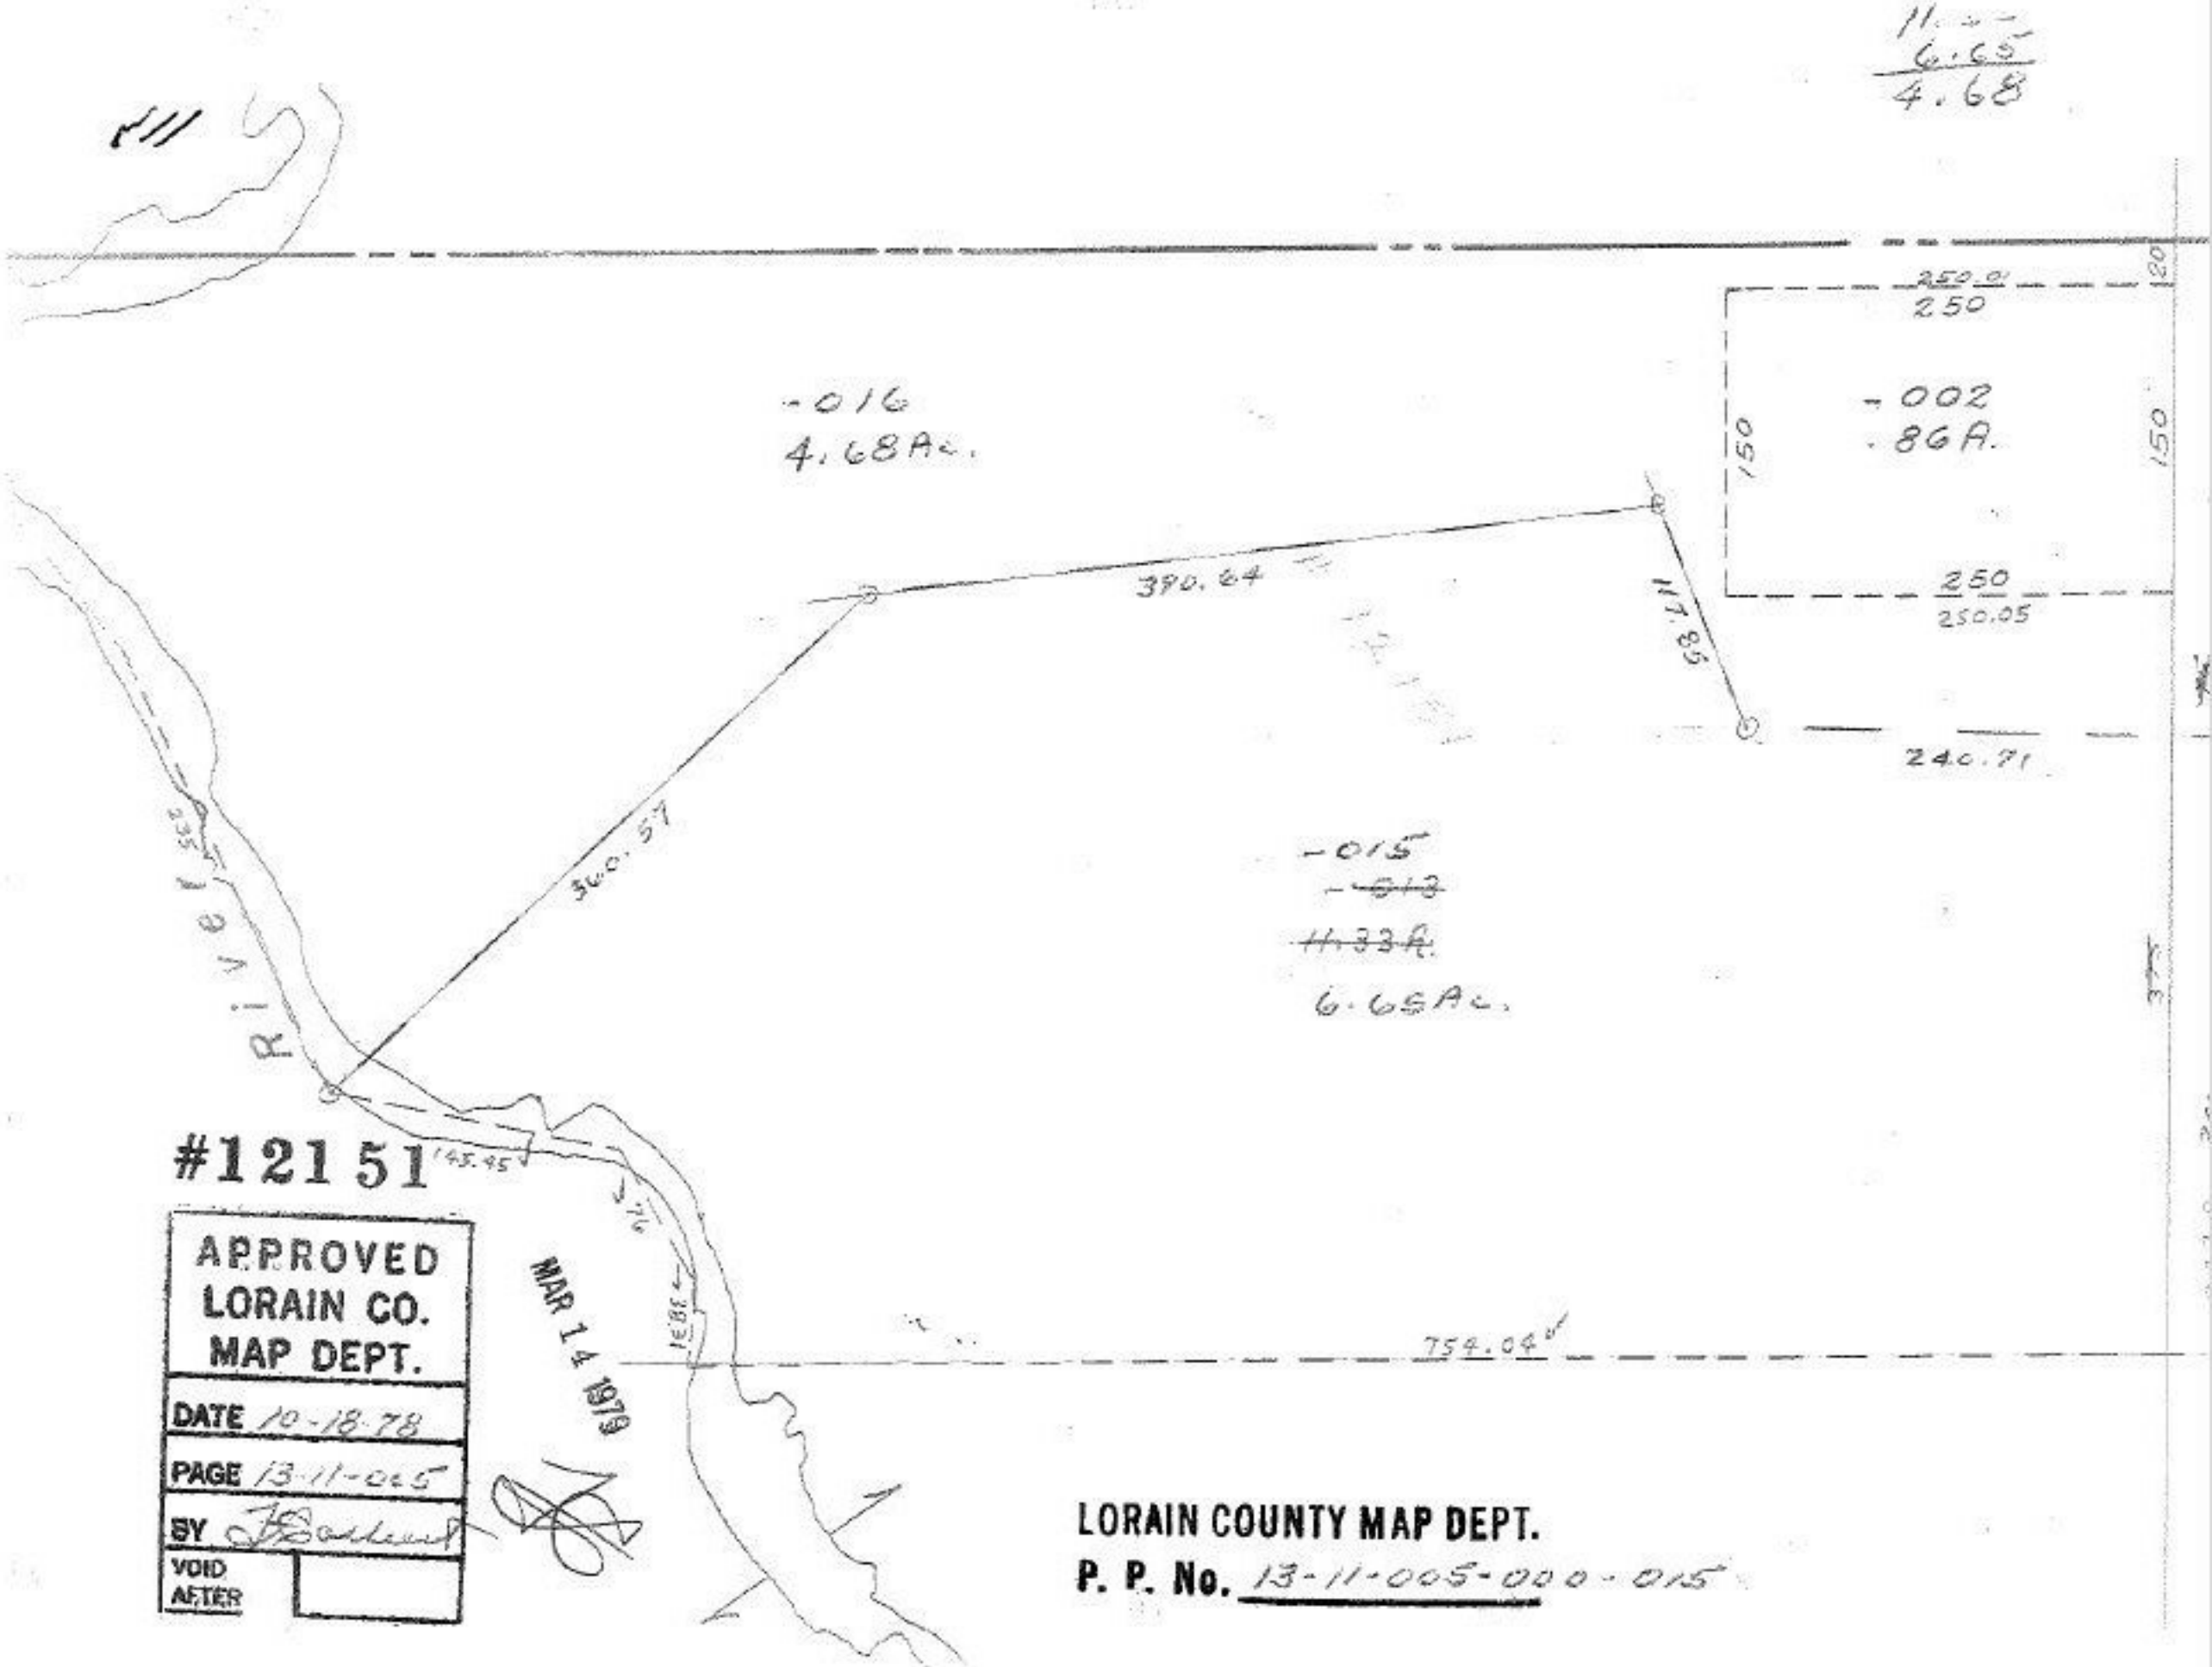

#12151

APPROVED
LORAIN CO.
MAP DEPT.

DATE 10-18-78

PAGE 13-11-005

BY [signature]

VOID AFTER

MAR 14 1979

LORAIN COUNTY MAP DEPT.

P. P. No. 13-11-005-000-015