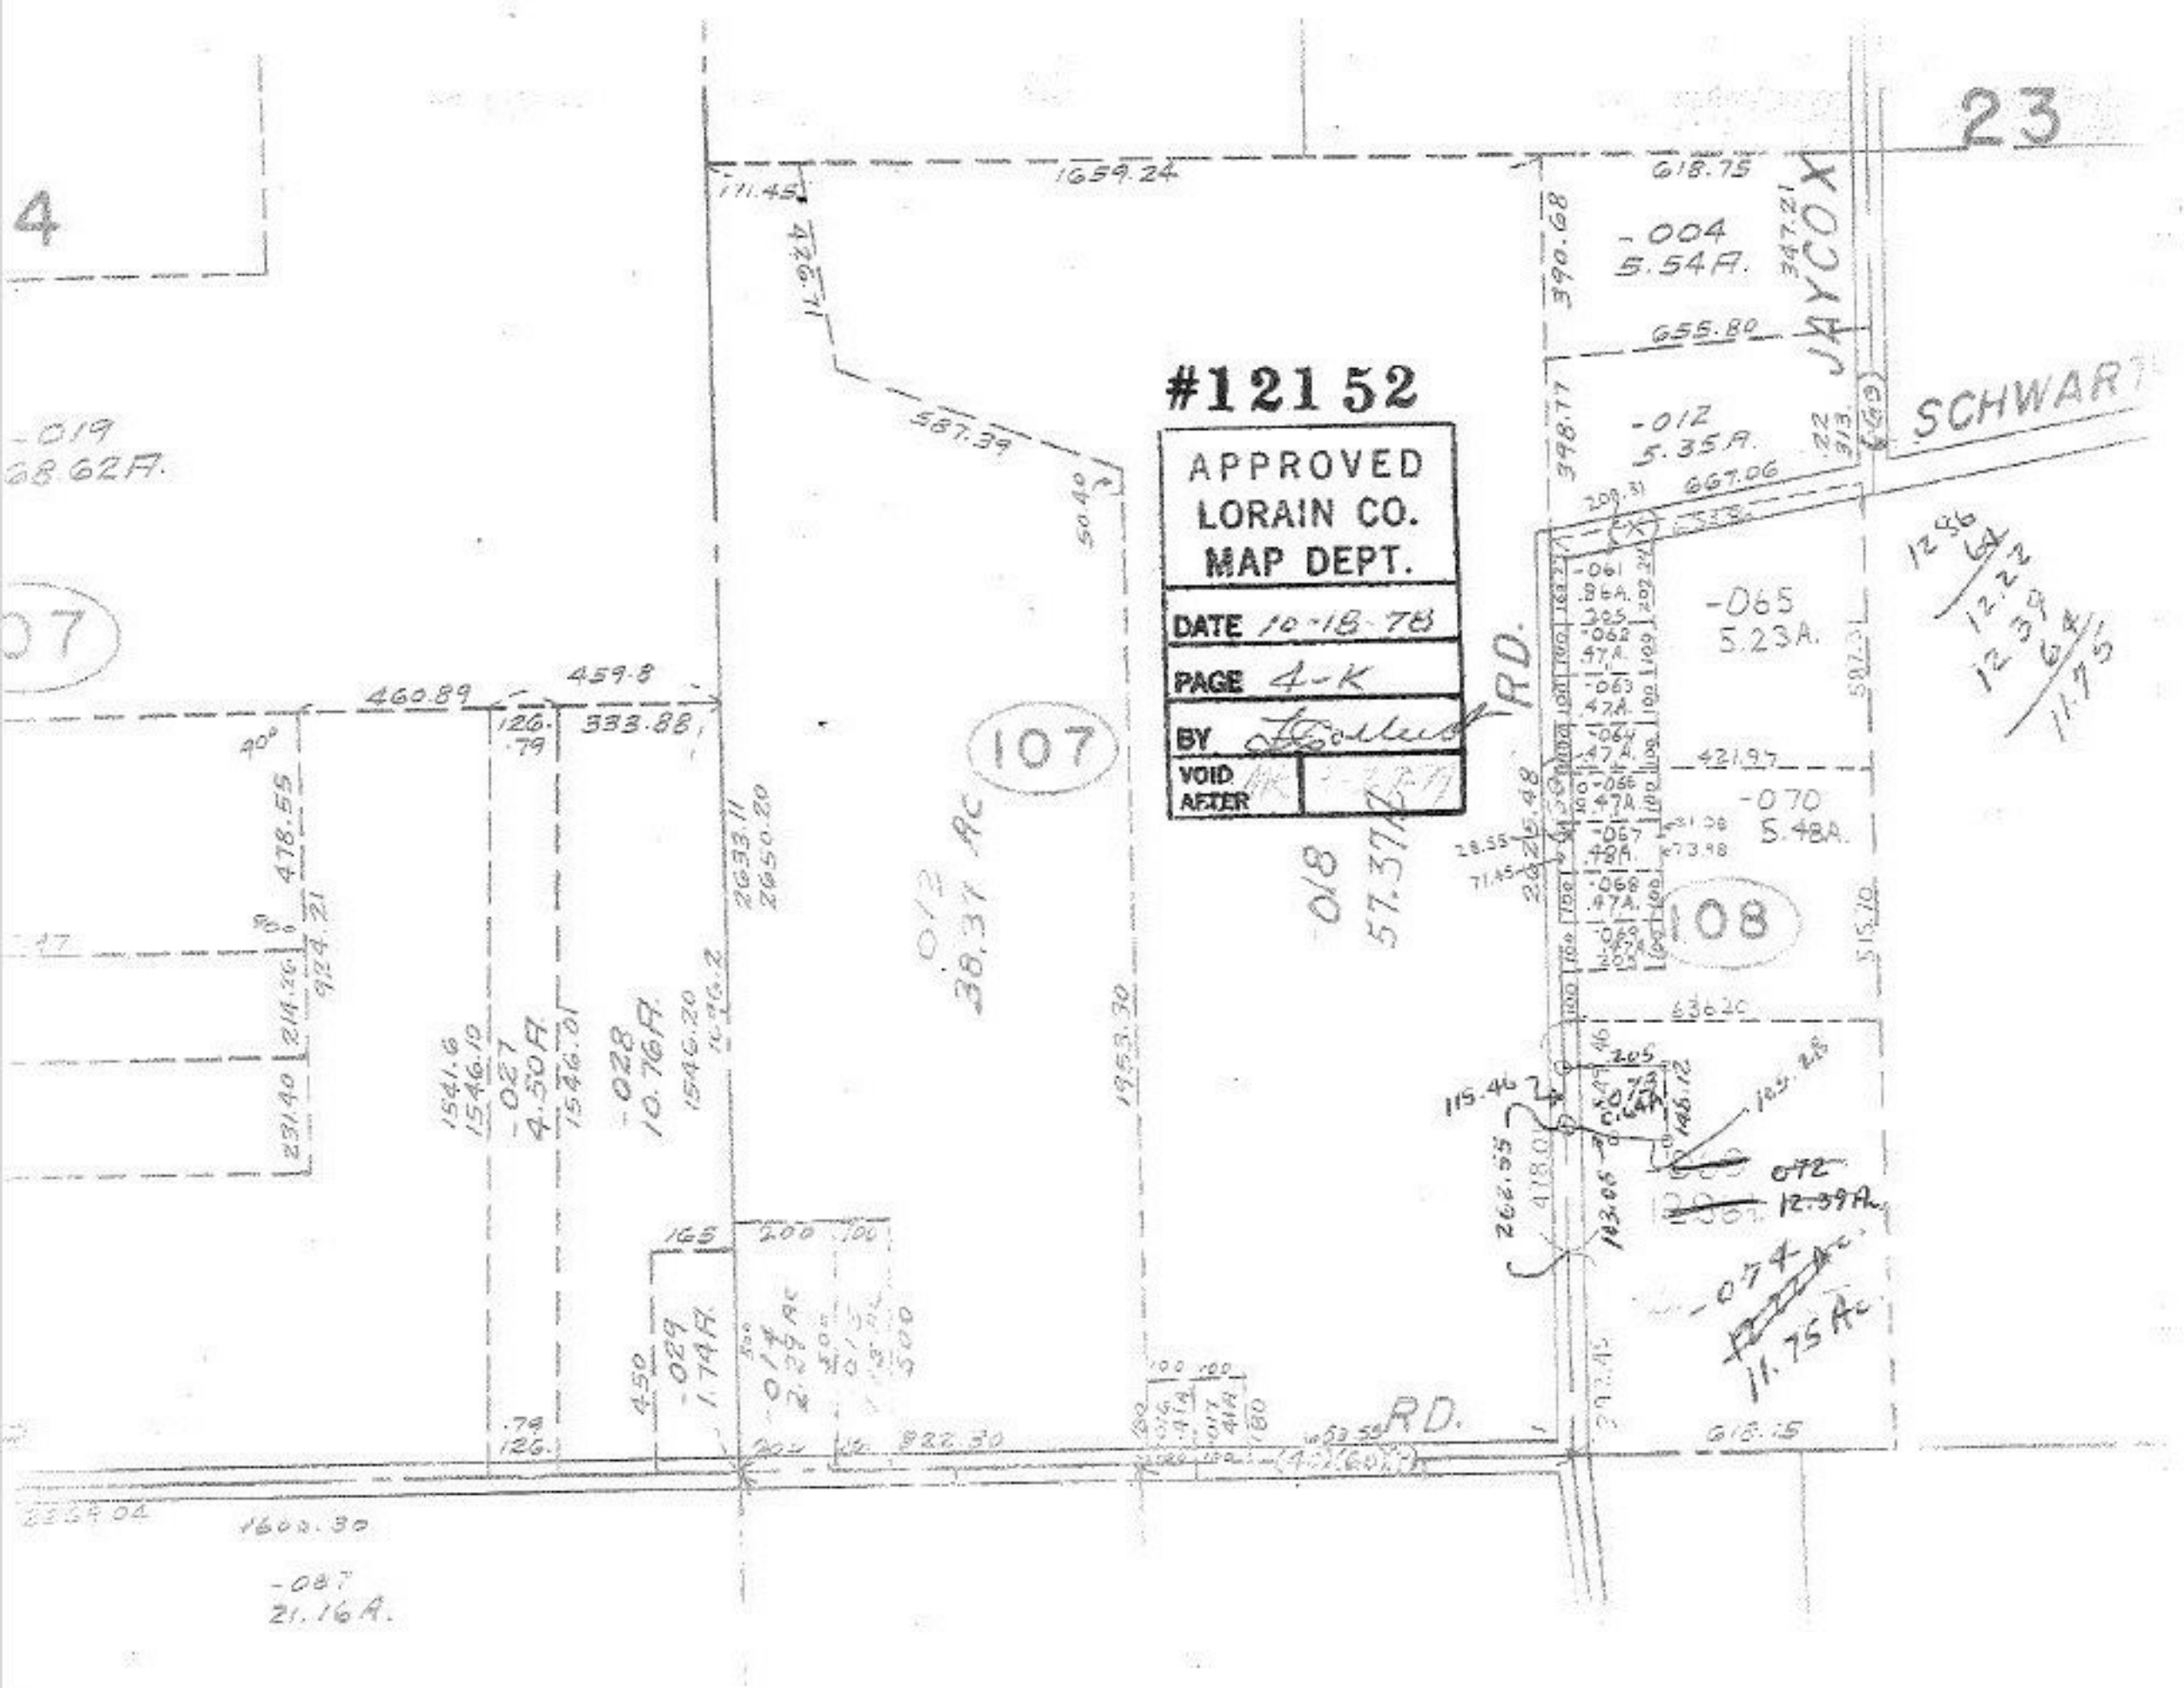

#12152
APPROVED
LORAIN CO.
MAP DEPT.
DATE 10-18-78
PAGE 4-K
BY
VOID AFTER
23
4
107
108
JAYCOX
SCHWART
RD.
-004
5.54A.
-012
5.35A.
-065
5.23A.
-070
5.48A.
-019
68.62A.
-027
4.50A.
-028
10.76A.
-029
1.74A.
-014
2.29 Ac
-018
57.37A
-072
12.39A.
-074
11.75 Ac
-087
21.16A.
1659.24
618.75
655.80
667.06
421.97
636.20
1953.30
1600.30
822.30