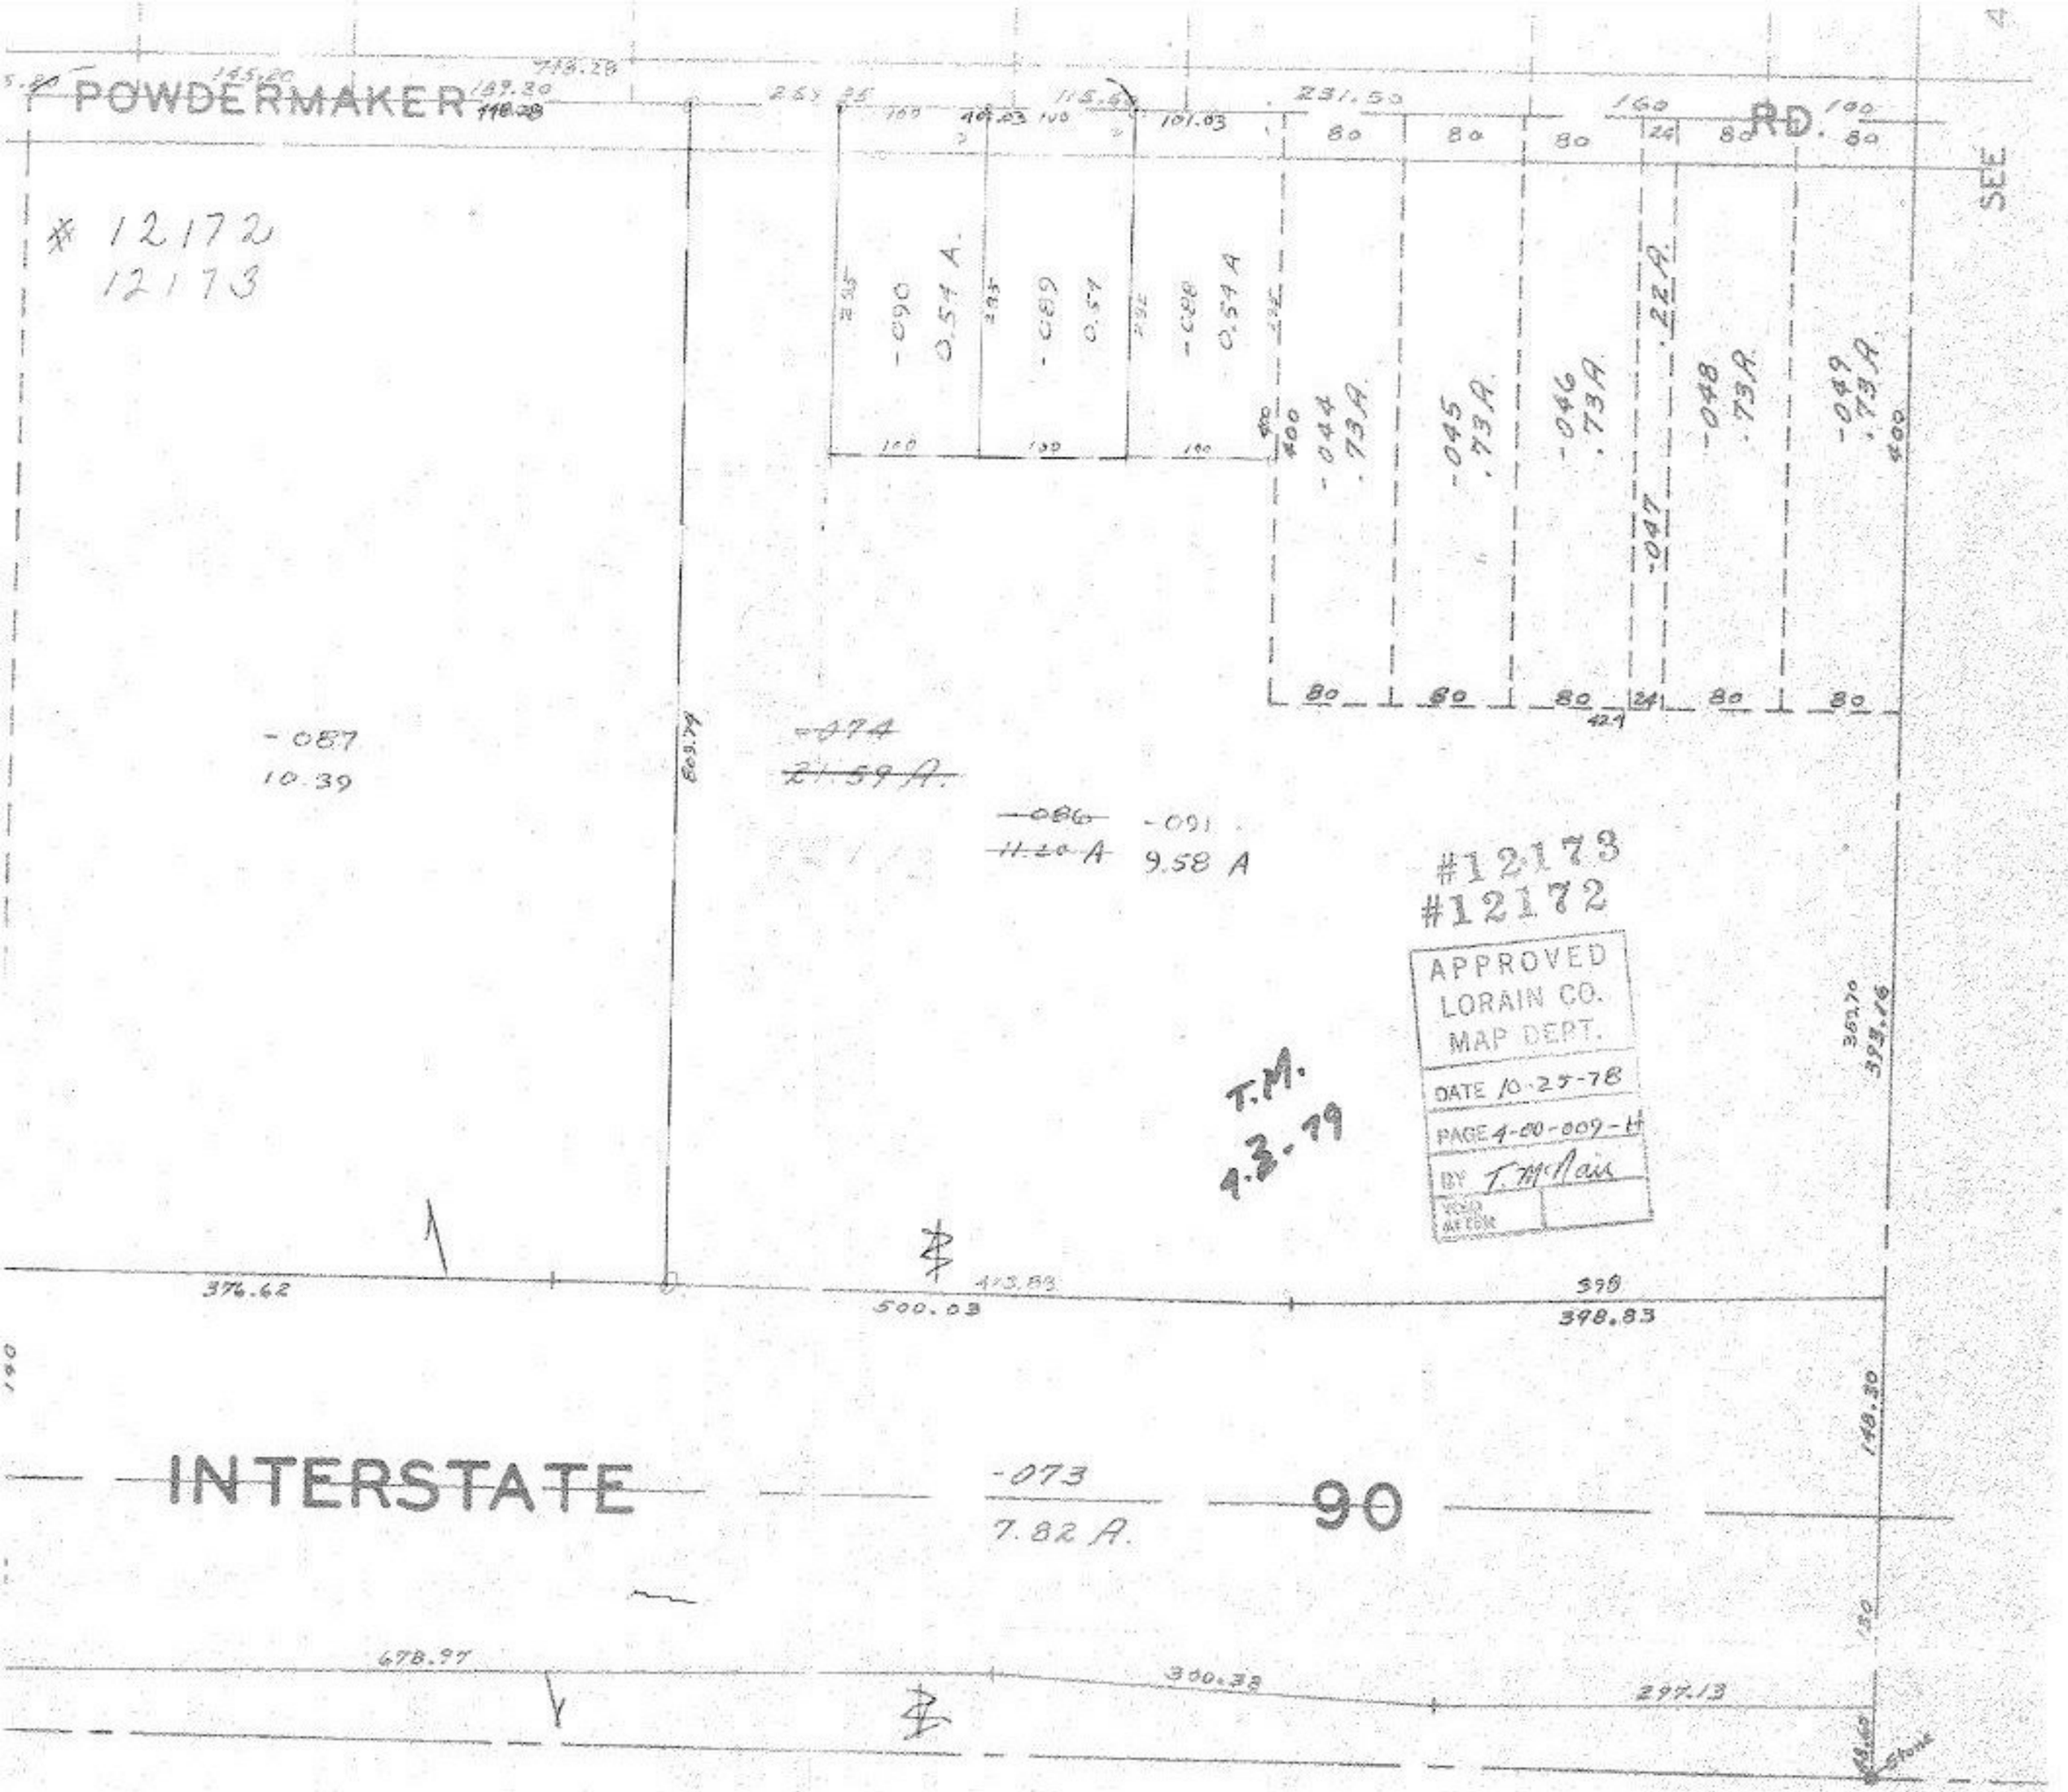
POWDERMAKER
RD.
SEE
# 12172
12173
-090
0.54 A.
-089
0.54
-088
0.54 A
-044
.73 A.
-045
.73 A.
-046
.73 A.
-047
.22 A.
-048
.73 A.
-049
.73 A.
-087
10.39
-074
21.59 A.
-086
11.20 A
-091
9.58 A
#12173
#12172
APPROVED
LORAIN CO.
MAP DEPT.
DATE 10-25-78
PAGE 4-00-009-H
BY T. McNair
T.M.
4.3.79
376.62
500.03
398.83
INTERSTATE
90
-073
7.82 A.
678.97
300.38
297.13