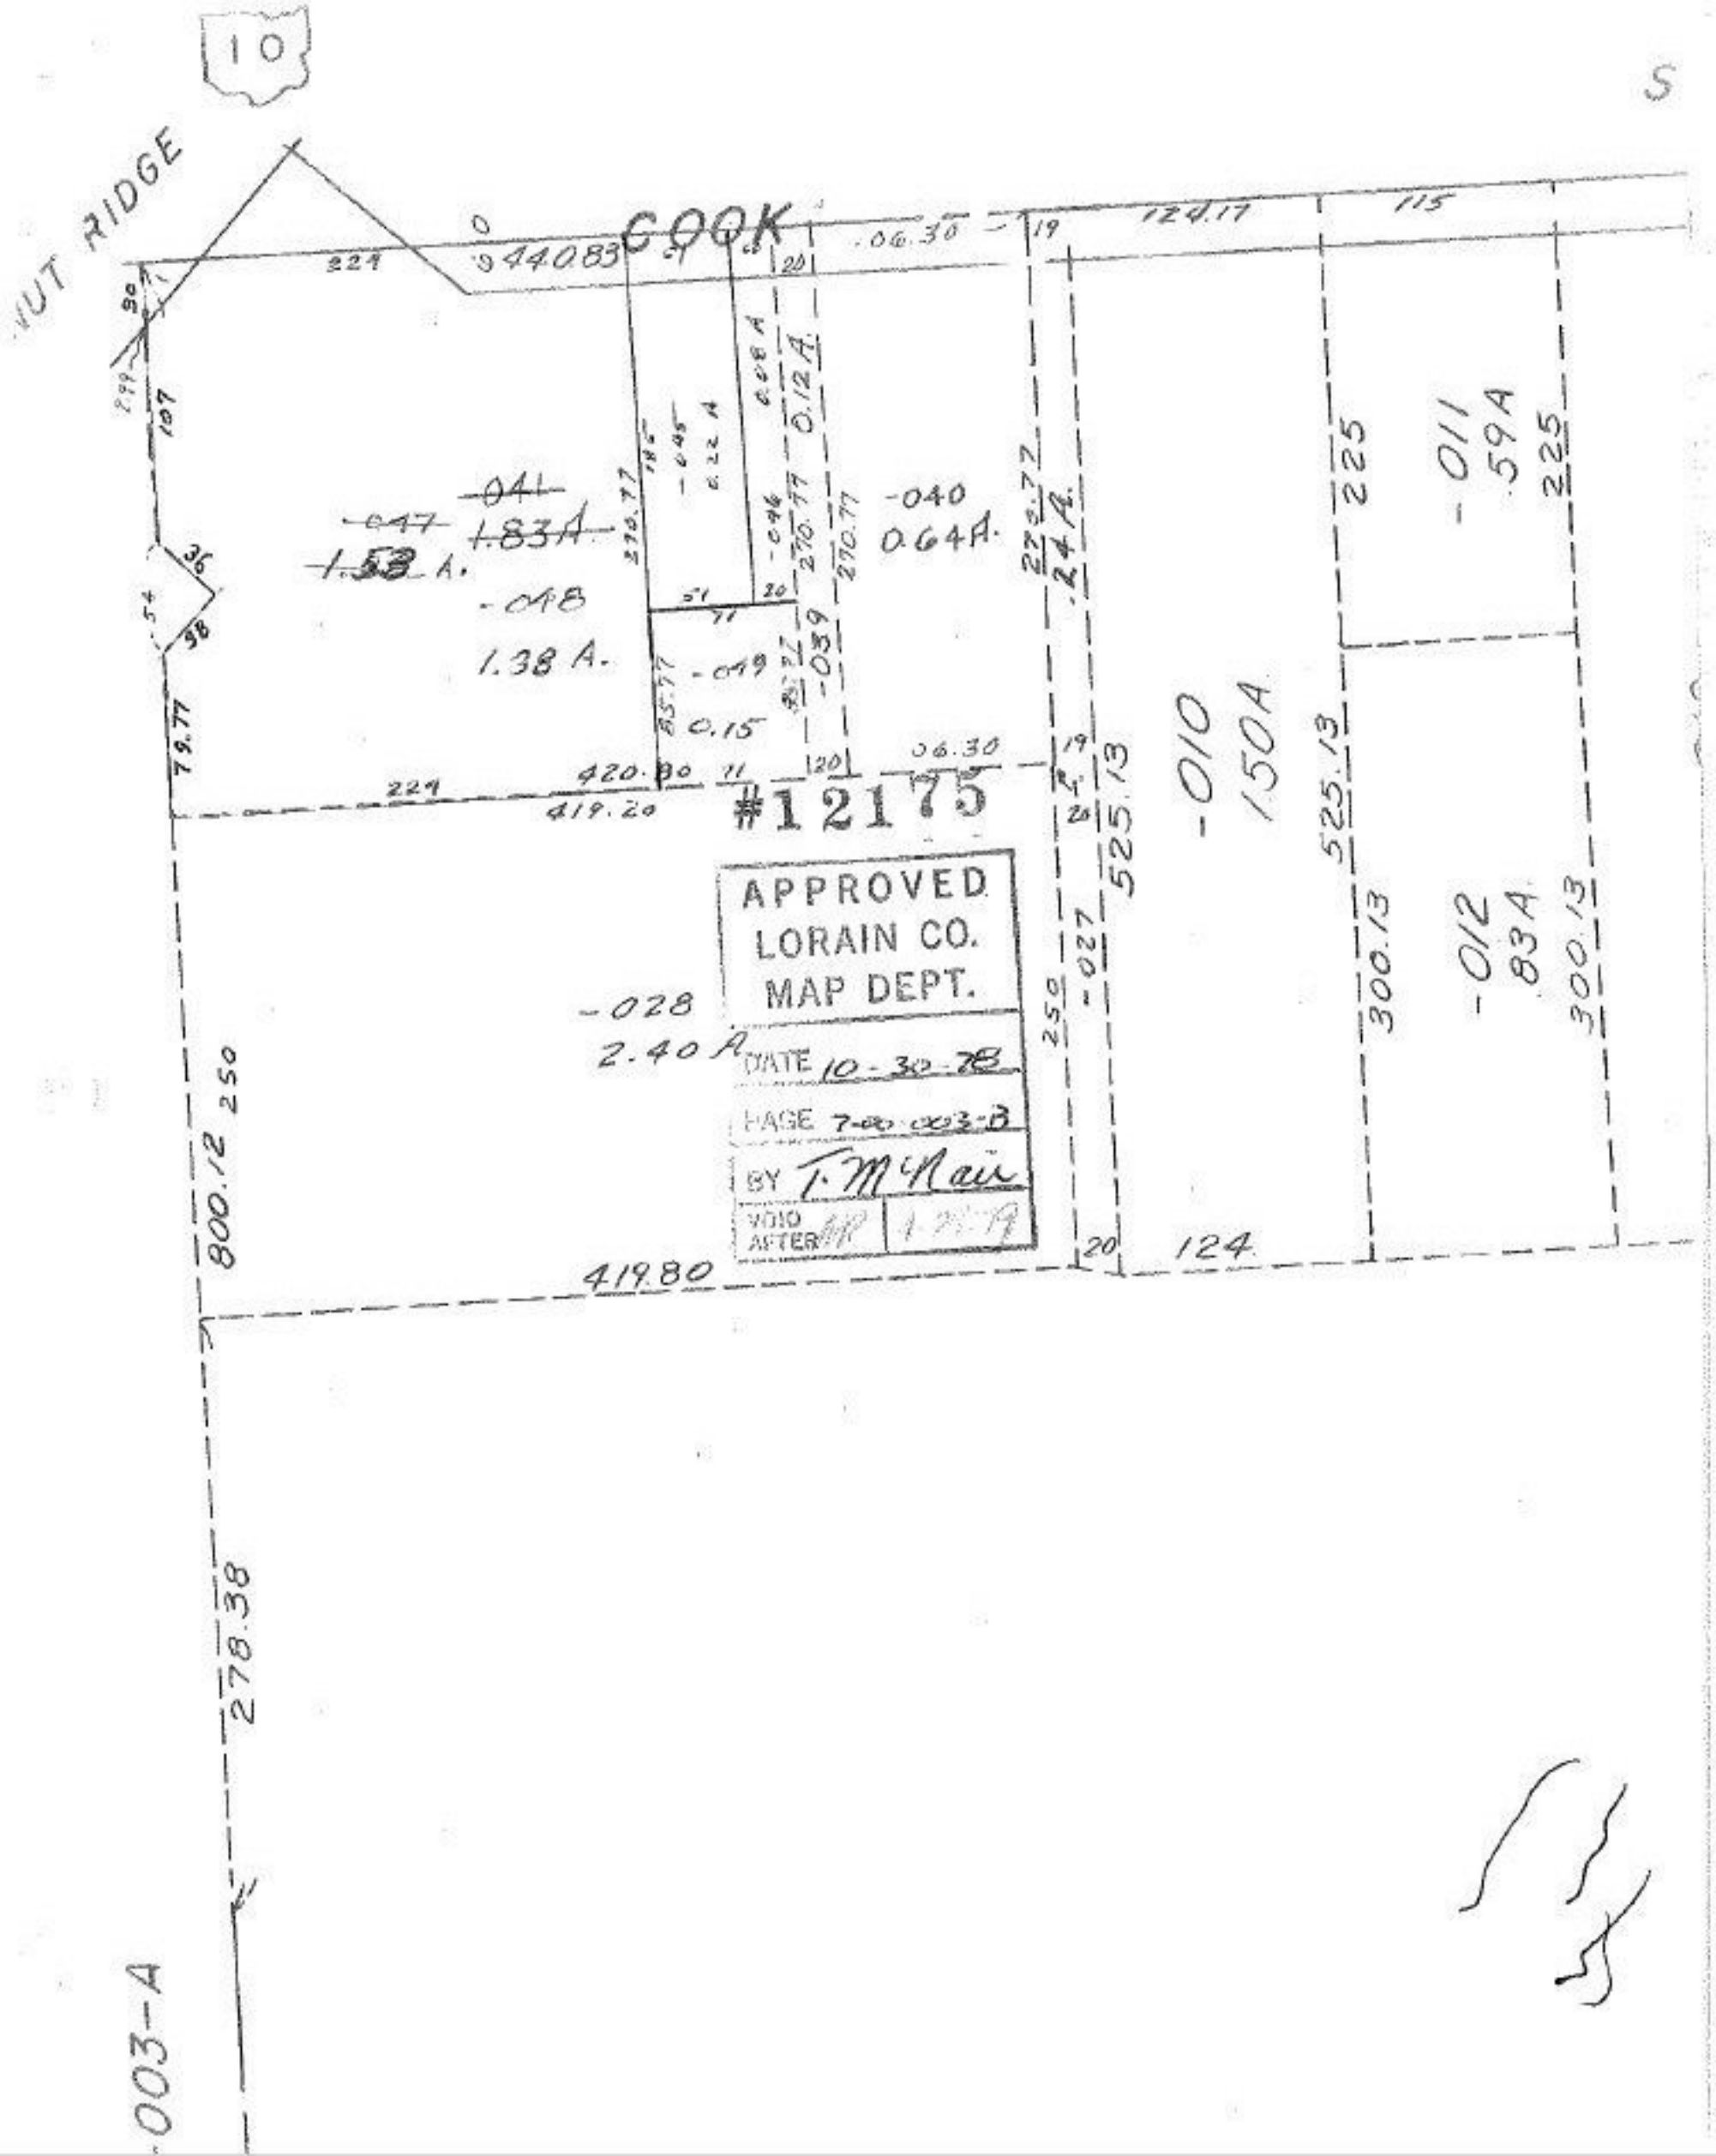
10
S
NUT RIDGE
COOK
440.83
224
06.30
124.17
115
-041
1.83A
-047
1.53 A.
-048
1.38 A.
-049
0.15
-040
0.64A.
-039
0.12A.
-011
.59A
225
-010
150A
525.13
-012
.83A
300.13
-027
-028
2.40 A
420.80
419.20
#12175
APPROVED
LORAIN CO.
MAP DEPT.
DATE 10-30-78
PAGE 7-00-003-B
BY T. McNair
VOID AFTER
124
419.80
800.12
278.38
.003-A