#12177

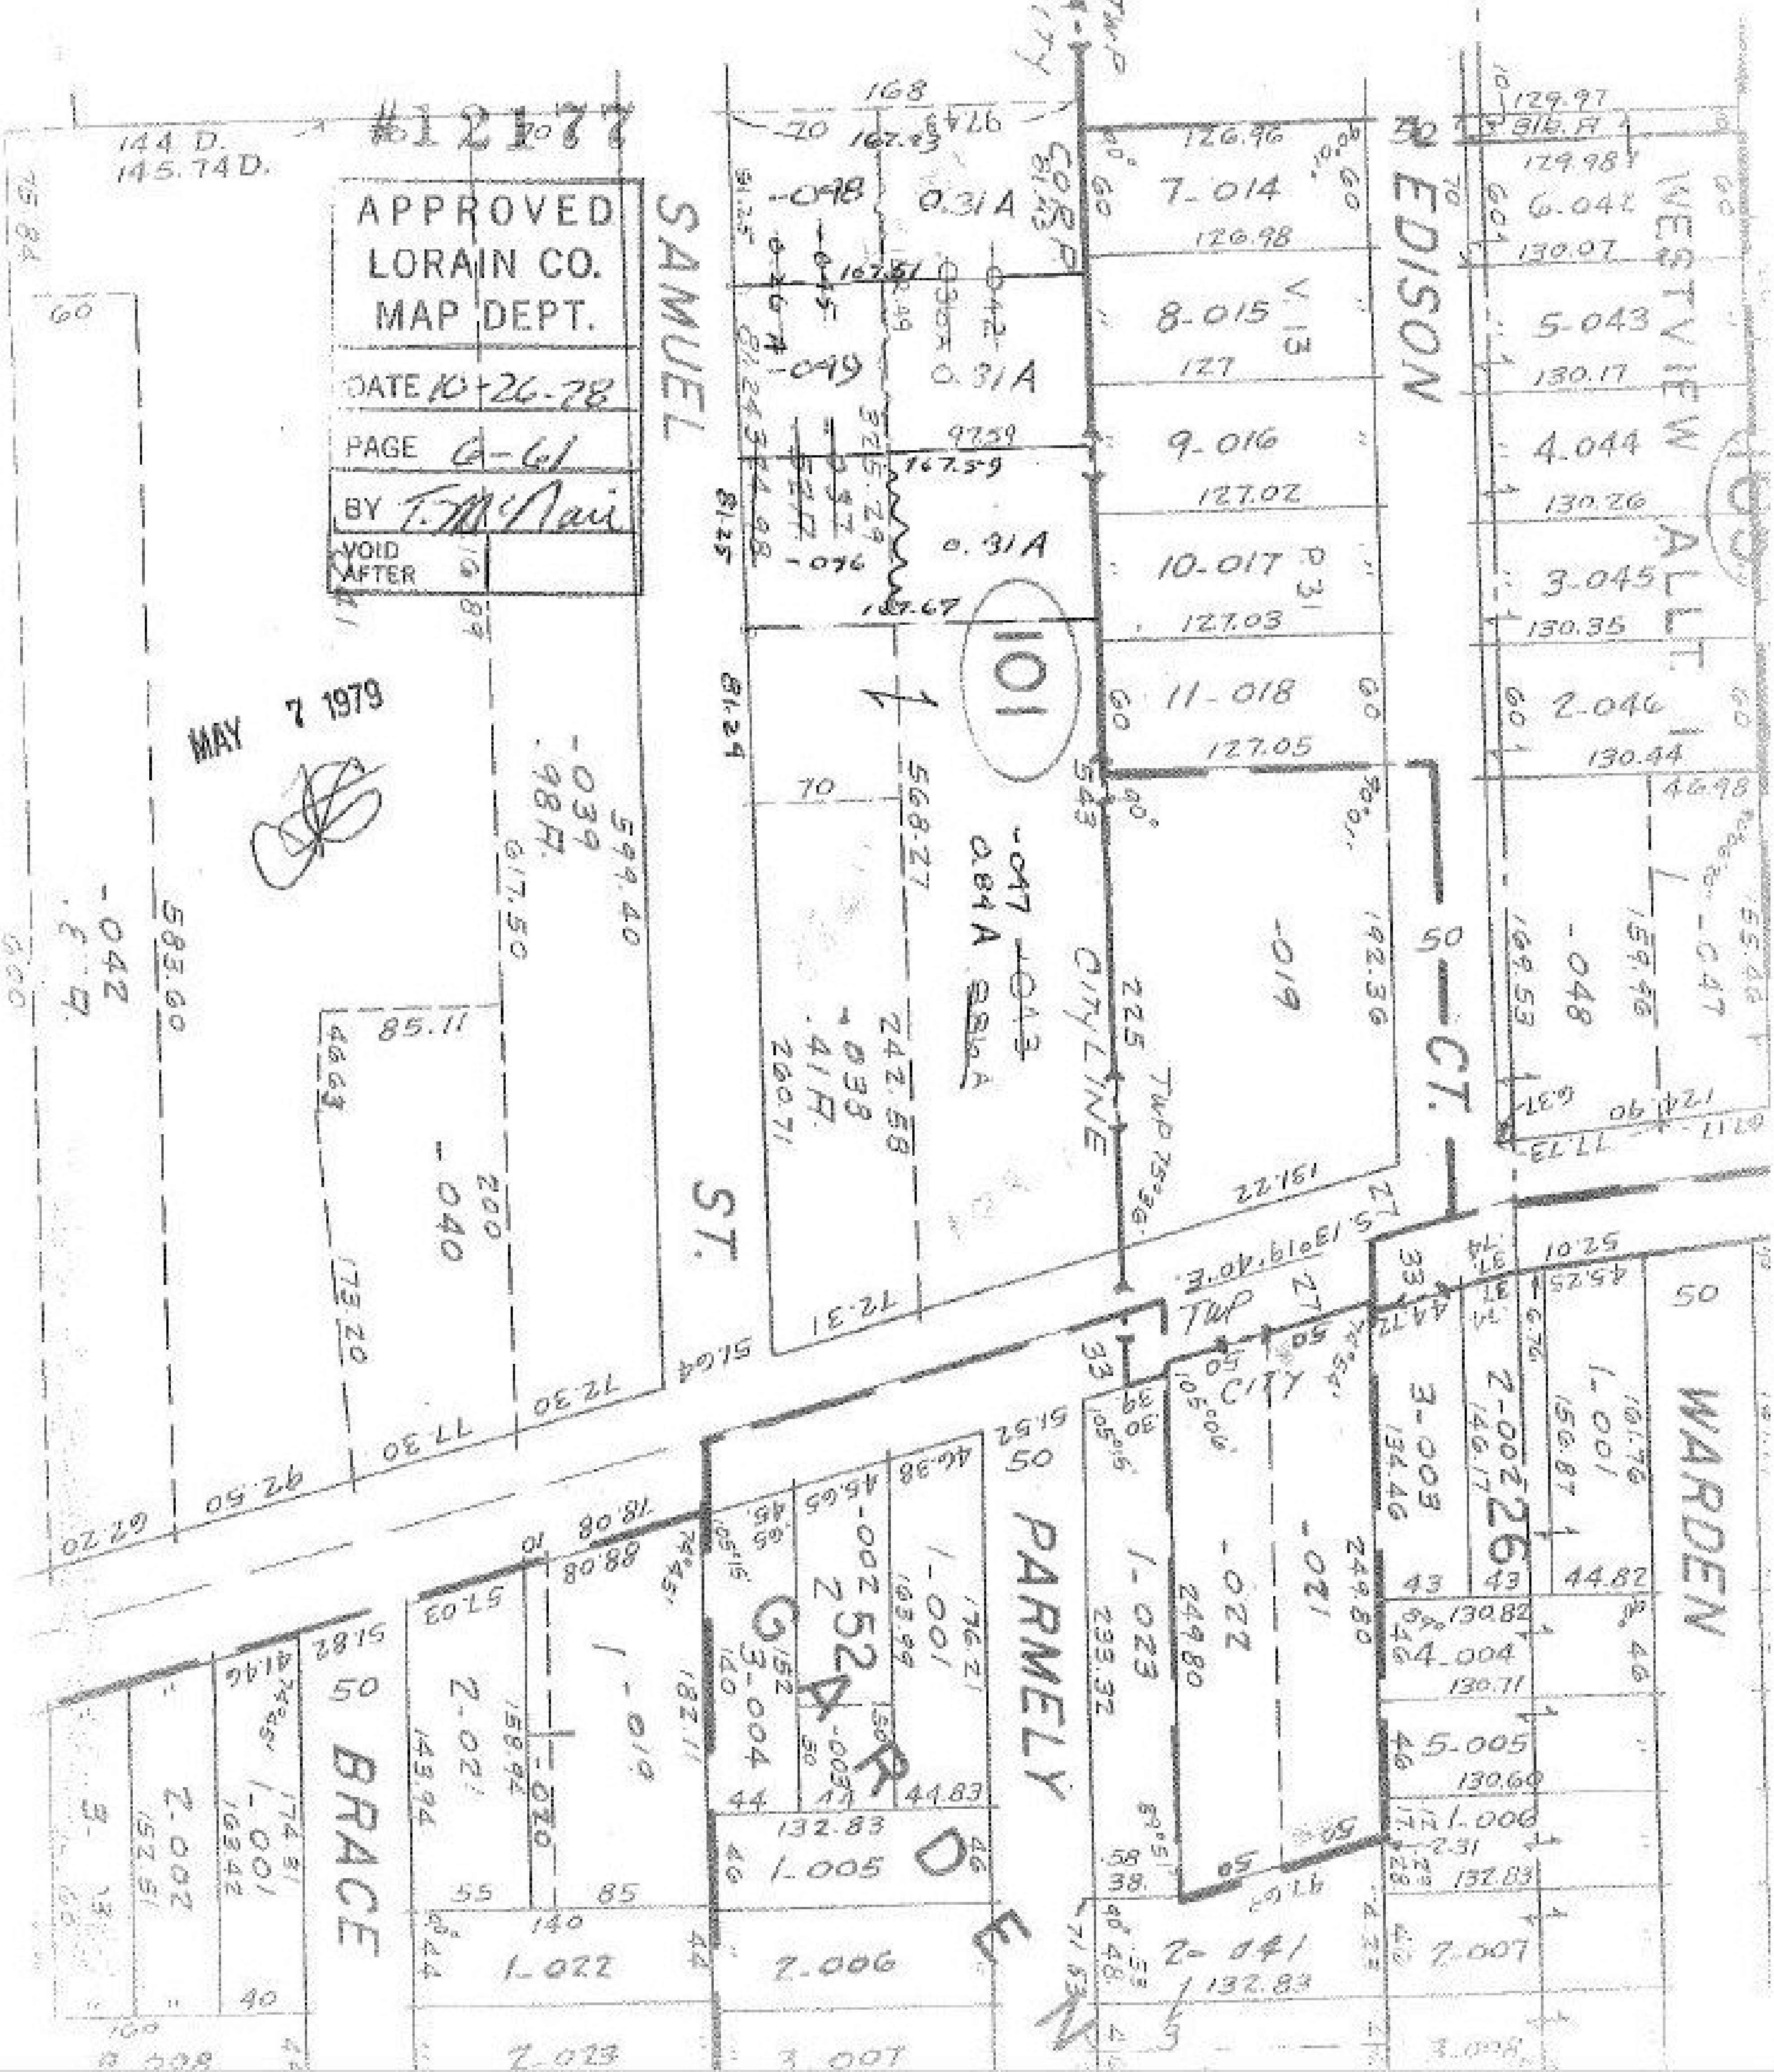
APPROVED
LORAIN CO.
MAP DEPT.
DATE 10-26-78
PAGE G-61
BY T. McNair
VOID AFTER
MAY 7 1979
SAMUEL ST.
EDISON CT.
WESTVIEW ALLOT.
PARMELY
GARDEN
BRACE
WARDEN
CITY LINE
TWP
CITY
101
7-014
8-015
9-016
10-017
11-018
6-042
5-043
4-044
3-045
2-046
-019
-048
-047
0.84A
-098
-099
-076
0.31A
-039
-040
-042
-038
3-003
2-002
1-001
1-023
-022
-021
4-004
5-005
1-006
7-007
2-041
1-005
2-006
1-022
2-021
-020
1-019
3-004
2-002
1-001
252
26