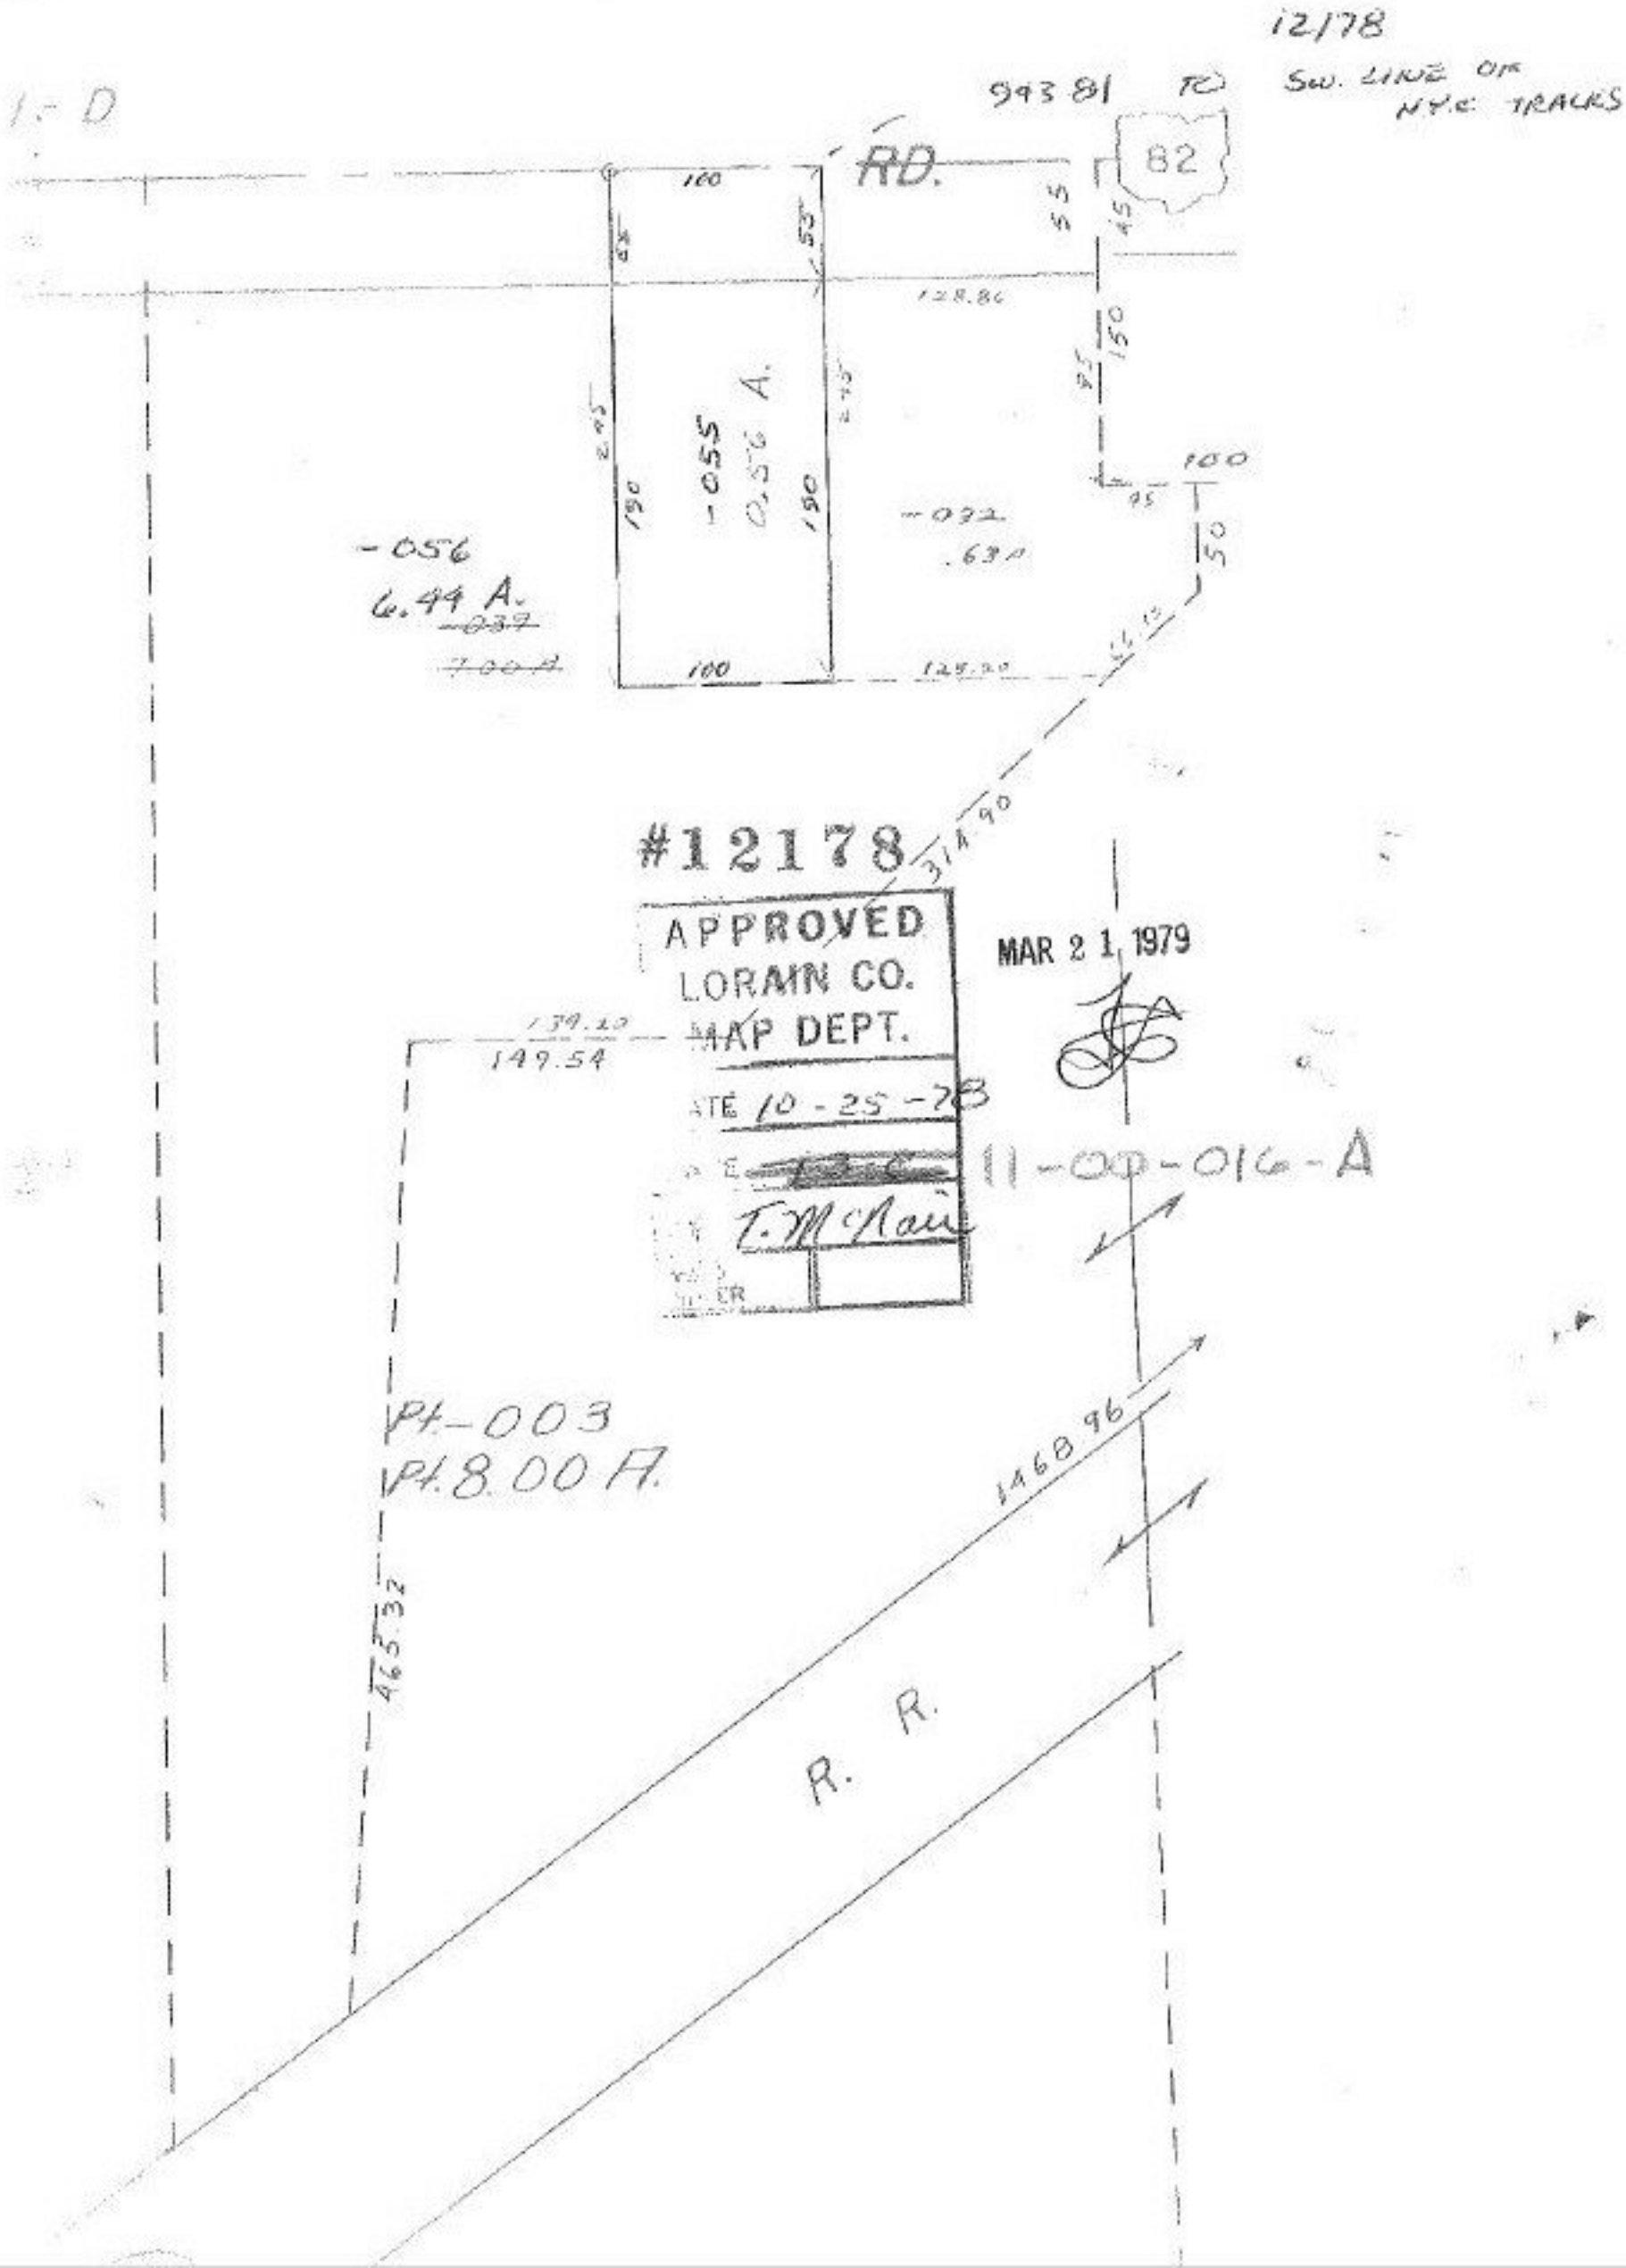
12178
SW. LINE OF N.Y.C. TRACKS
993.81
RD.
82
100
55
45
128.86
150
-055
0.56 A.
190
-056
6.44 A.
-032
.63 A
100
50
125.20
314.90
#12178
APPROVED
LORAIN CO.
MAP DEPT.
DATE 10-25-78
T. McNair
MAR 21 1979
139.20
149.54
11-00-016-A
Pt-003
Pt. 8.00 A.
1468.96
465.32
R. R.