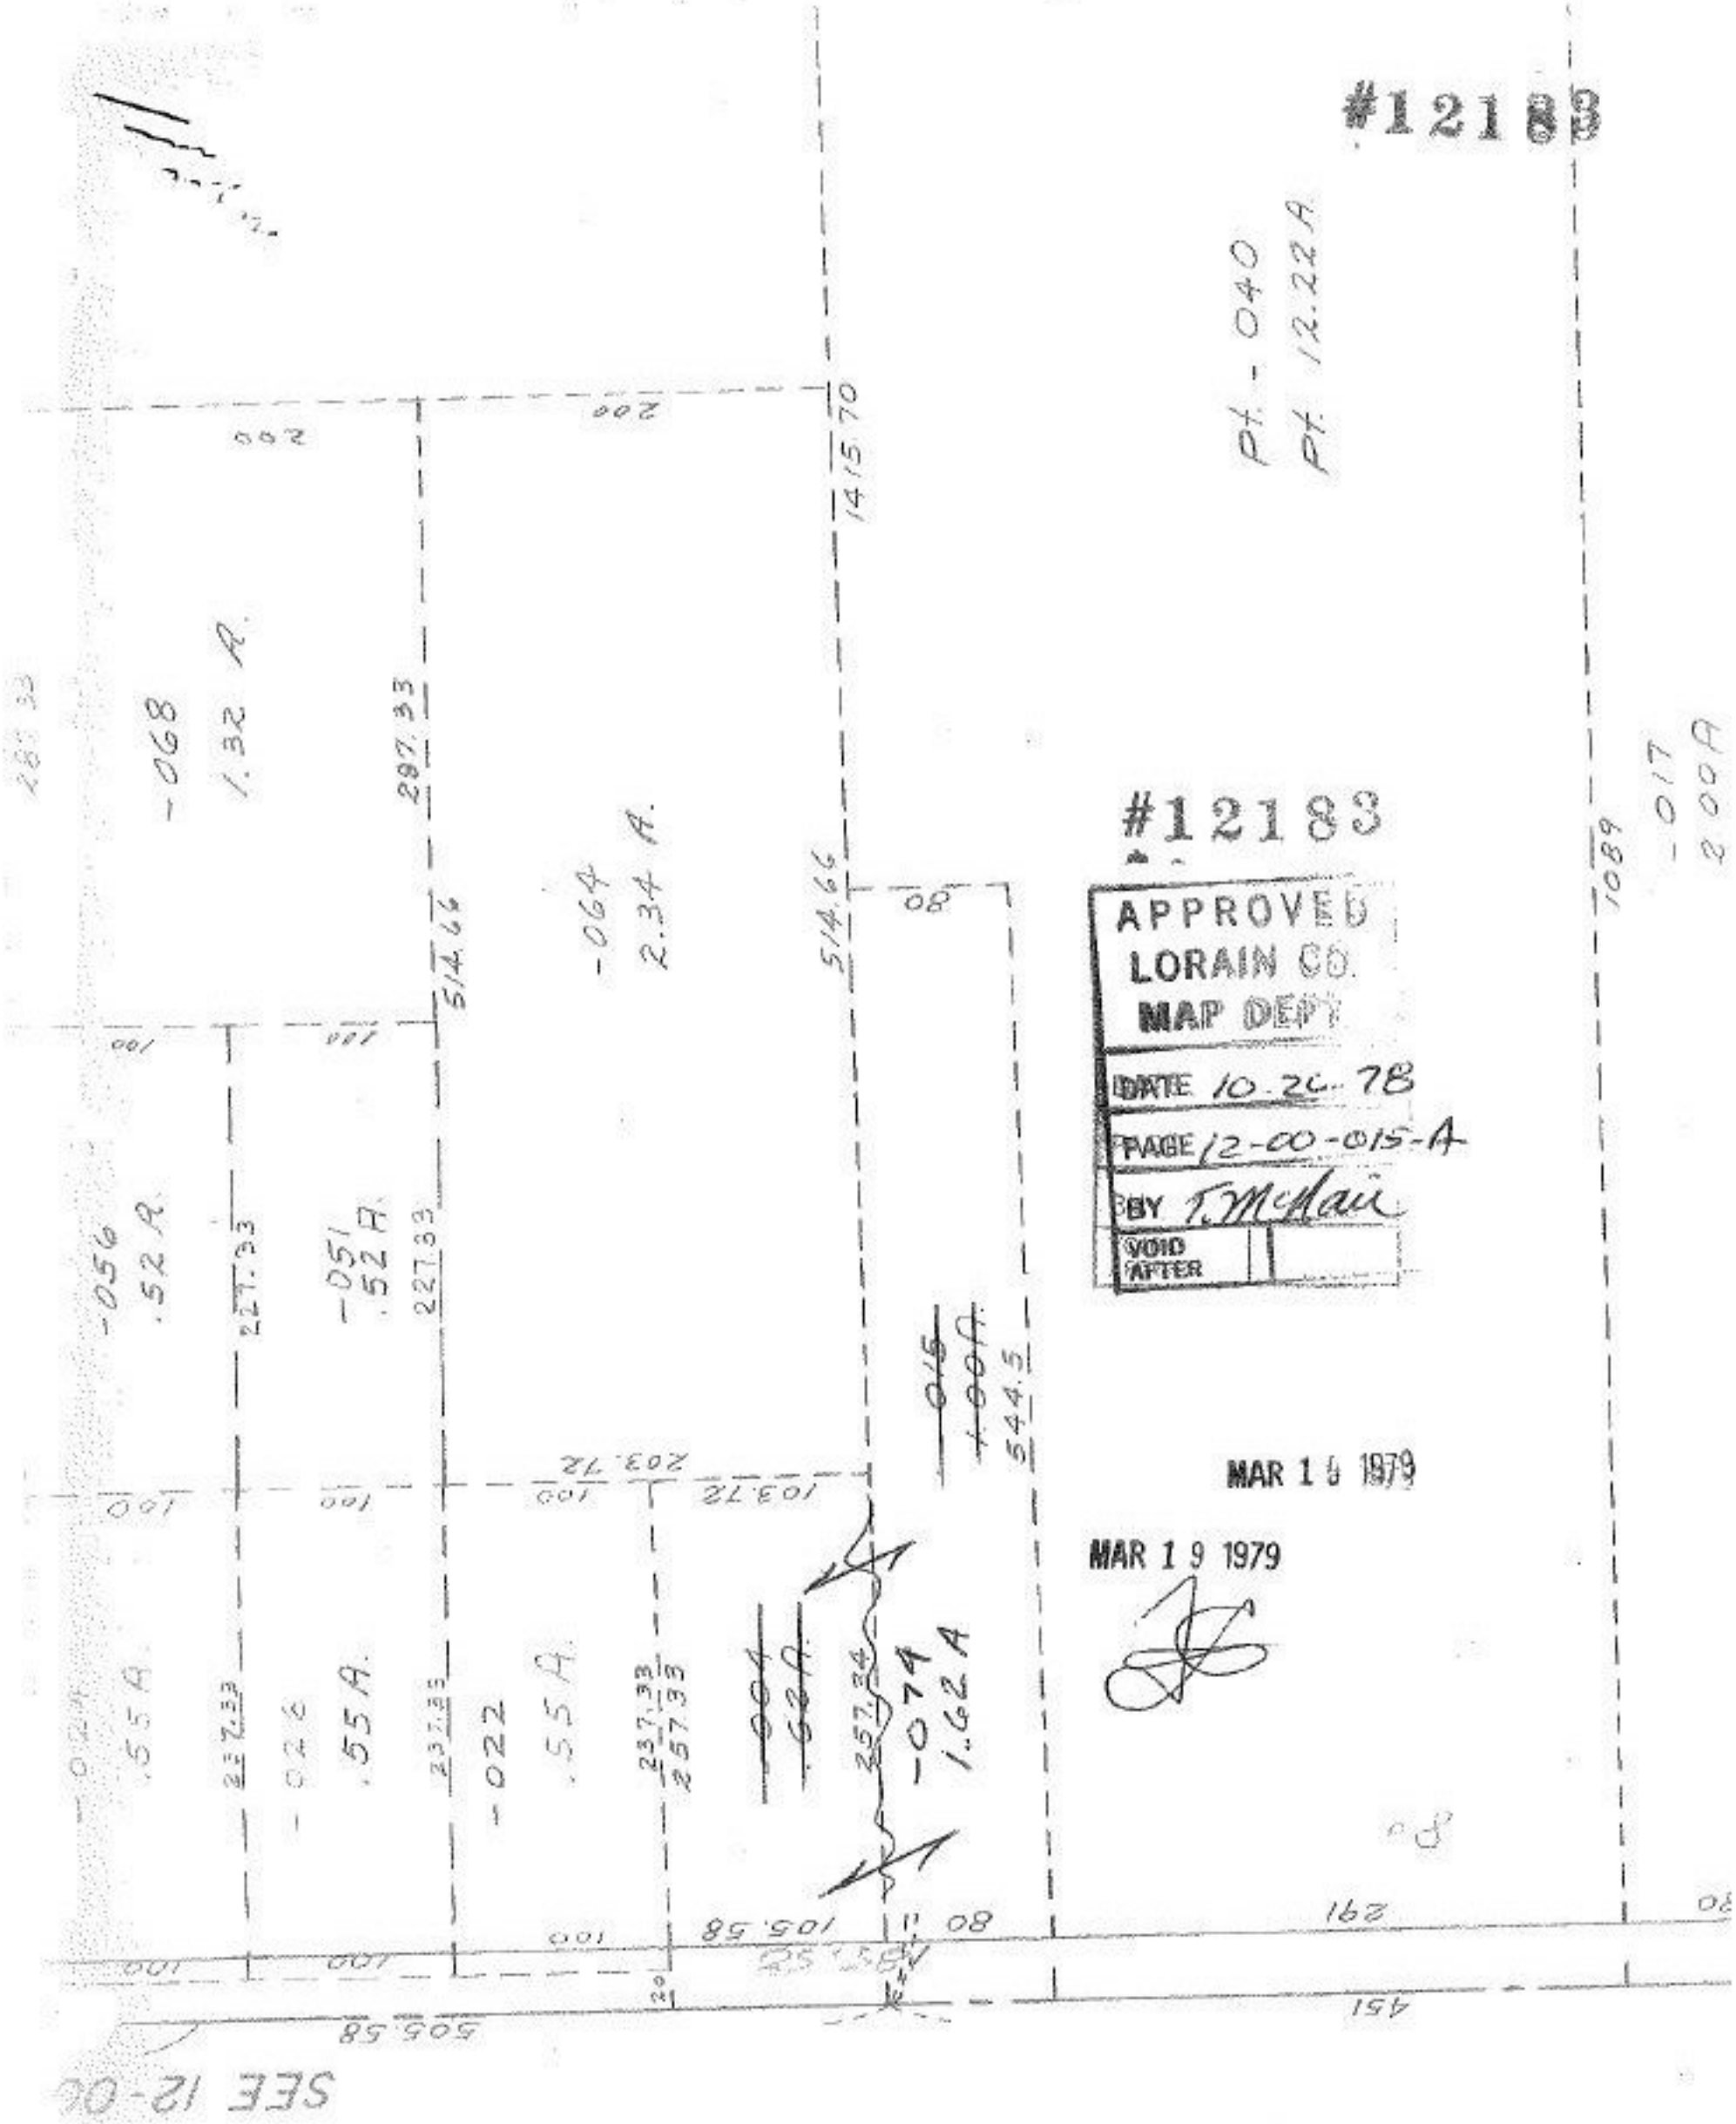

#12183

APPROVED
LORAIN CO.
MAP DEPT
DATE 10-26-78
PAGE 12-00-015-A
BY T. McNair
VOID AFTER

MAR 1 9 1979

MAR 1 9 1979