

OHIO

CENTER
100

#12212


APPROVED LORAIN CO. MAP DEPT.
DATE: 11-3-78
PAGE 7-00-046-E
BY: T. McHair
VOID AFTER

T.M.
5.2.79

-004
10.61 A

SEE 6-90
BLG. ON CEMETERY LAND
07-00-046-500-009

SEE 6-108

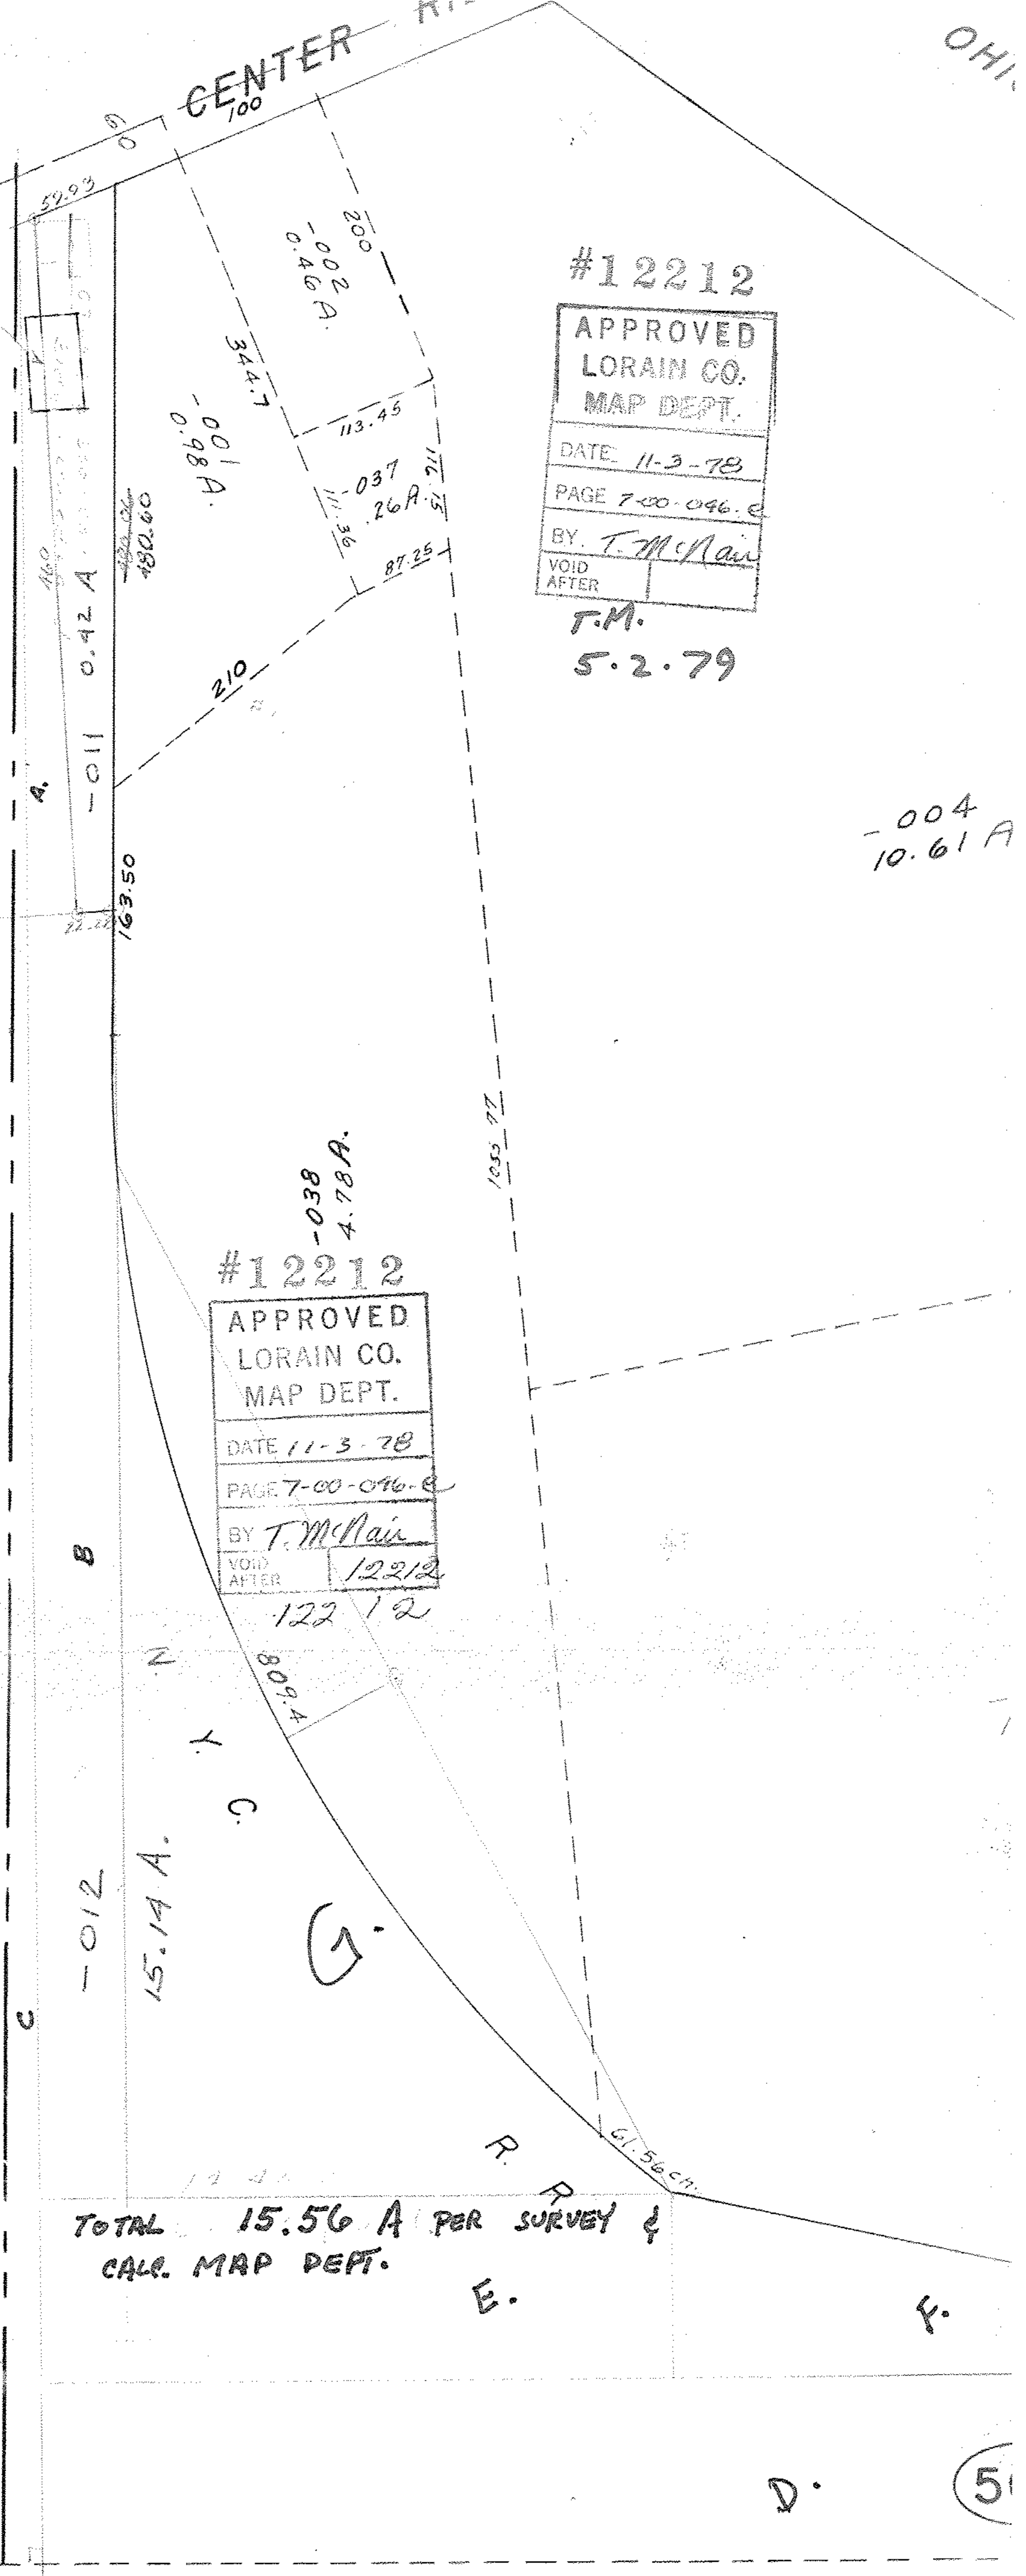

#12212

APPROVED LORAIN CO. MAP DEPT.
DATE 11-3-78
PAGE 7-00-046-E
BY T. McHair
VOID AFTER 12212

122 12

TOTAL 15.56 A PER SURVEY &
CALC. MAP DEPT.

5

N. Y. C.