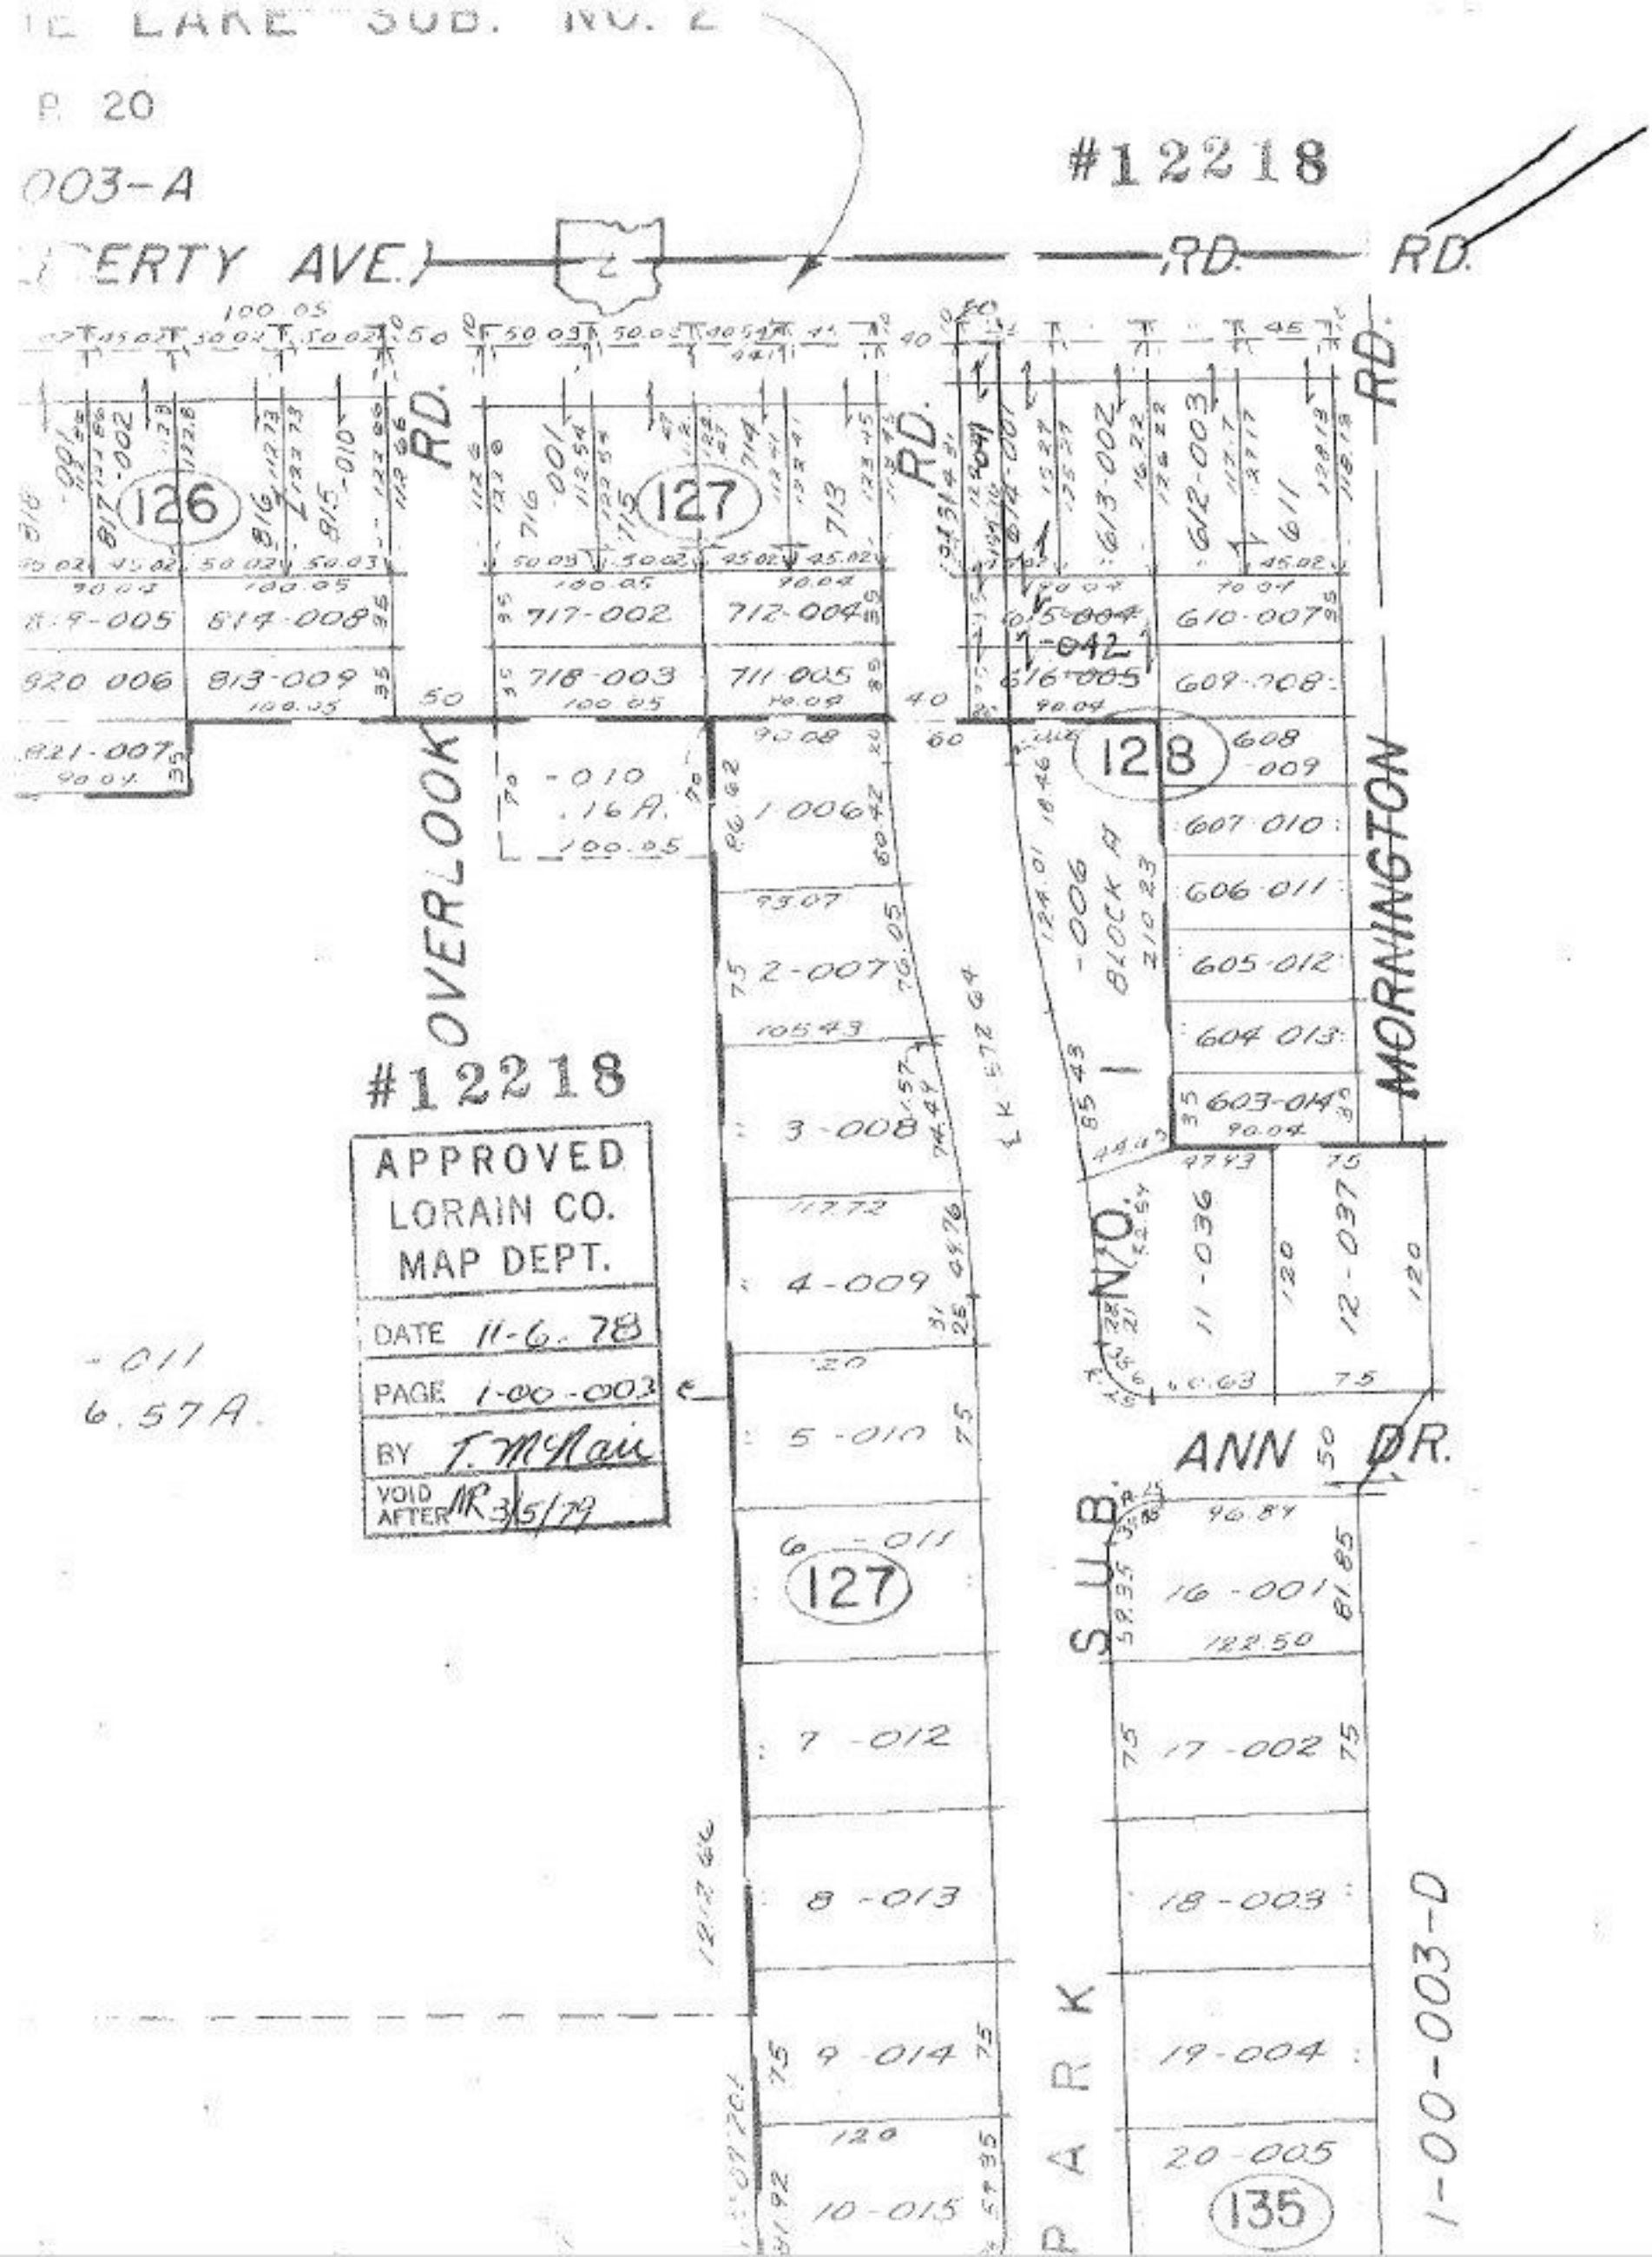

LAKE SUB. NO. 2
P. 20
003-A
#12218
ERTY AVE.
RD.
RD.
RD.
RD.
RD.
RD.
OVERLOOK
MORNINGTON
ANN DR.
SUB. NO.
PARK
126
127
128
127
135
814-008
813-009
820 006
821-007
717-002
718-003
712-004
711-005
1-006
2-007
3-008
4-009
5-010
6-011
7-012
8-013
9-014
10-015
610-007
609-008
607-010
606-011
605-012
604-013
603-014
11-036
12-037
16-001
17-002
18-003
19-004
20-005
-011
6.57A.
1-00-003-D
#12218
APPROVED
LORAIN CO.
MAP DEPT.
DATE 11-6-78
PAGE 1-00-003
BY T. McNair
VOID AFTER MR 3/5/79