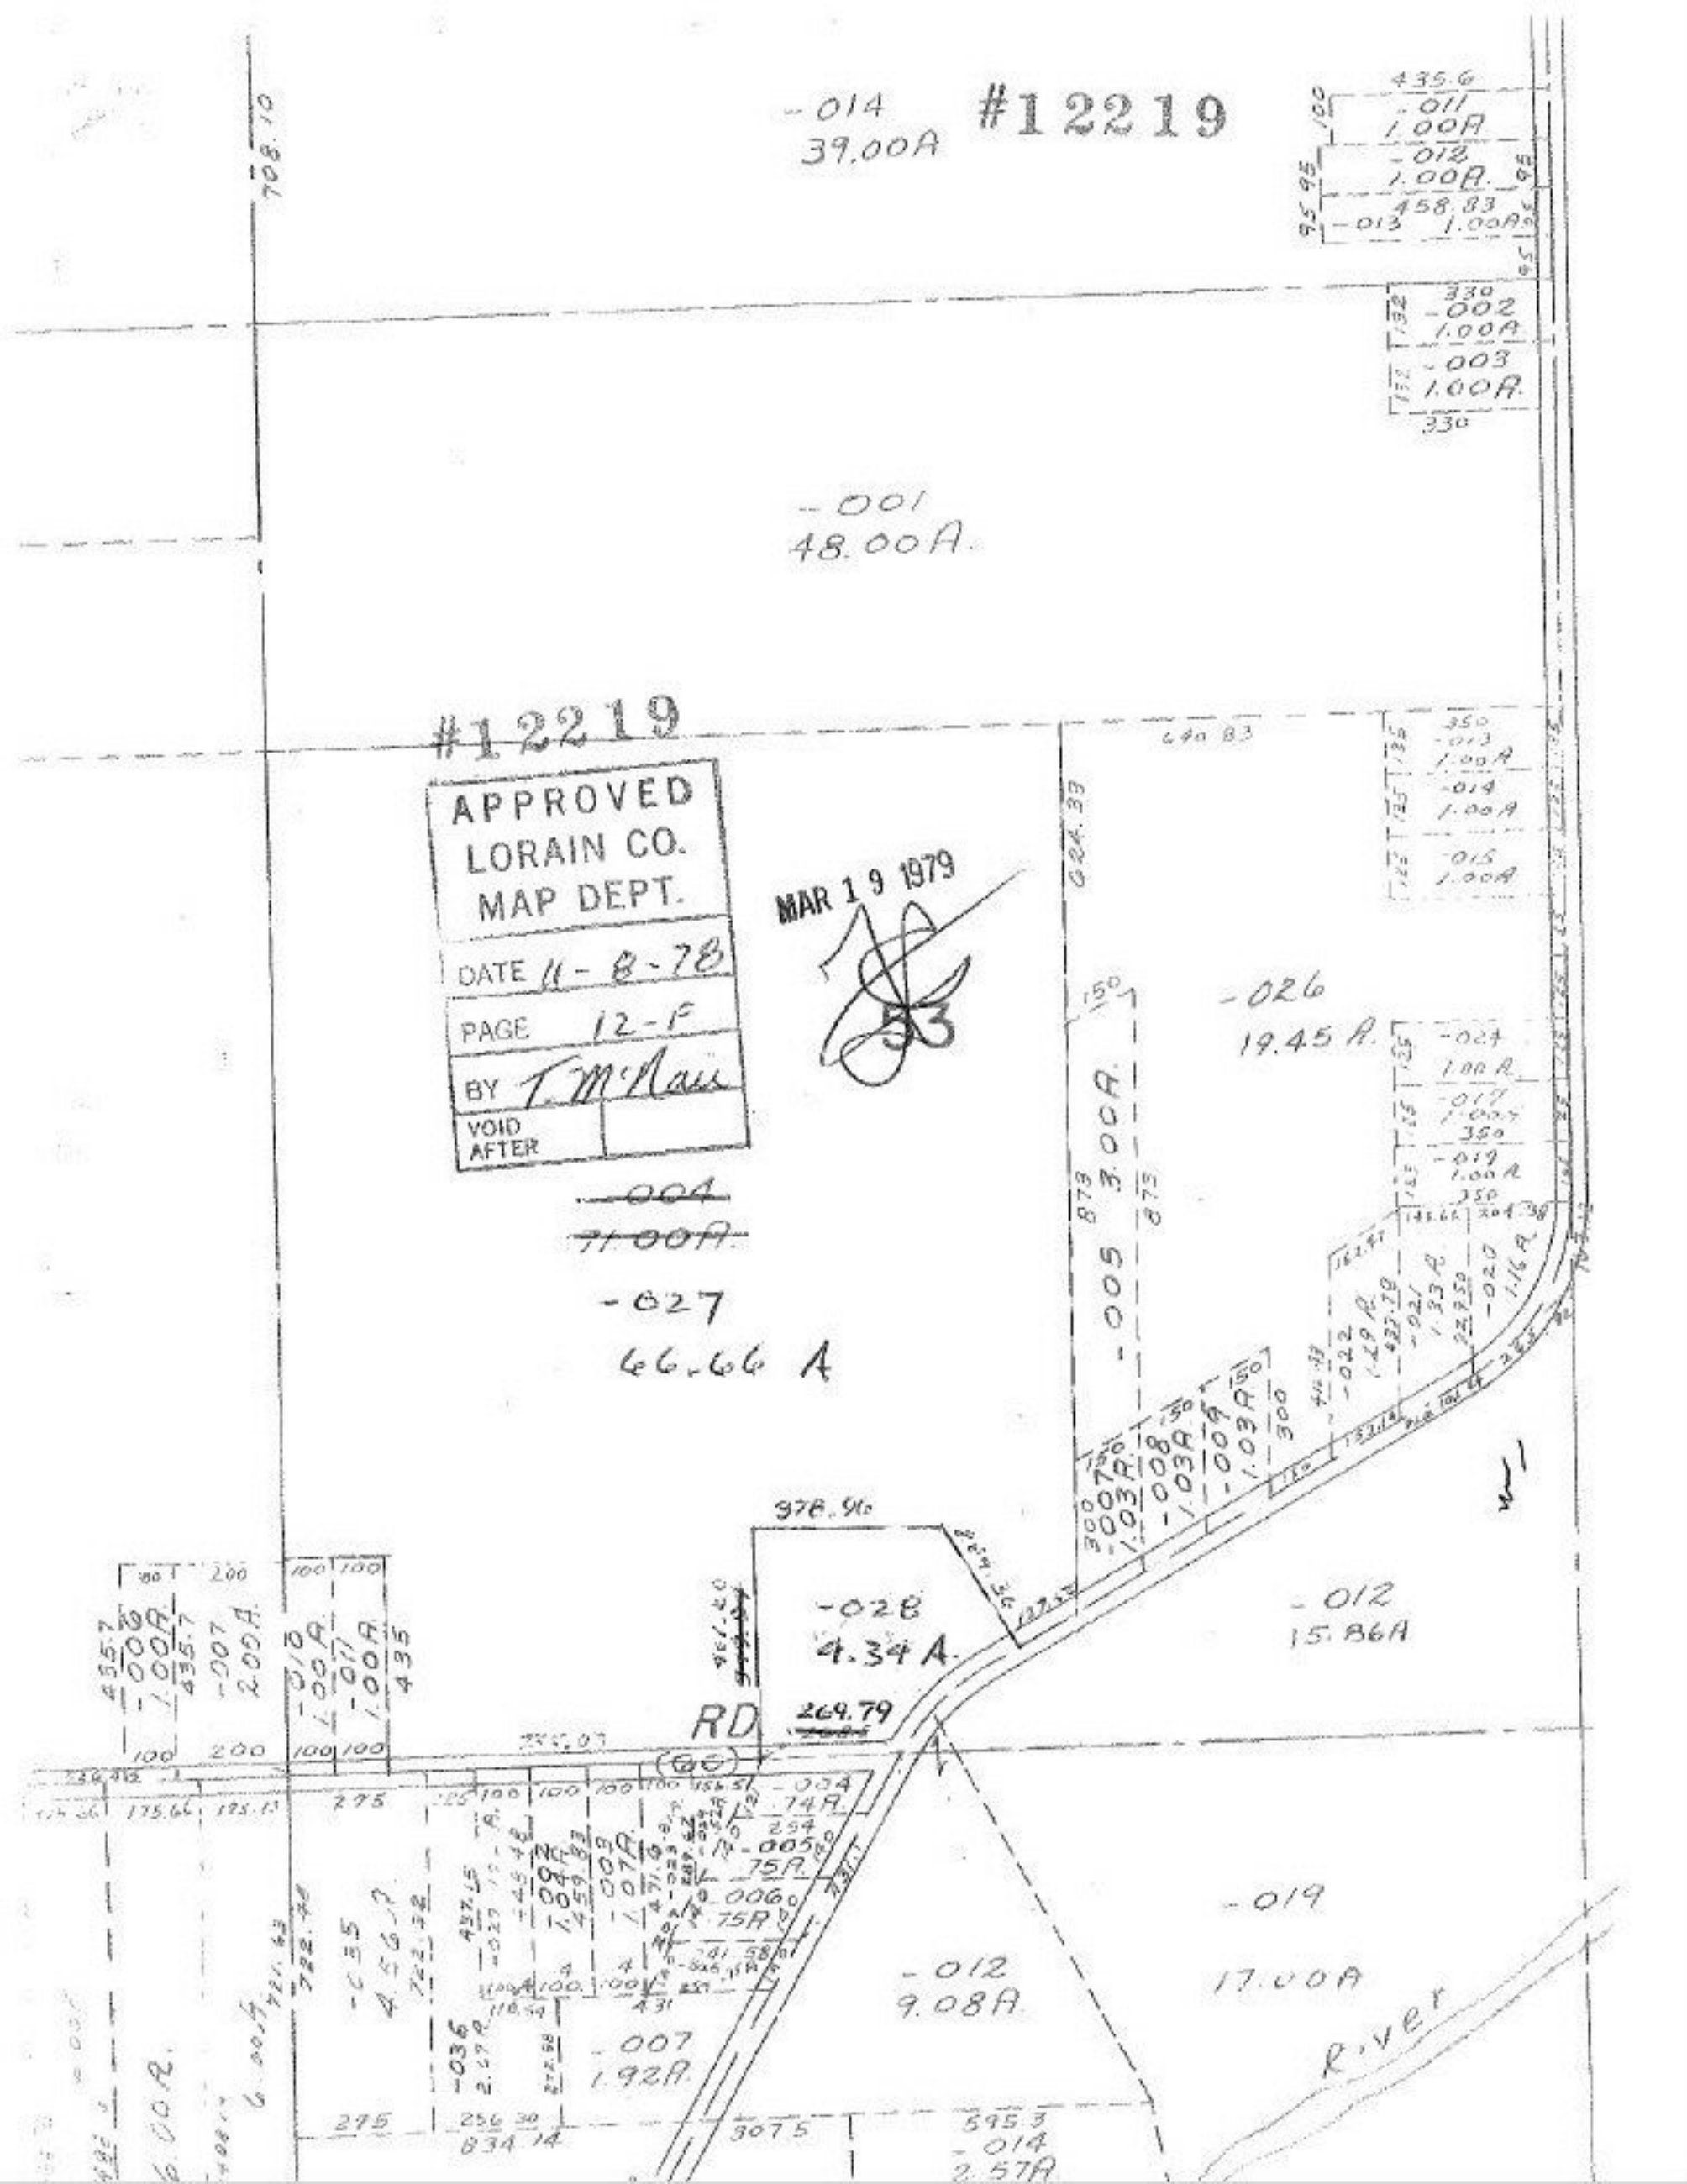

#12219
-014
39.00A
-001
48.00A
#12219
APPROVED
LORAIN CO.
MAP DEPT.
DATE 11-8-78
PAGE 12-F
BY T. McNair
VOID AFTER
MAR 19 1979
53
-004
71.00A
-027
66.66 A
-026
19.45 A
-028
4.34 A
-012
15.86A
RD
269.79
-012
9.08A
-019
17.00A
-007
1.92A
-014
2.57A
River