12221

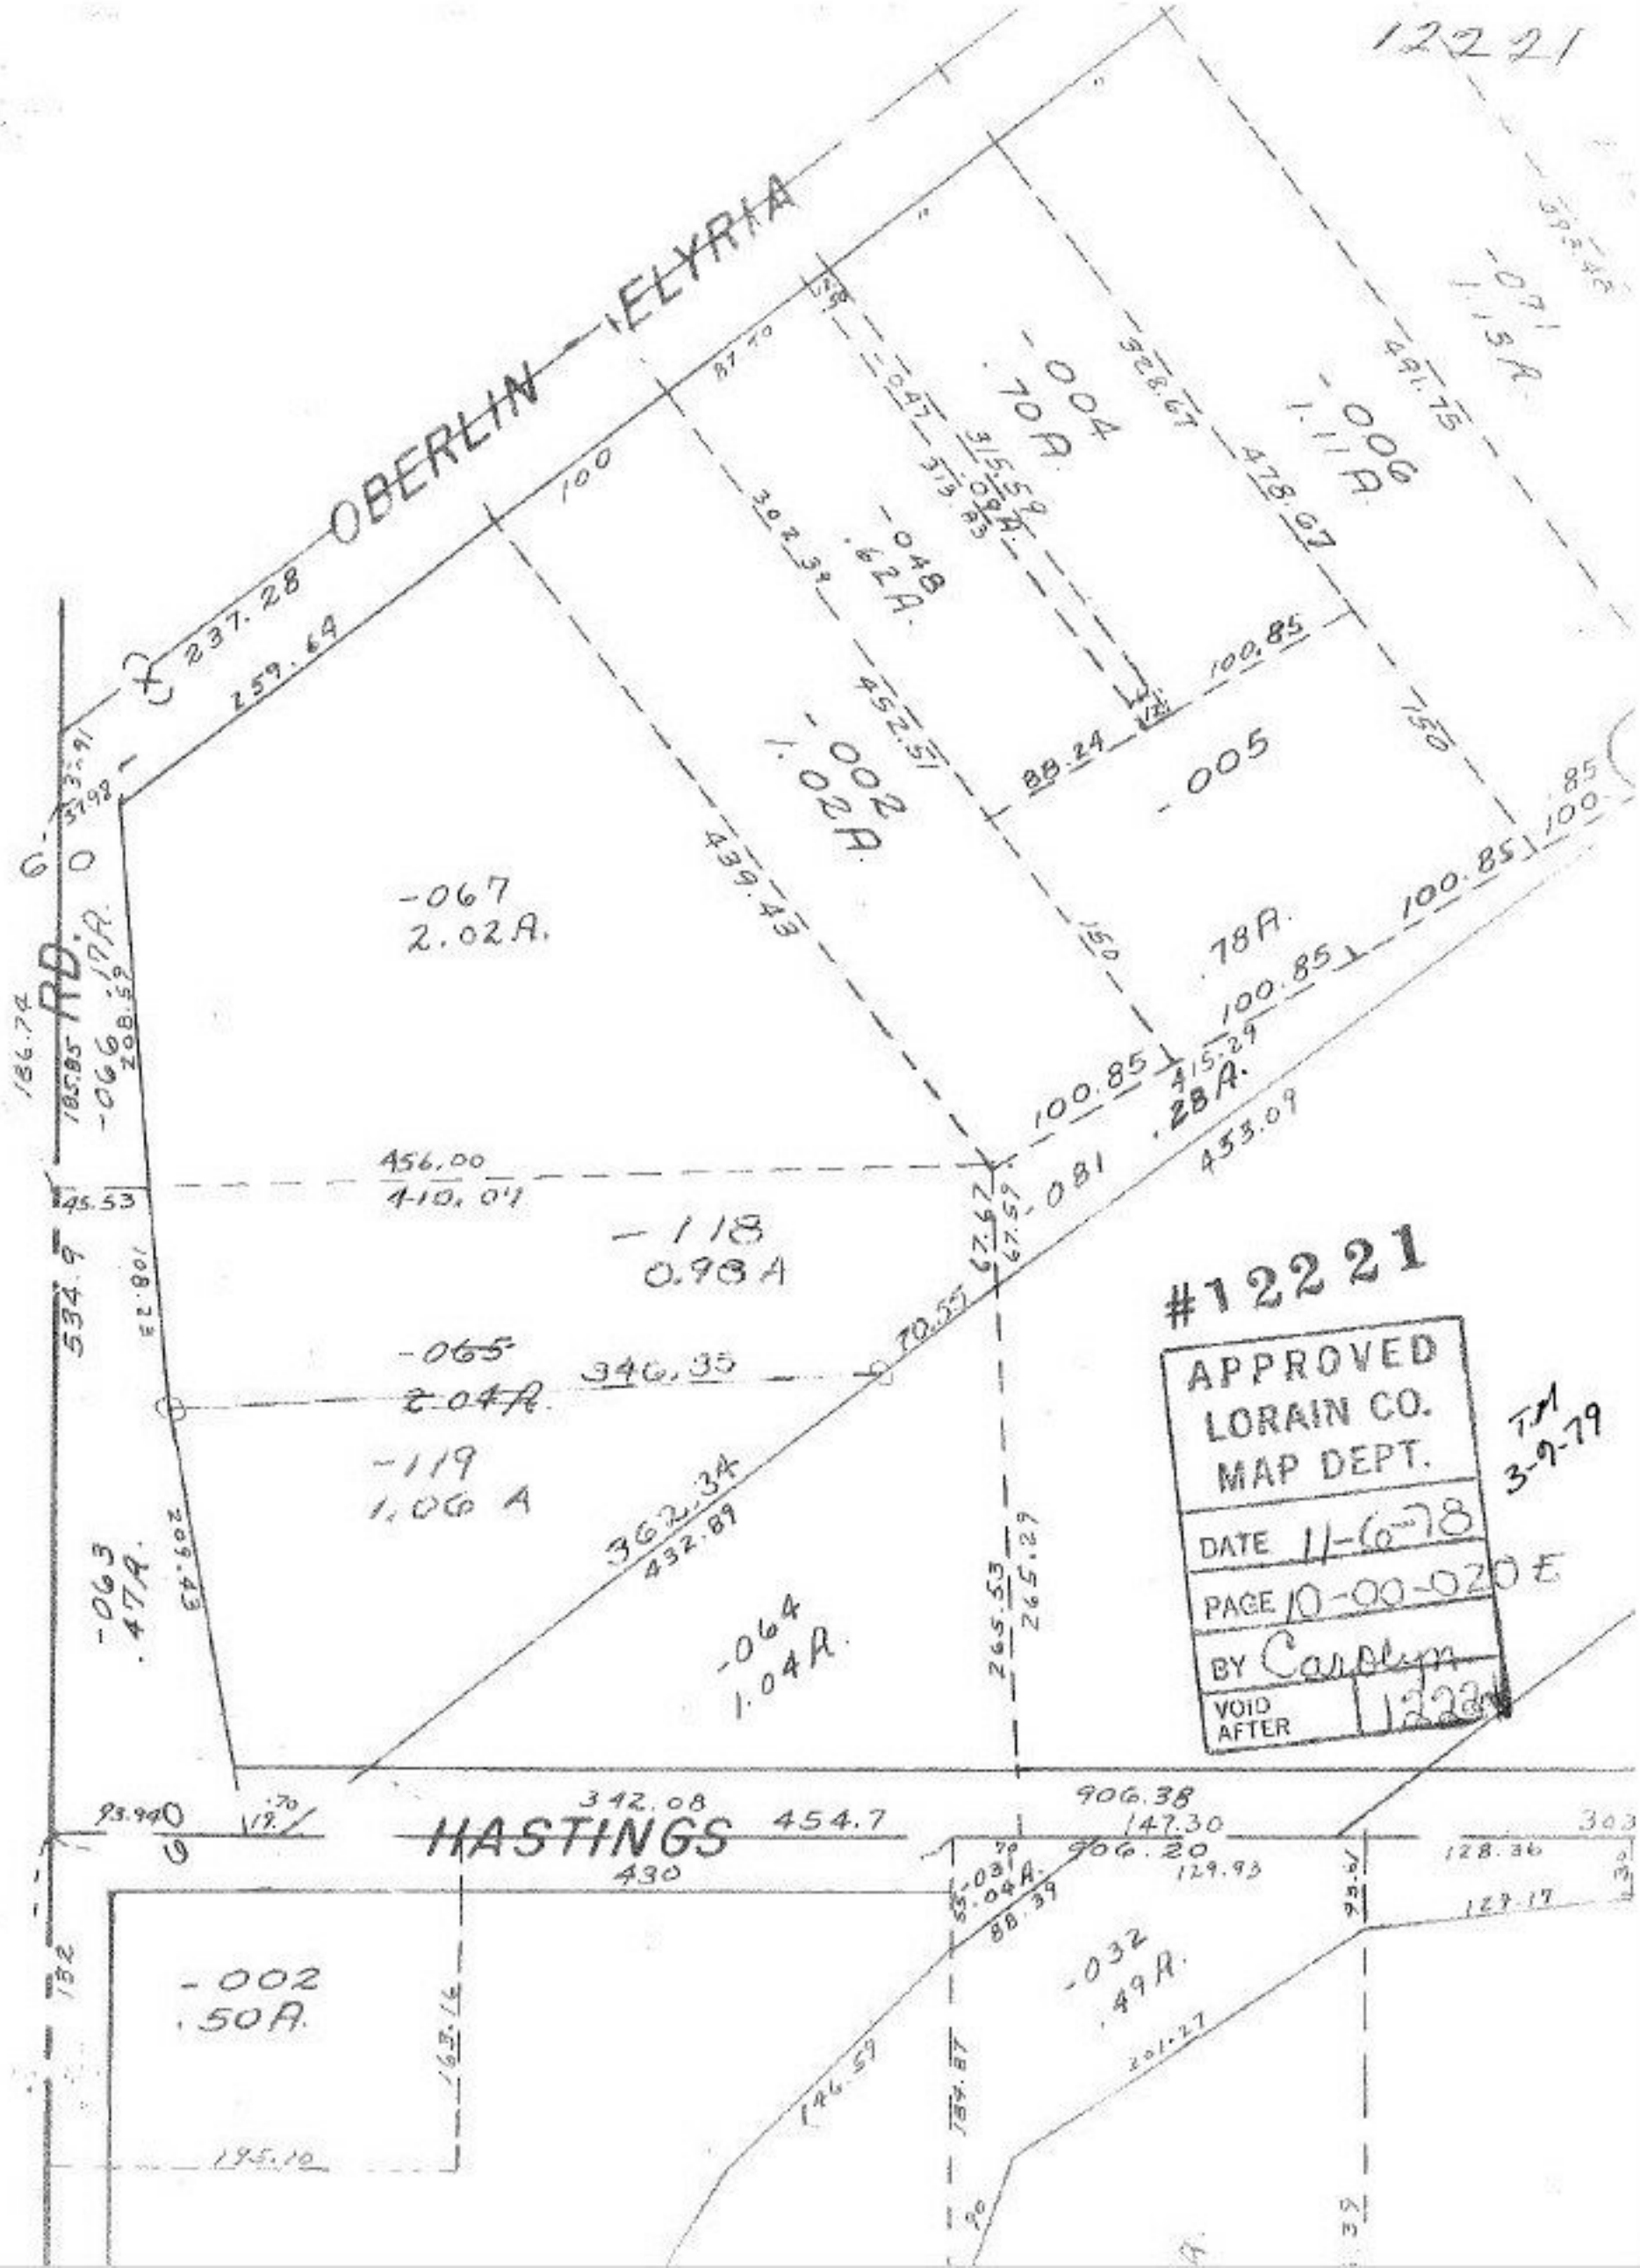

#12221

APPROVED
LORAIN CO.
MAP DEPT.

DATE 11-6-78

PAGE 10-00-020 E

BY Carolyn

VOID AFTER 12221

TM 3-9-79