12223

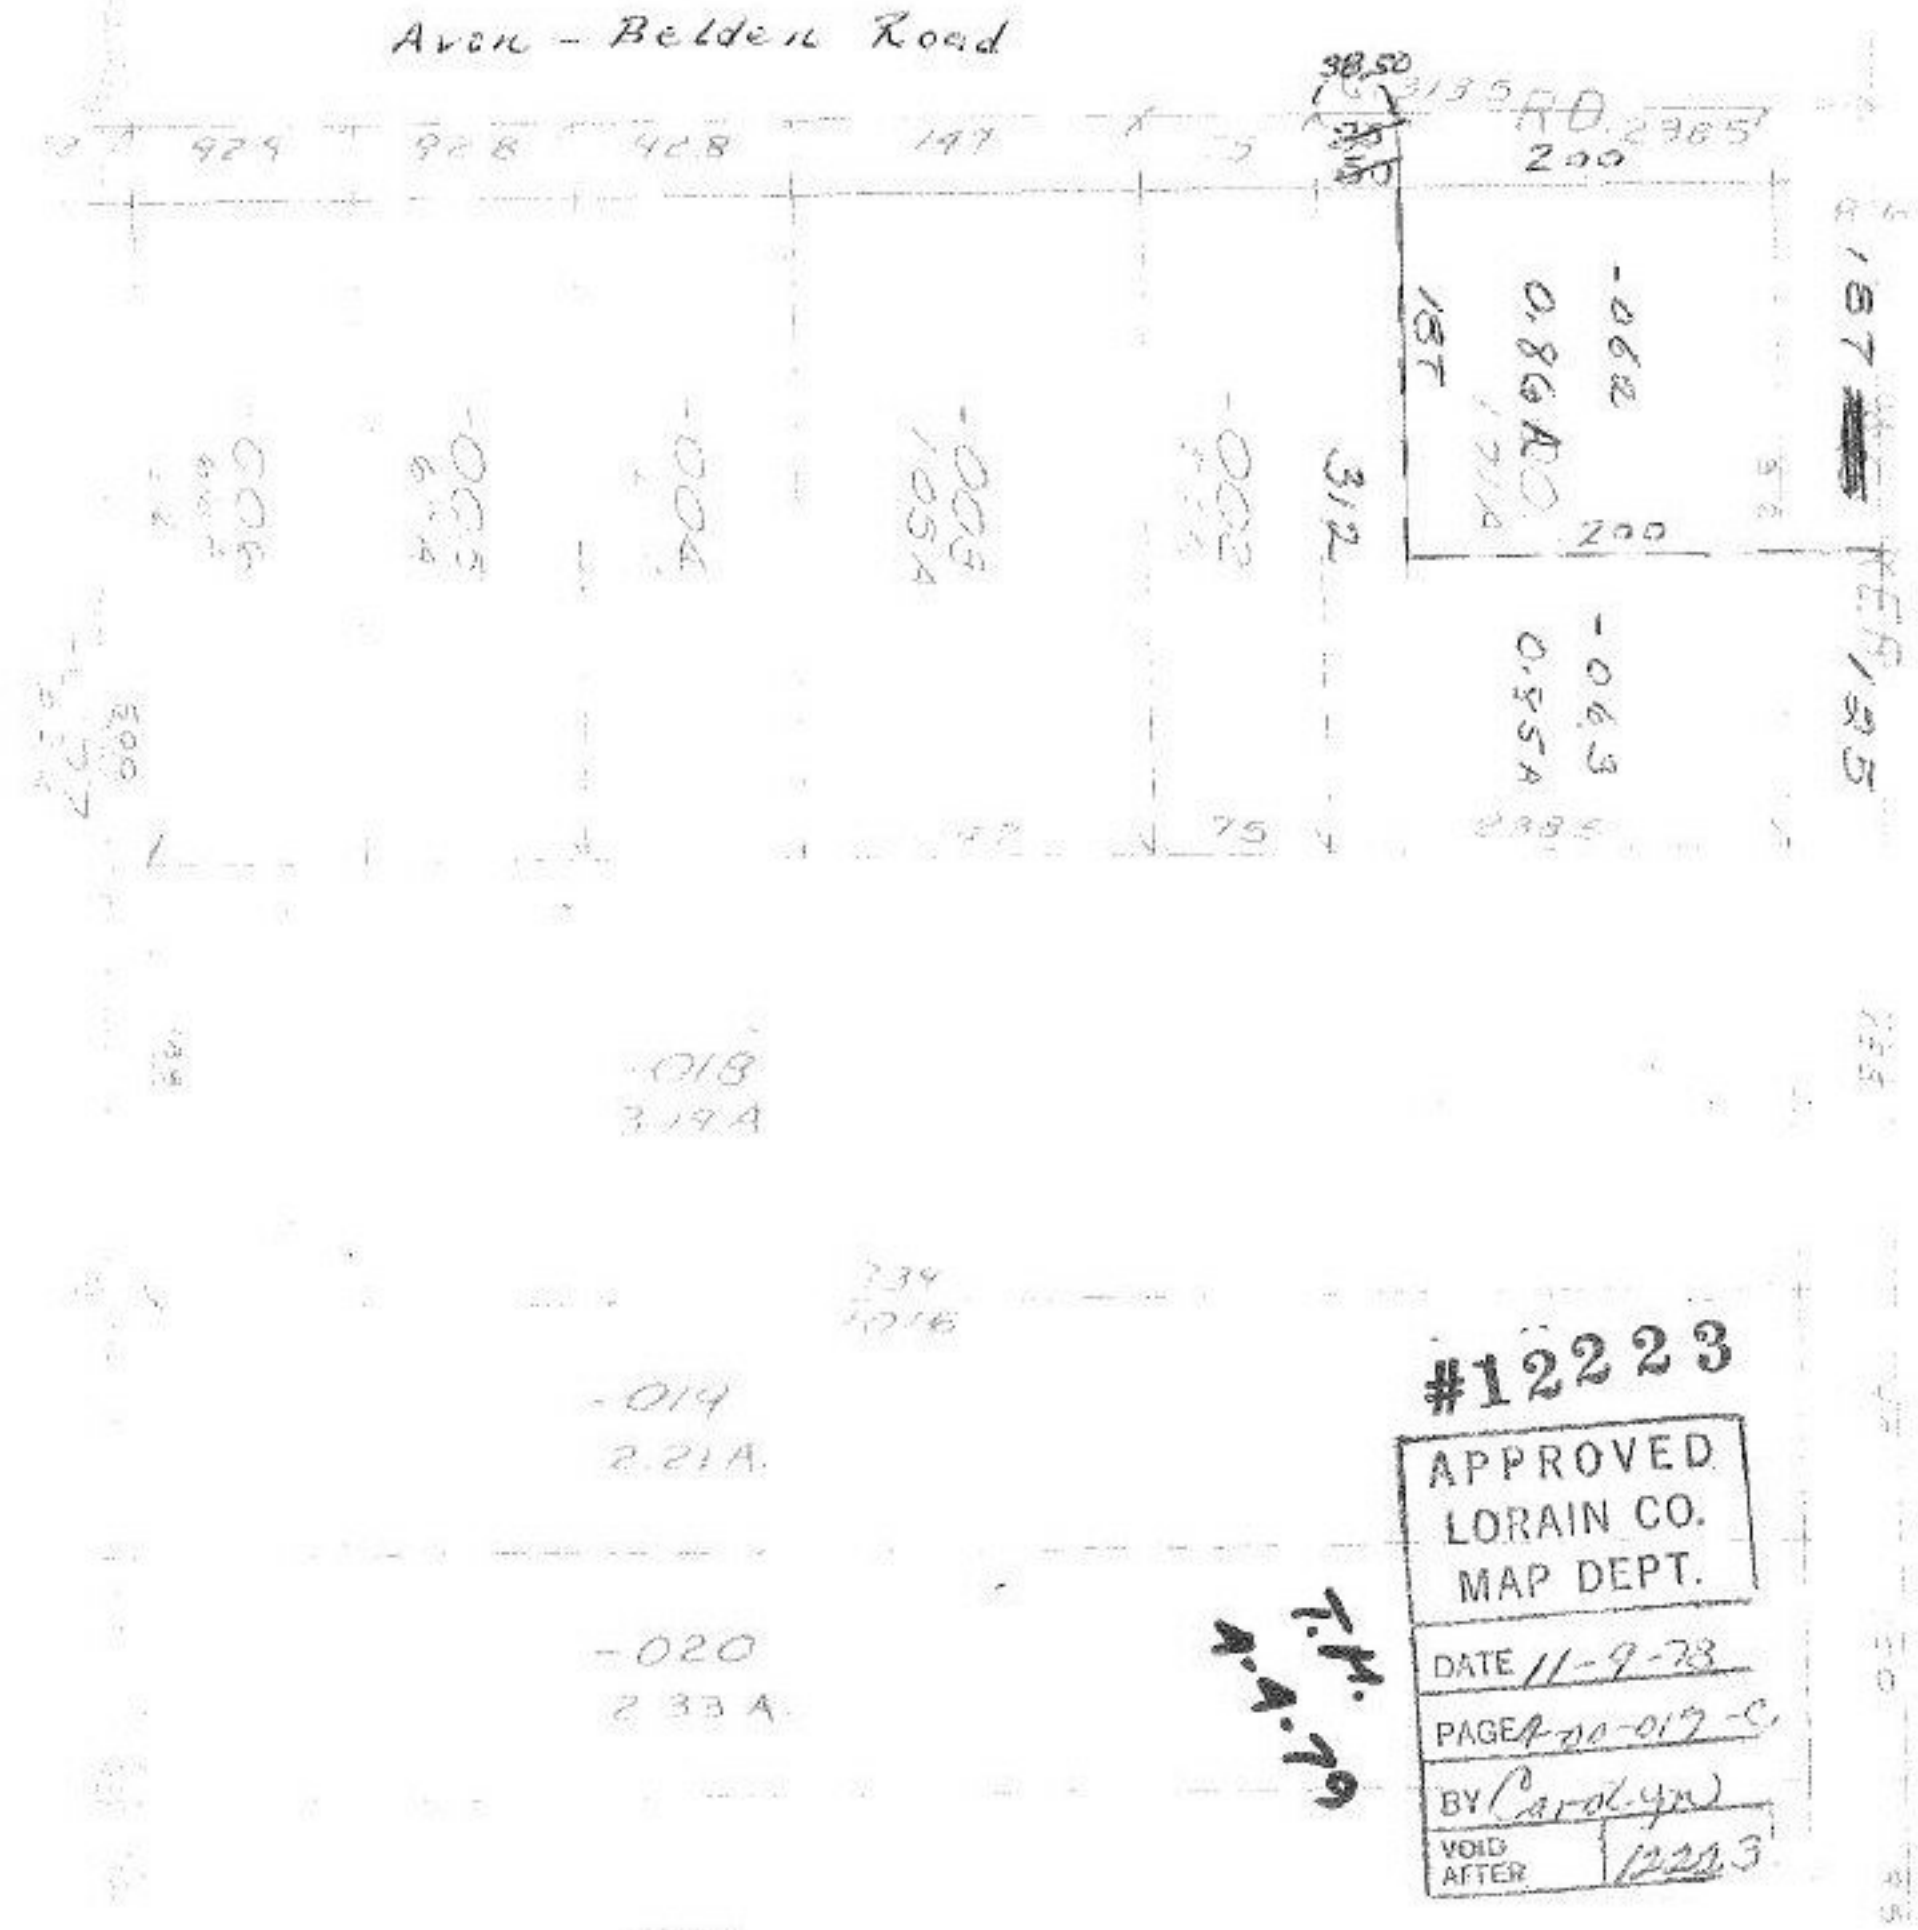

#12223
APPROVED
LORAIN CO.
MAP DEPT.
DATE 11-9-78
PAGE 4-00-017-C
BY Carolyn
VOID AFTER 12223

T.M.
4-4-79