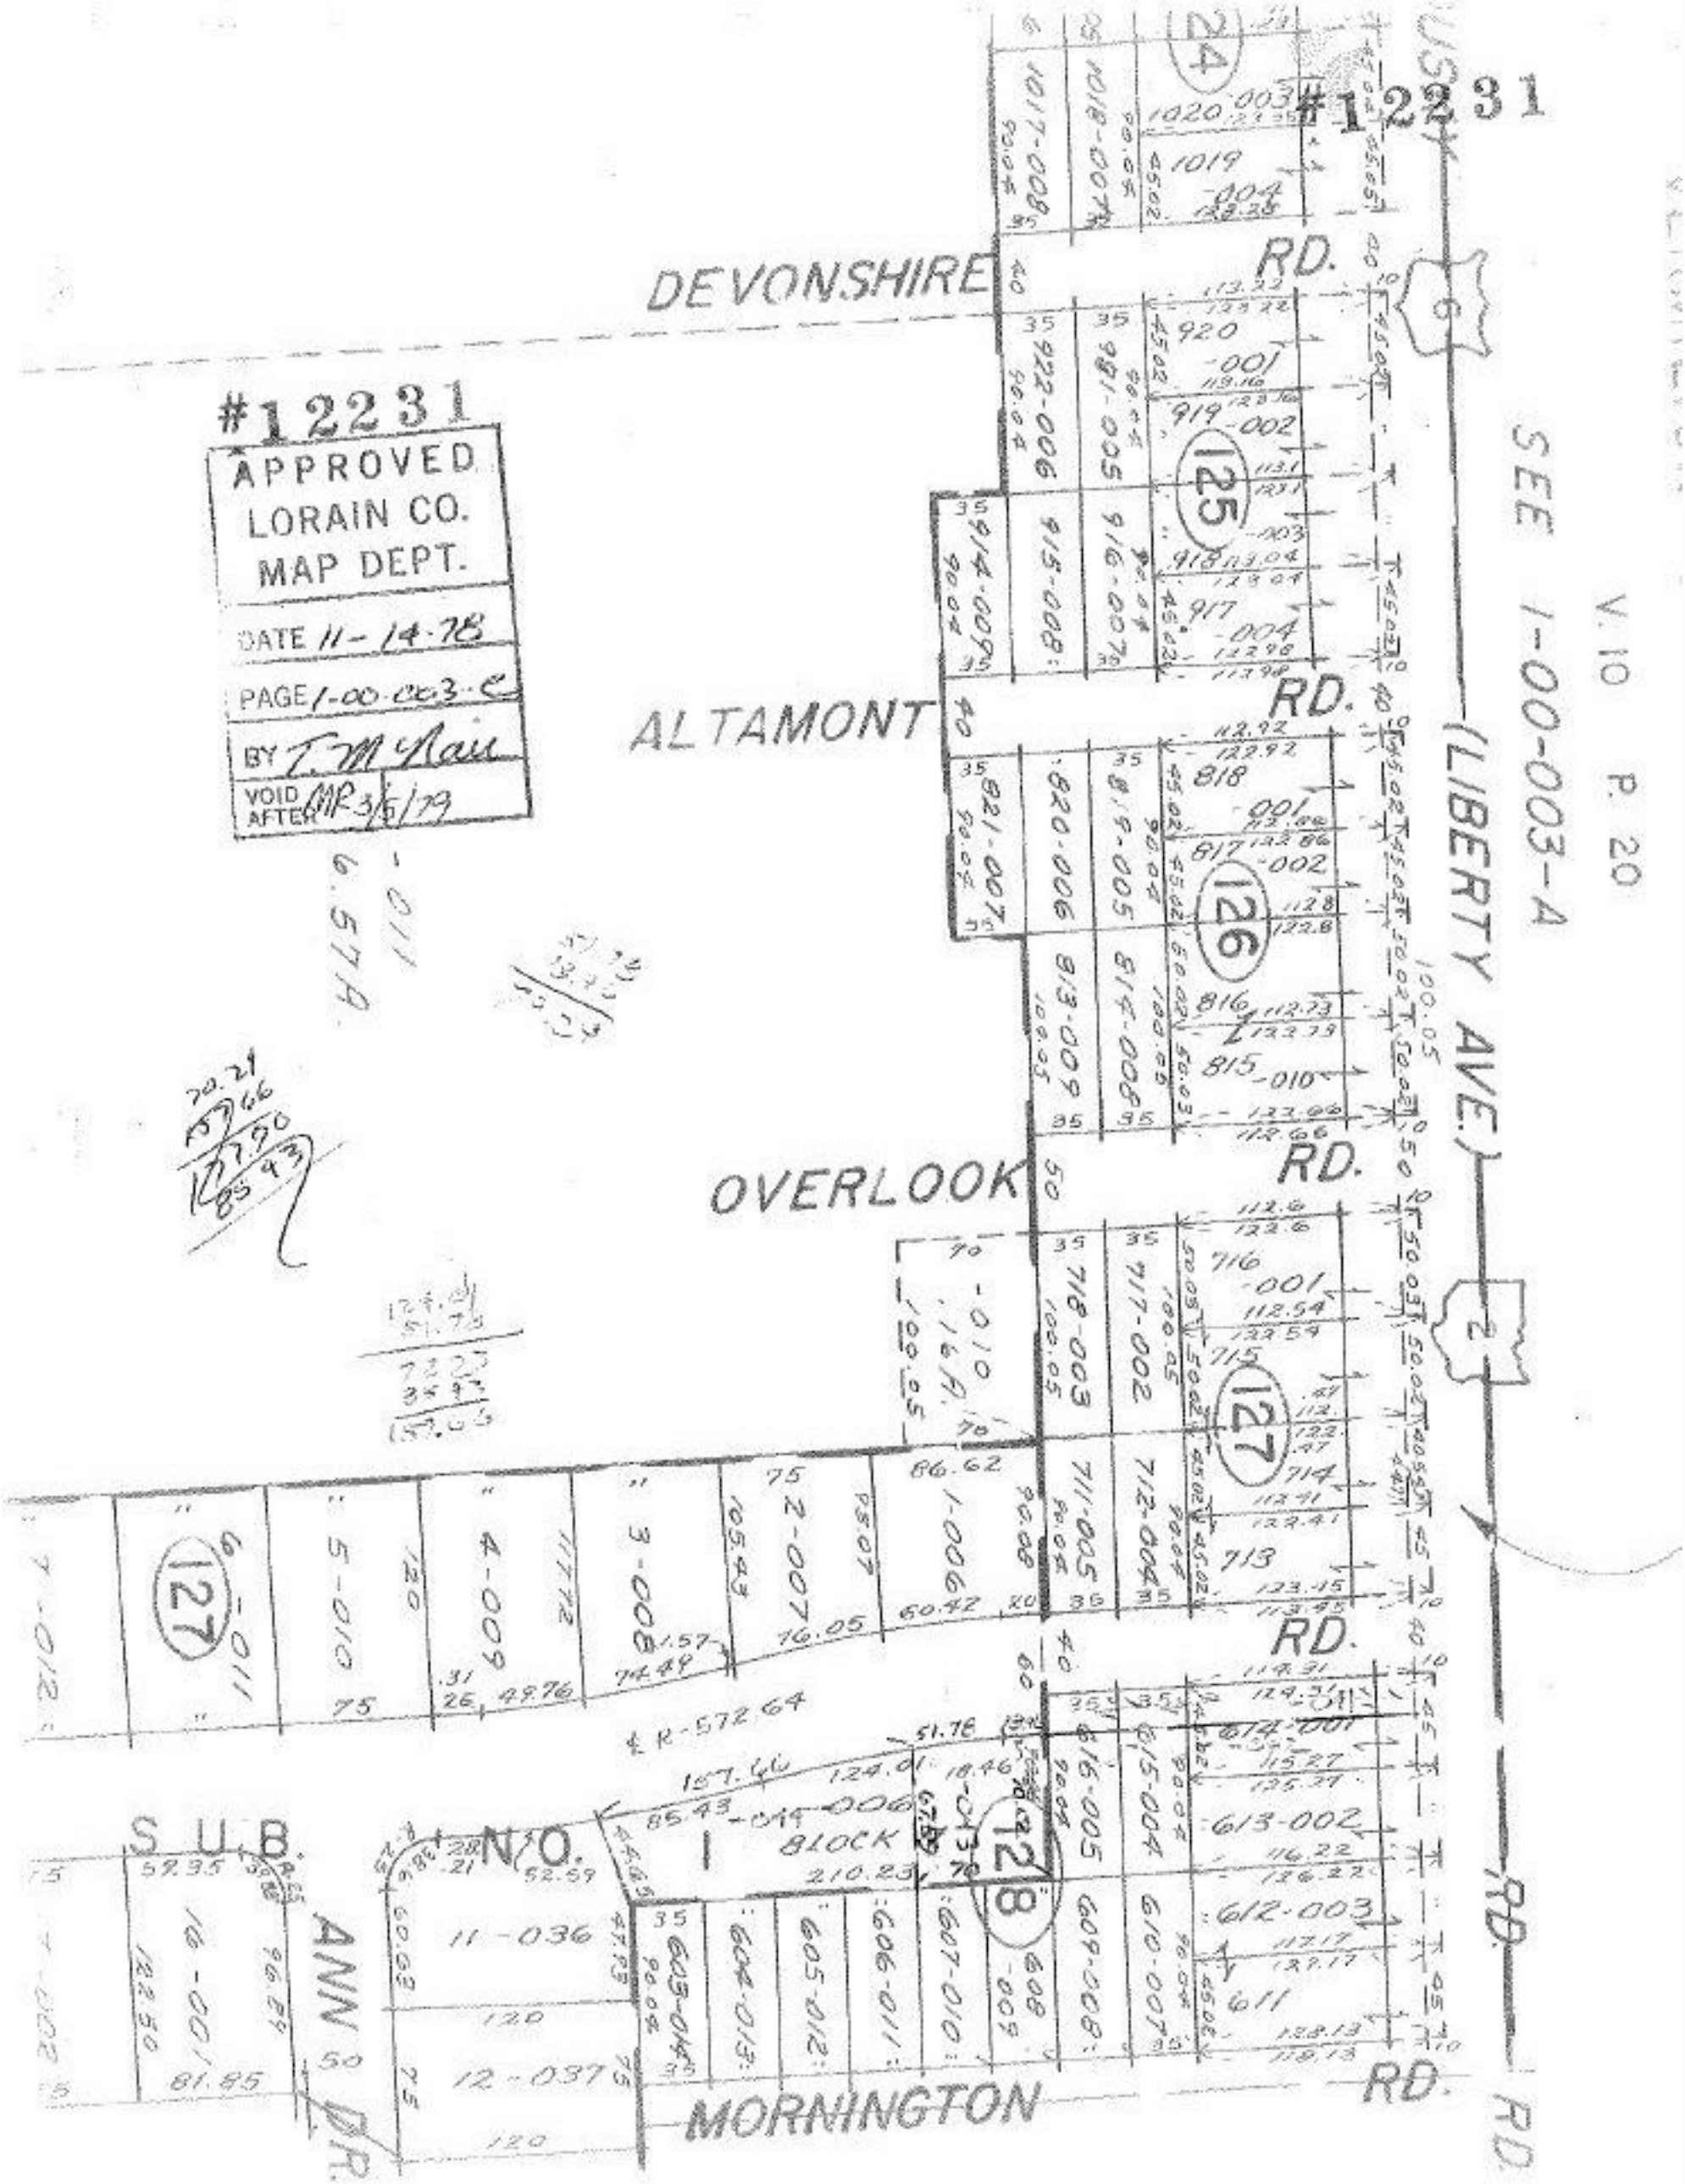

#12231
APPROVED
LORAIN CO.
MAP DEPT.
DATE 11-14-78
PAGE 1-00-003-C
BY T. McNair
VOID AFTER MR 3/5/79
#12231
DEVONSHIRE RD.
ALTAMONT RD.
OVERLOOK RD.
MORNINGTON RD.
SEE 1-00-003-A
(LIBERTY AVE.)
V. 10 P. 20
S.U.B. NO. 1
ANN DR.
BLOCK