#12234

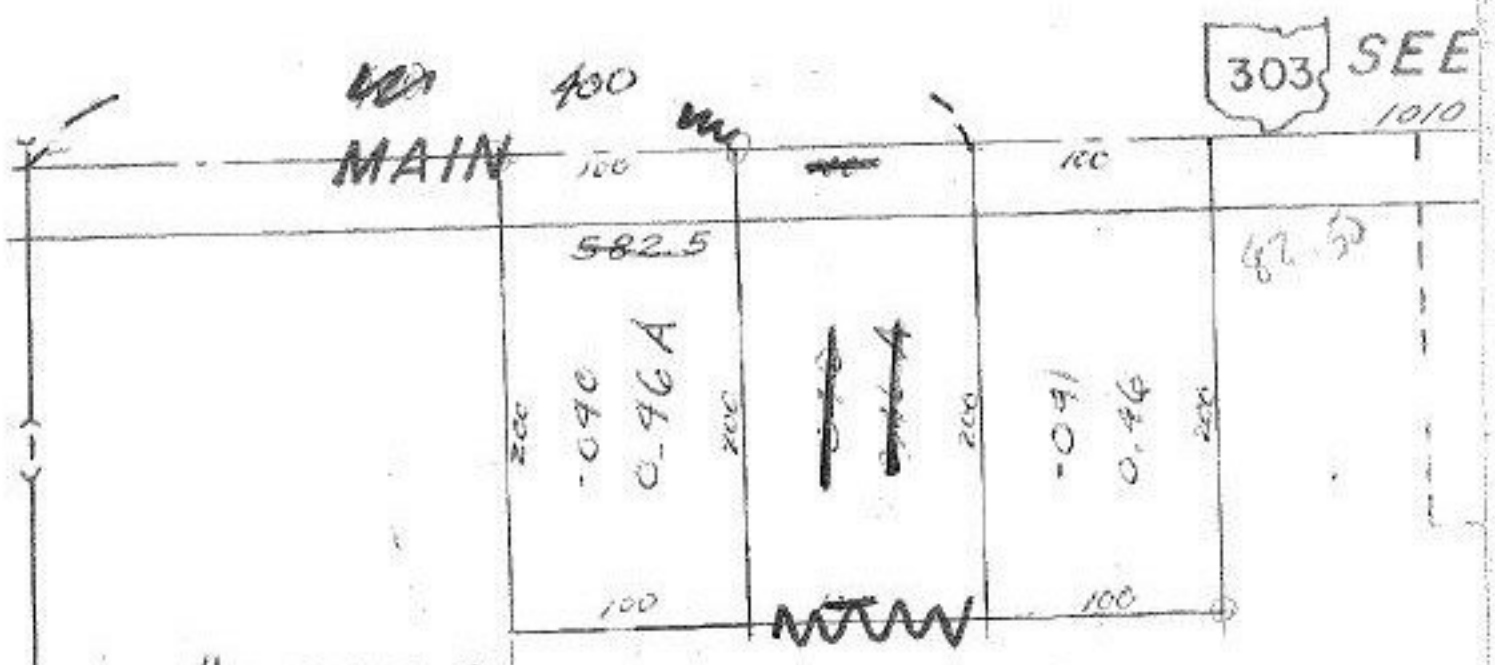

#12234

APPROVED
LORAIN CO.
MAP DEPT.
DATE 11-14-78
PAGE 15-00-56
BY T. McNair
VOID AFTER

MAR 9 1979

~~-001~~ -042

~~60.15A~~ 59.23A

46