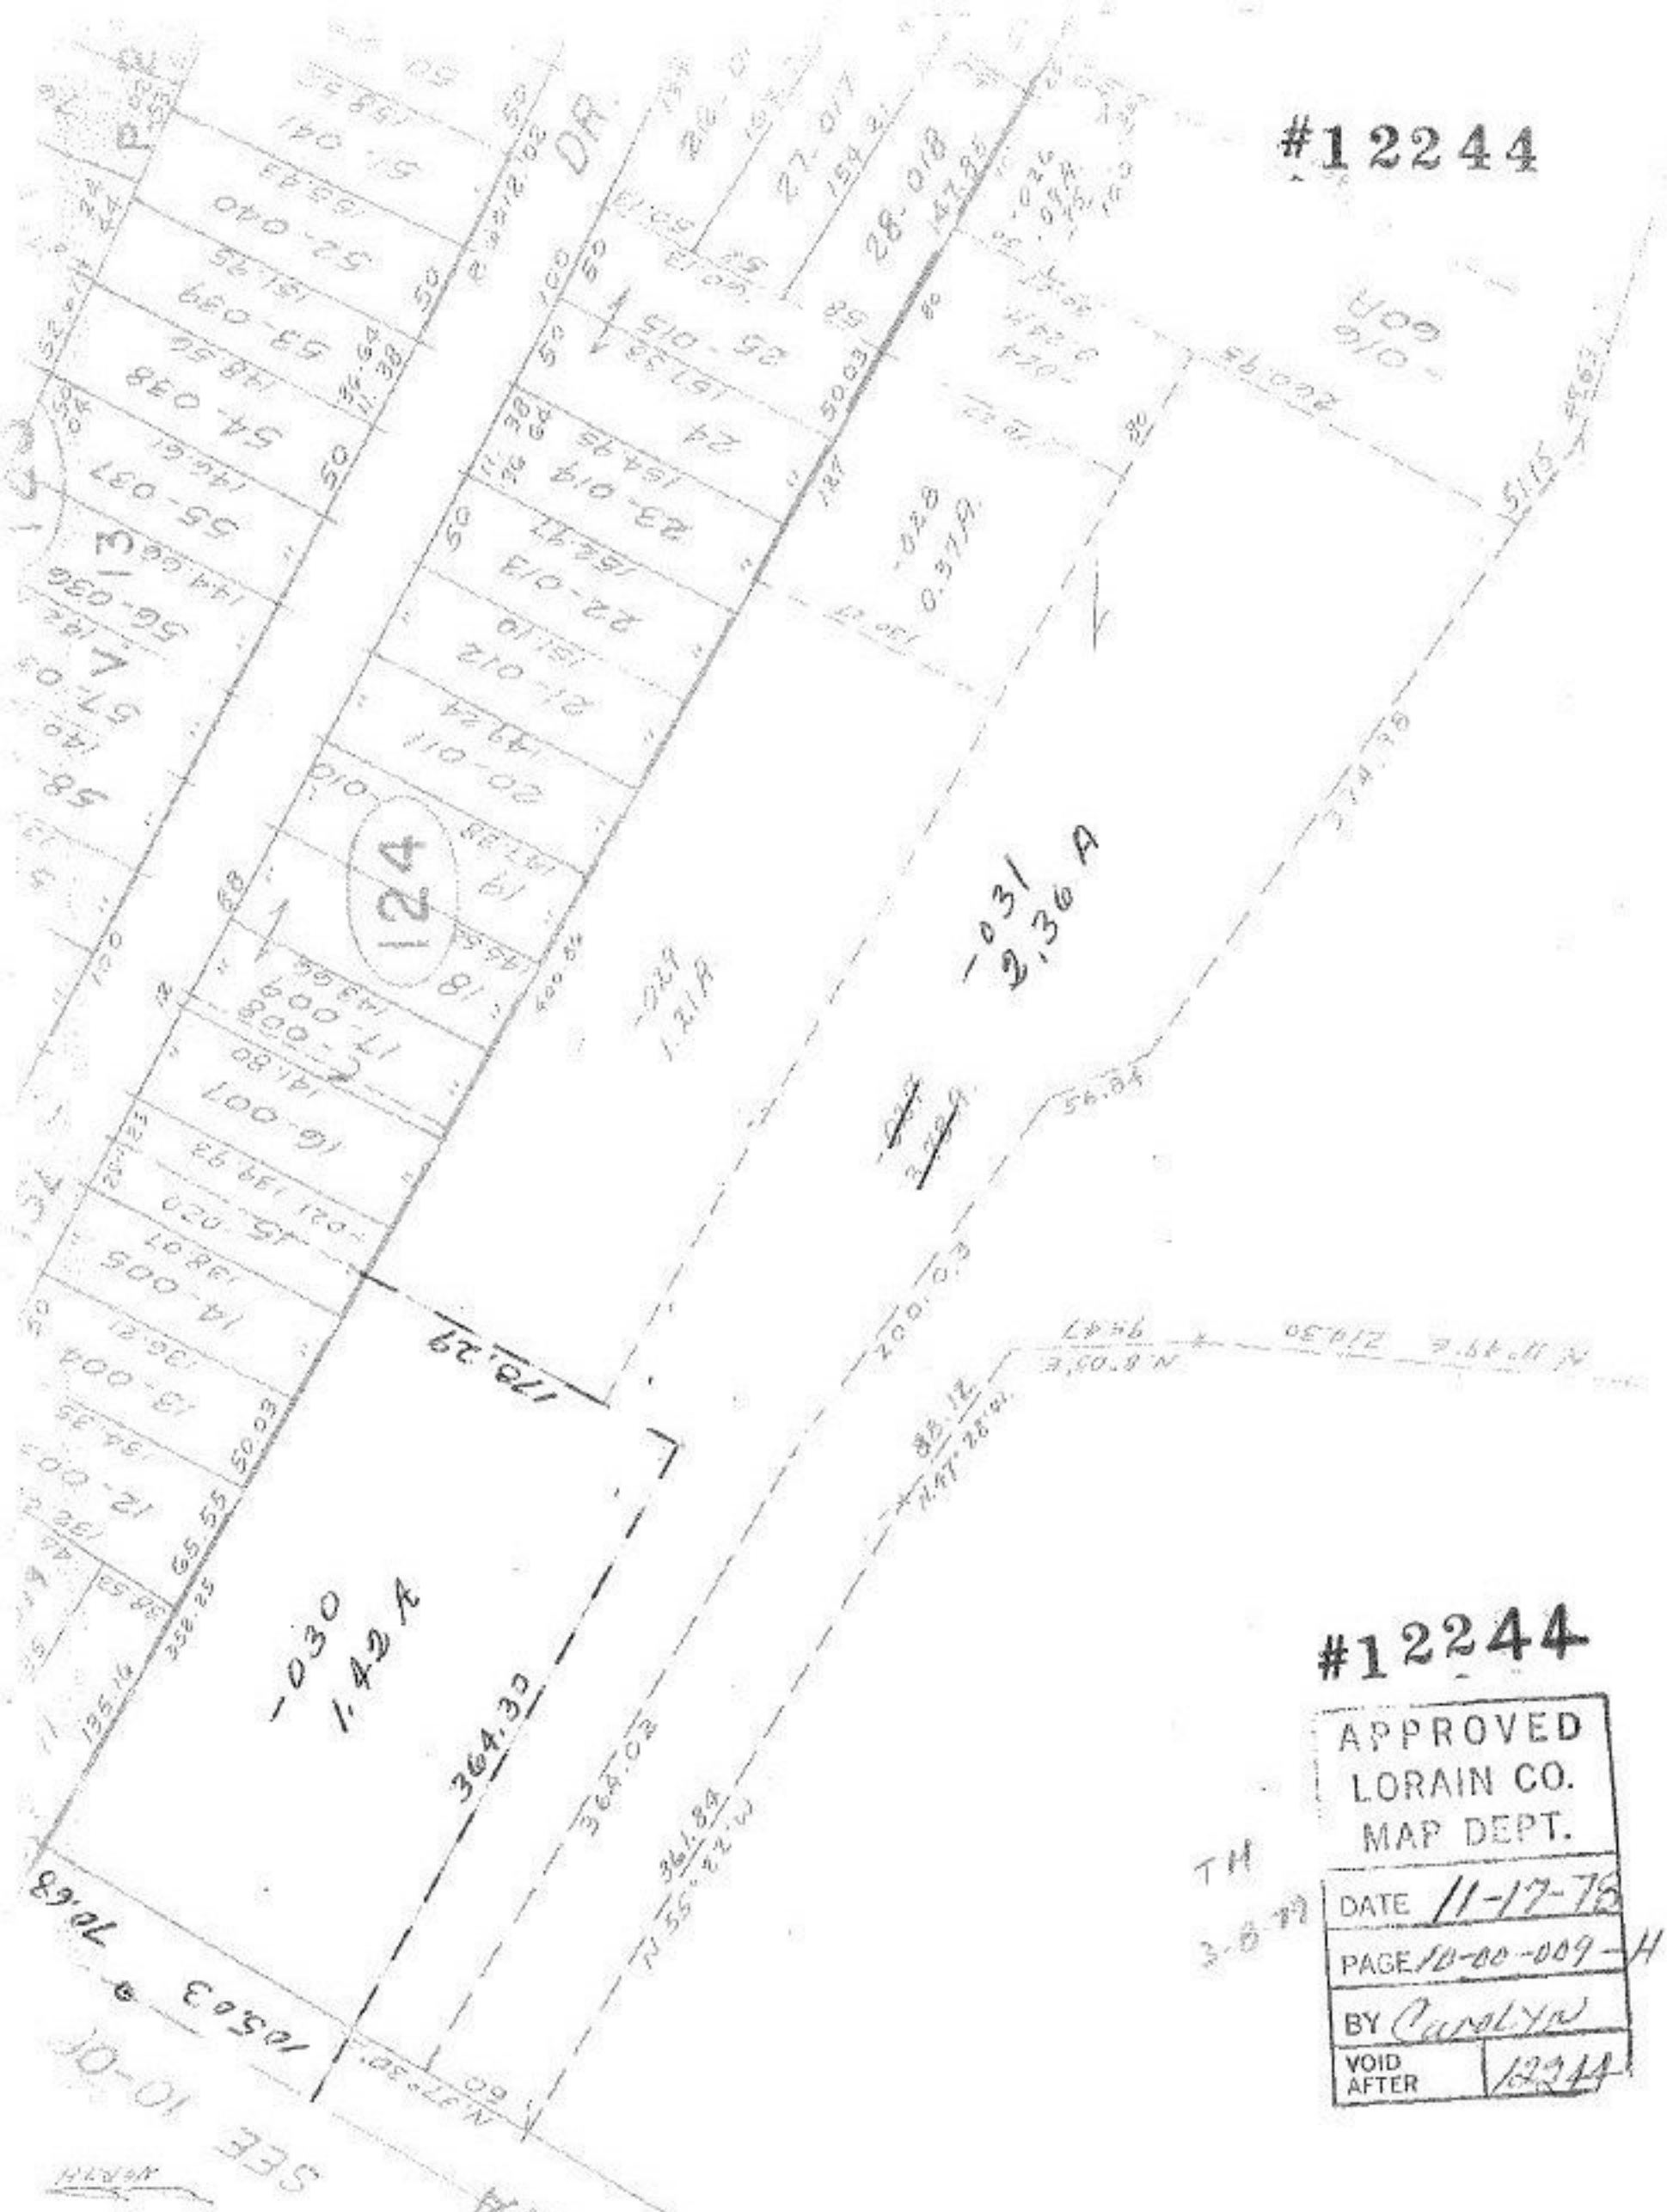
#12244
-031
2.36 A
-030
1.42 A
364.30
178.29
105.03
70.68
SEE 10-OF
#12244
APPROVED
LORAIN CO.
MAP DEPT.
DATE 11-17-78
PAGE 10-00-009-H
BY Carolyn
VOID AFTER 12244