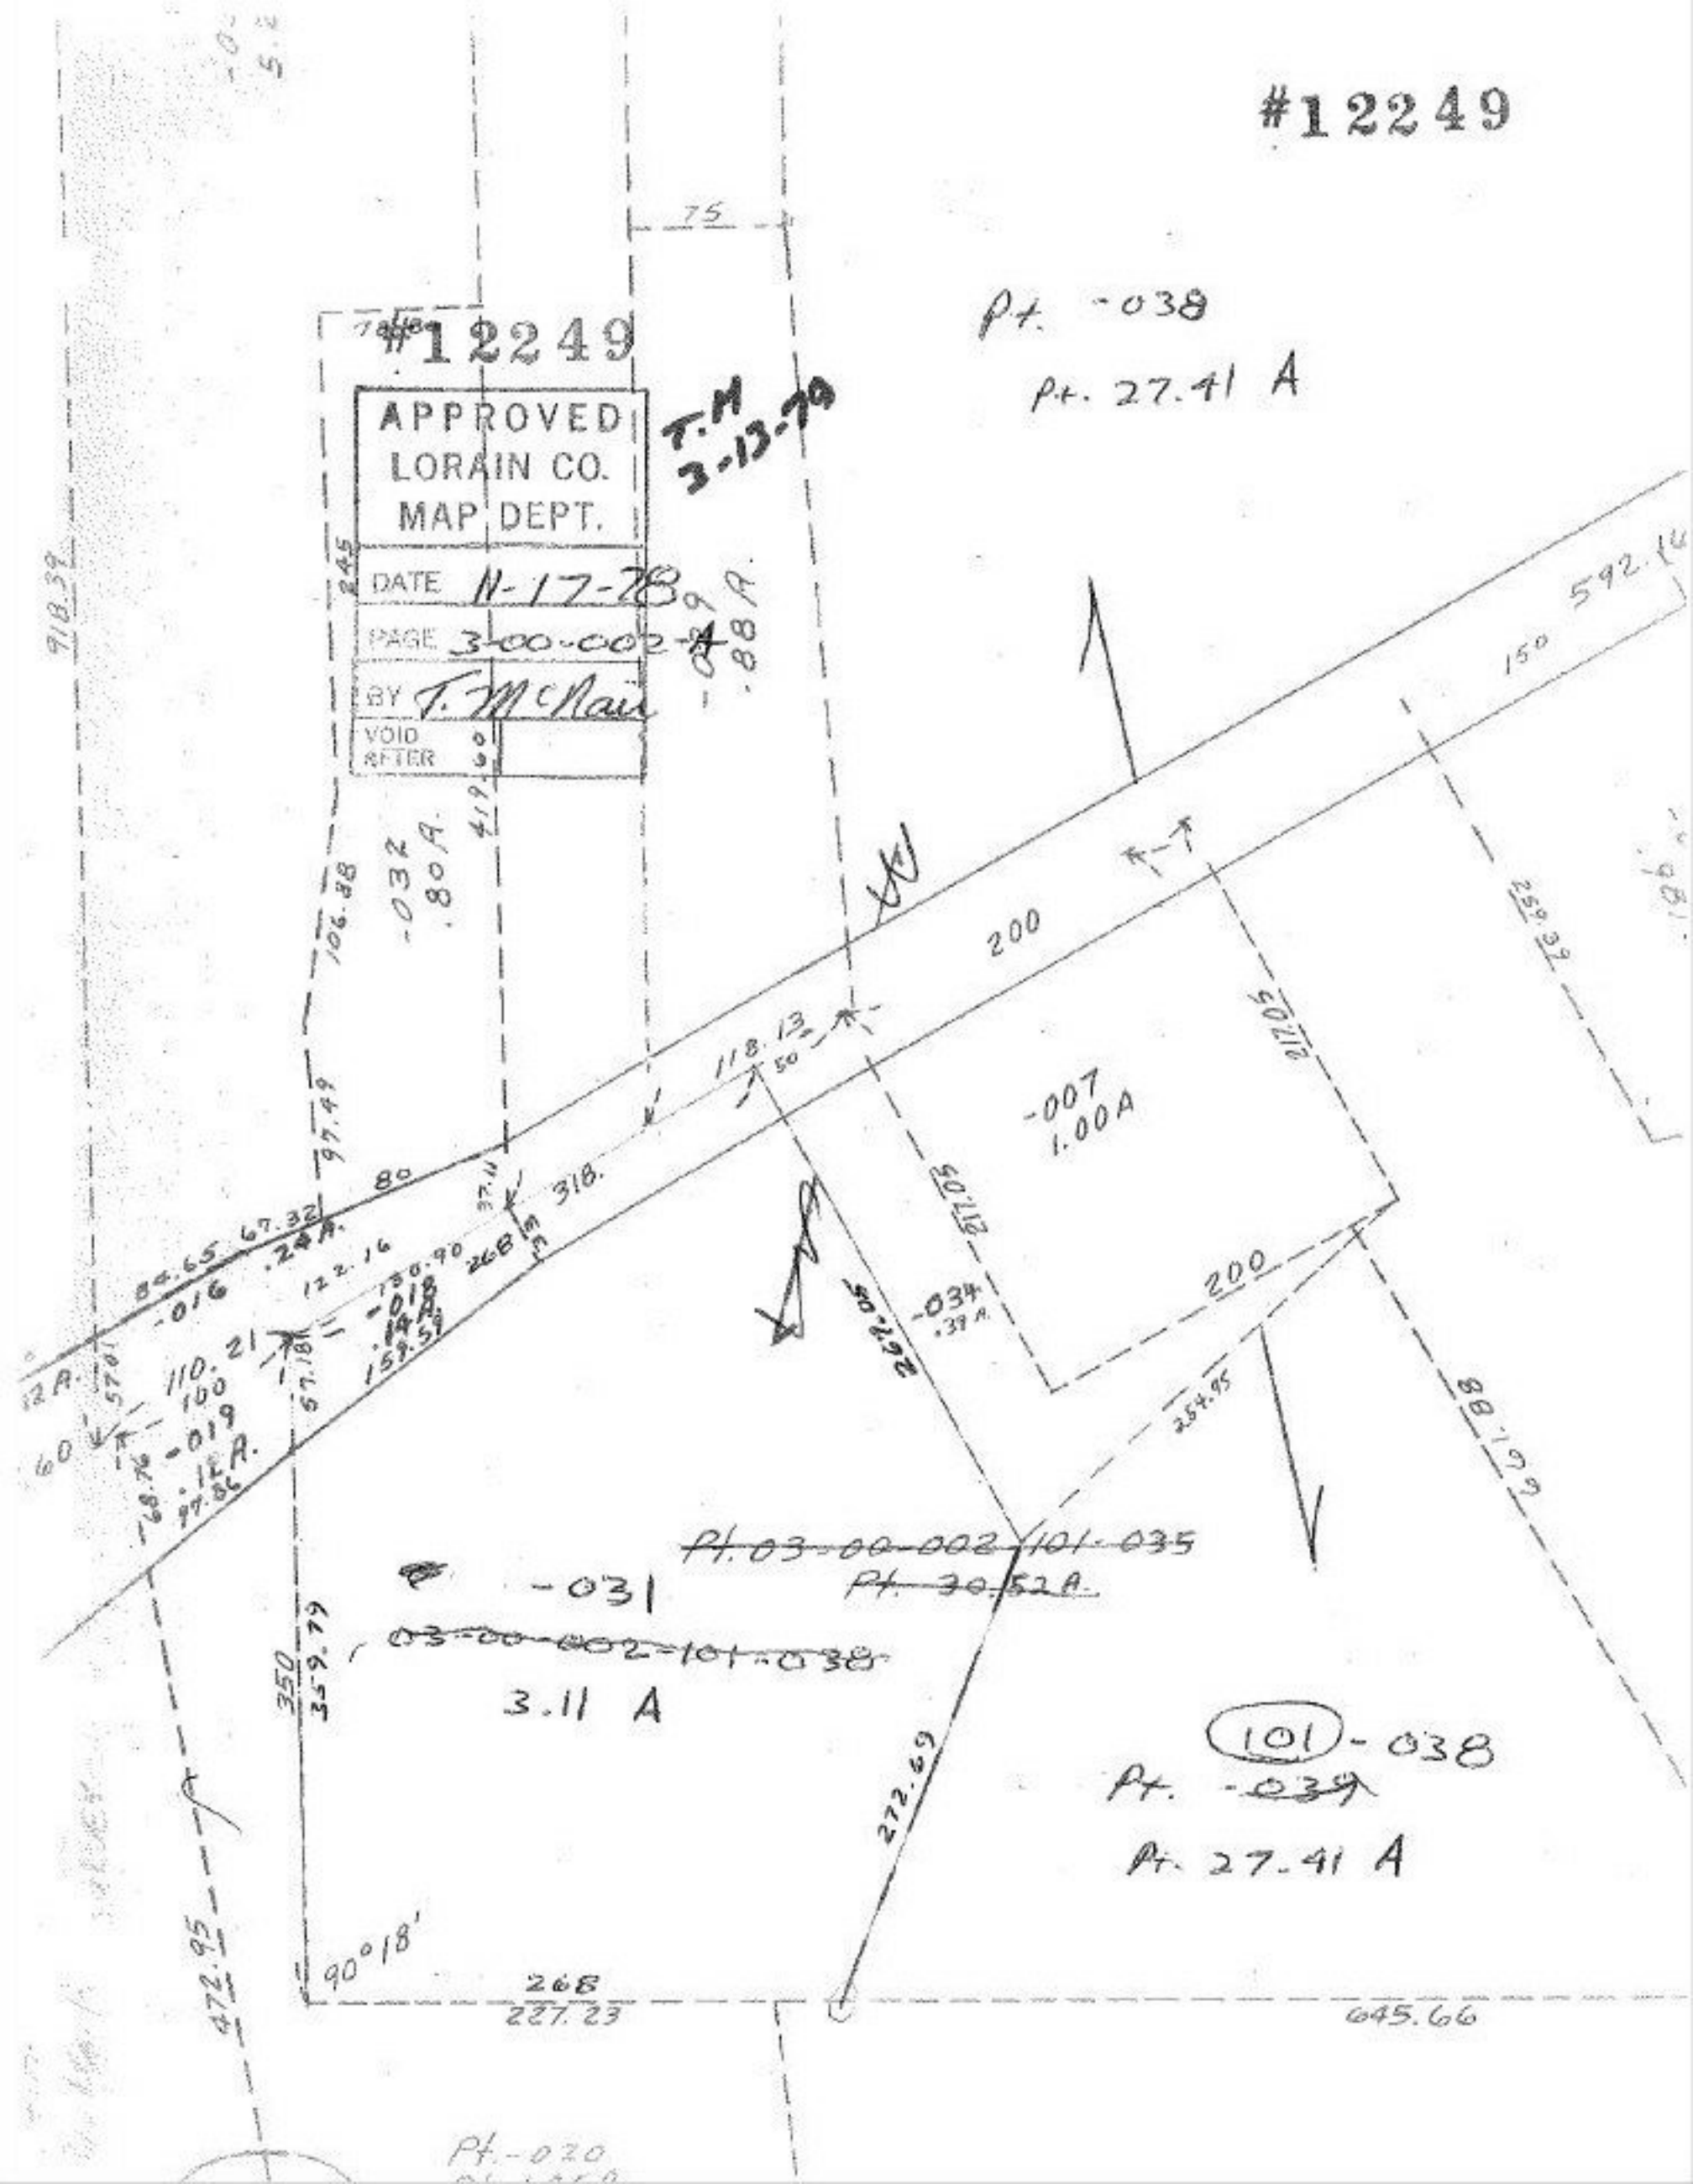
#12249
#12249
APPROVED
LORAIN CO.
MAP DEPT.
DATE 11-17-78
PAGE 3-00-002-A
BY T. McNair
VOID AFTER
T.M 3-13-79
Pt. -038
Pt. 27.41 A
-032 .80 A.
-007 1.00 A
-034 .39 A.
-031
~~03-00-002-101-038~~
3.11 A
~~Pt. 03-00-002-101-035~~
~~Pt. 30.52 A.~~
101 -038
Pt. ~~-039~~
Pt. 27.41 A
Pt. -020
200
200
318.
268
227.23
645.66
90°18'
472.95
350
359.79
272.69
254.95
217.05
259.39
592.16
918.39
106.88
97.49
118.13
84.65
67.32
.24 A.
-016
122.16
110.21
100
-019
.12 A.
-018
.14 A.
159.59
-088 A.
-089
75