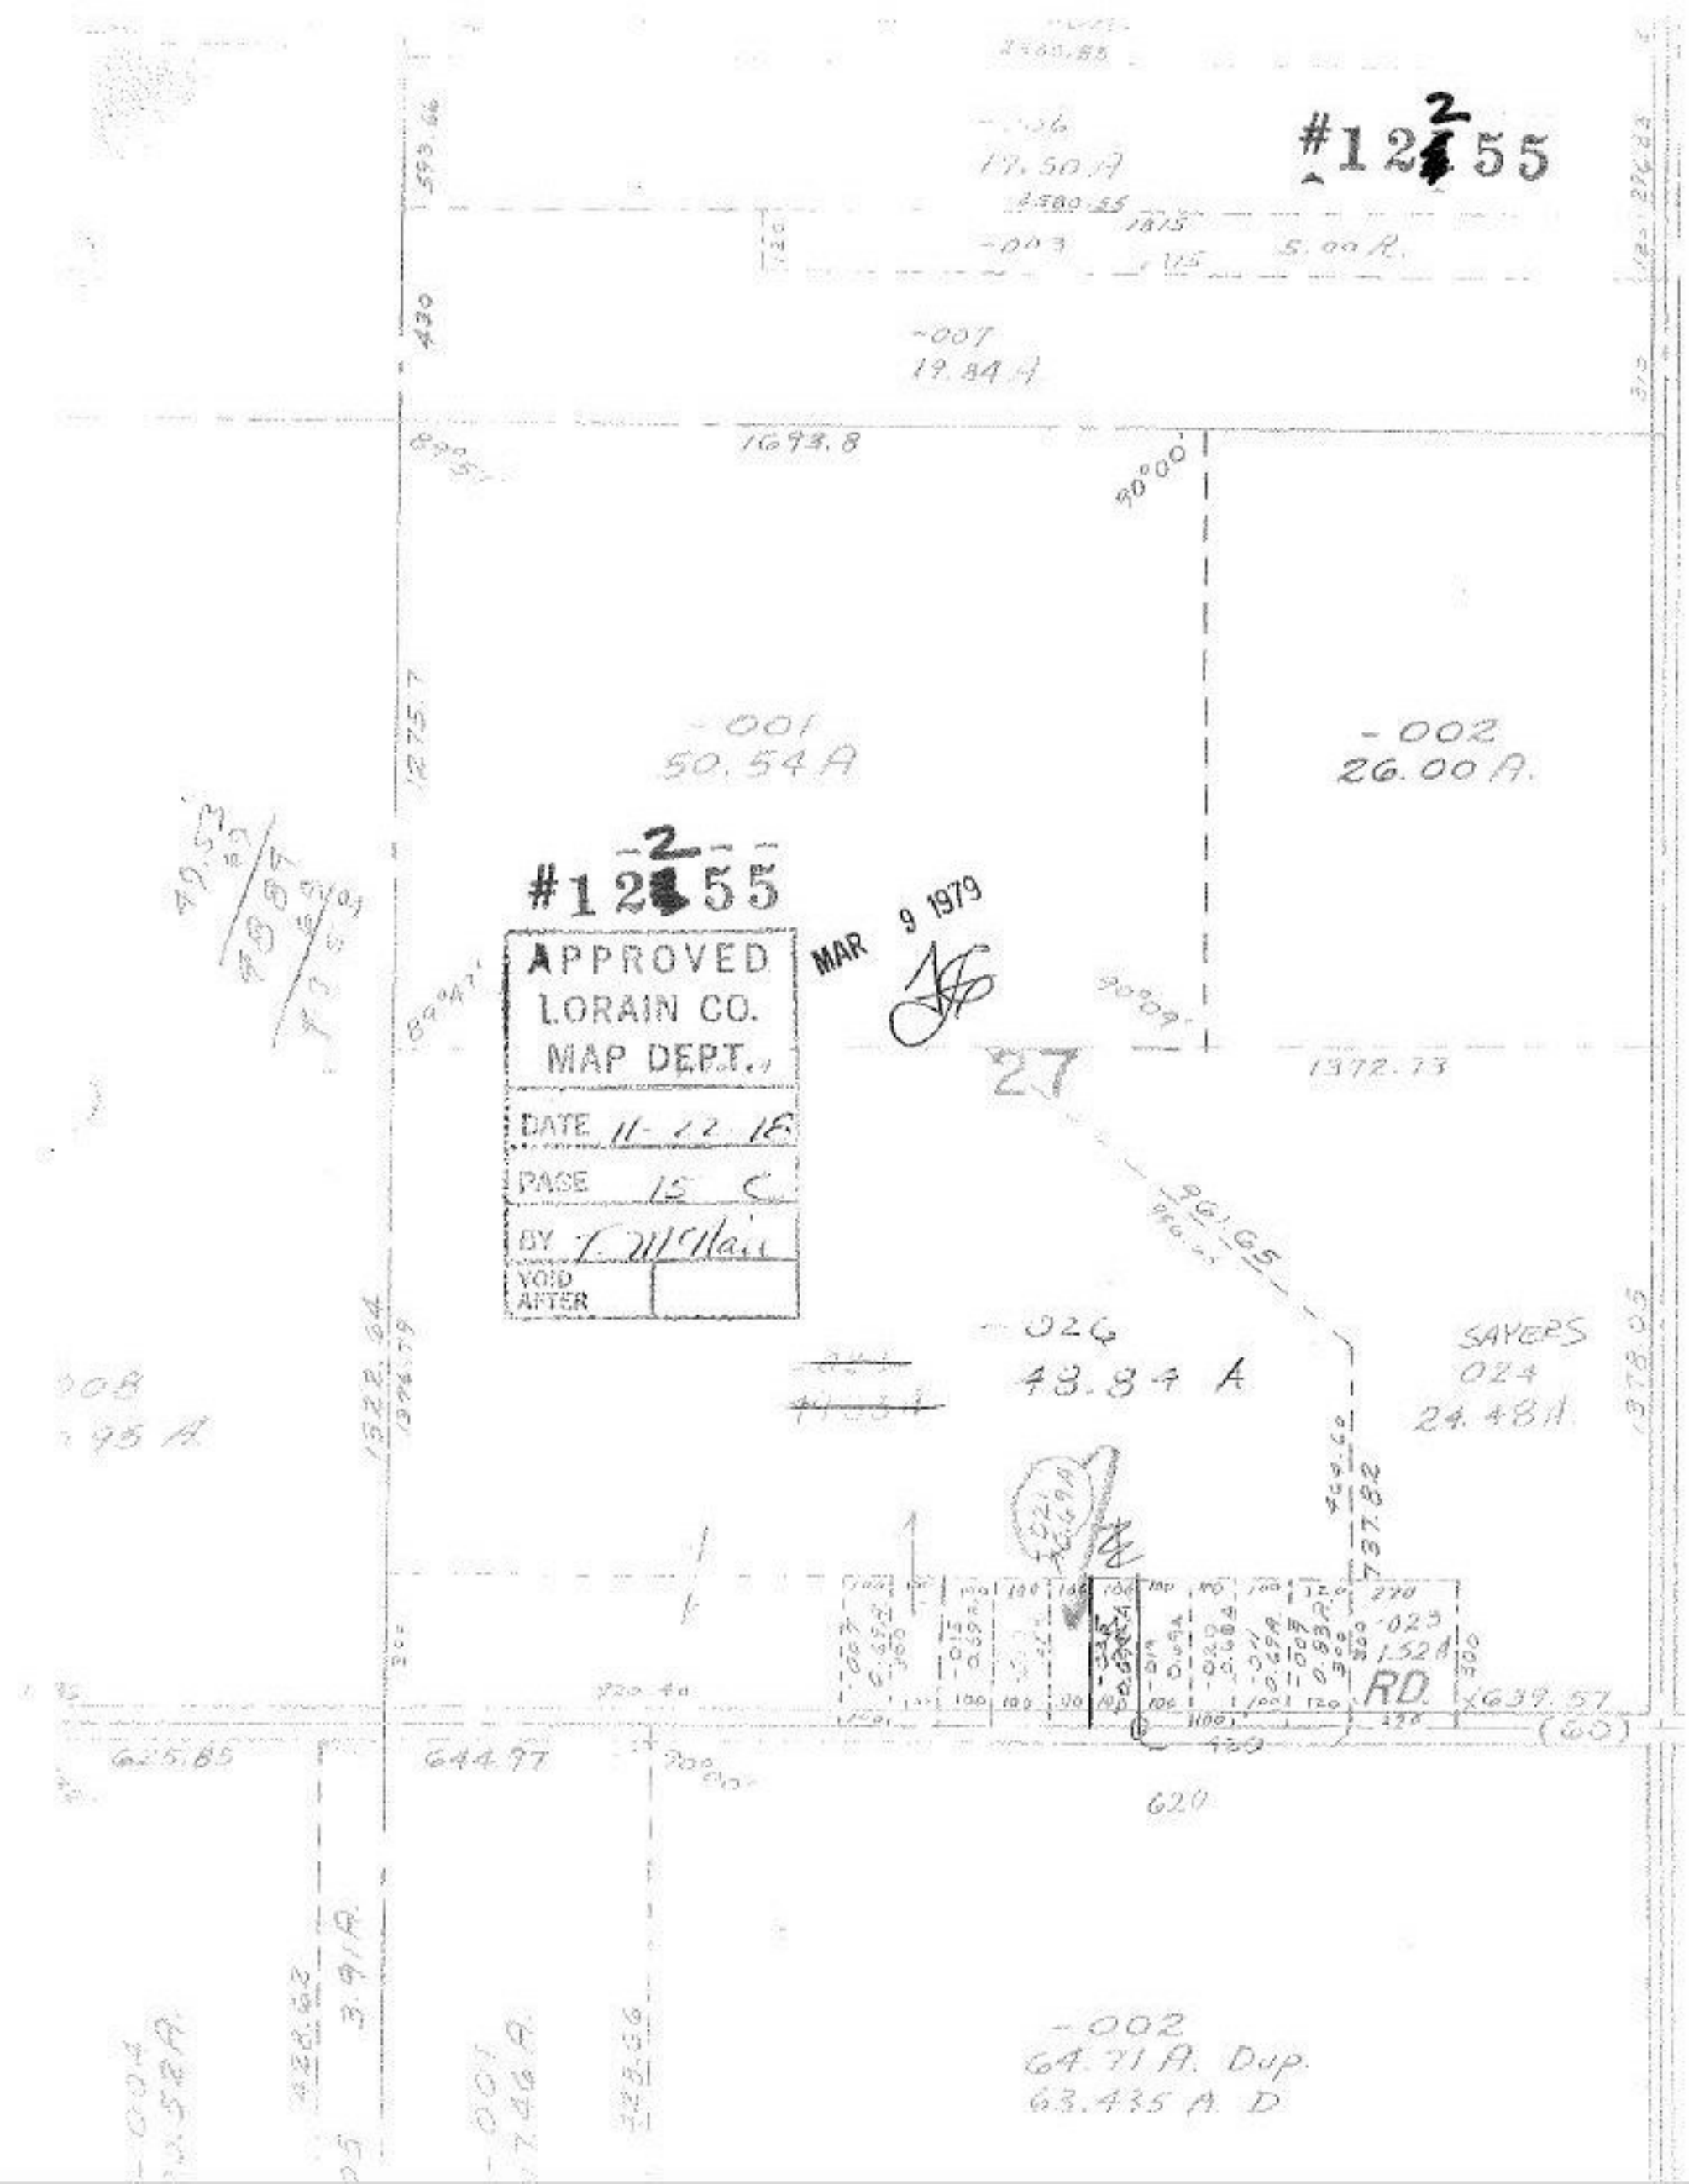

#12255
17.50 A
5.00 A.
-007
19.84 A
1693.8
90°00'
-001
50.54 A
-002
26.00 A.
#12255
APPROVED
LORAIN CO.
MAP DEPT.
DATE 11-22-18
PAGE 15 C
BY T. McNair
VOID AFTER
MAR 9 1979
27
1372.73
961.65
-026
48.84 A
SAYERS
024
24.48 A
737.82
-023
1.52 A
RD.
639.57
(60)
625.85
644.97
620
-002
64.71 A. Dup.
63.435 A. D