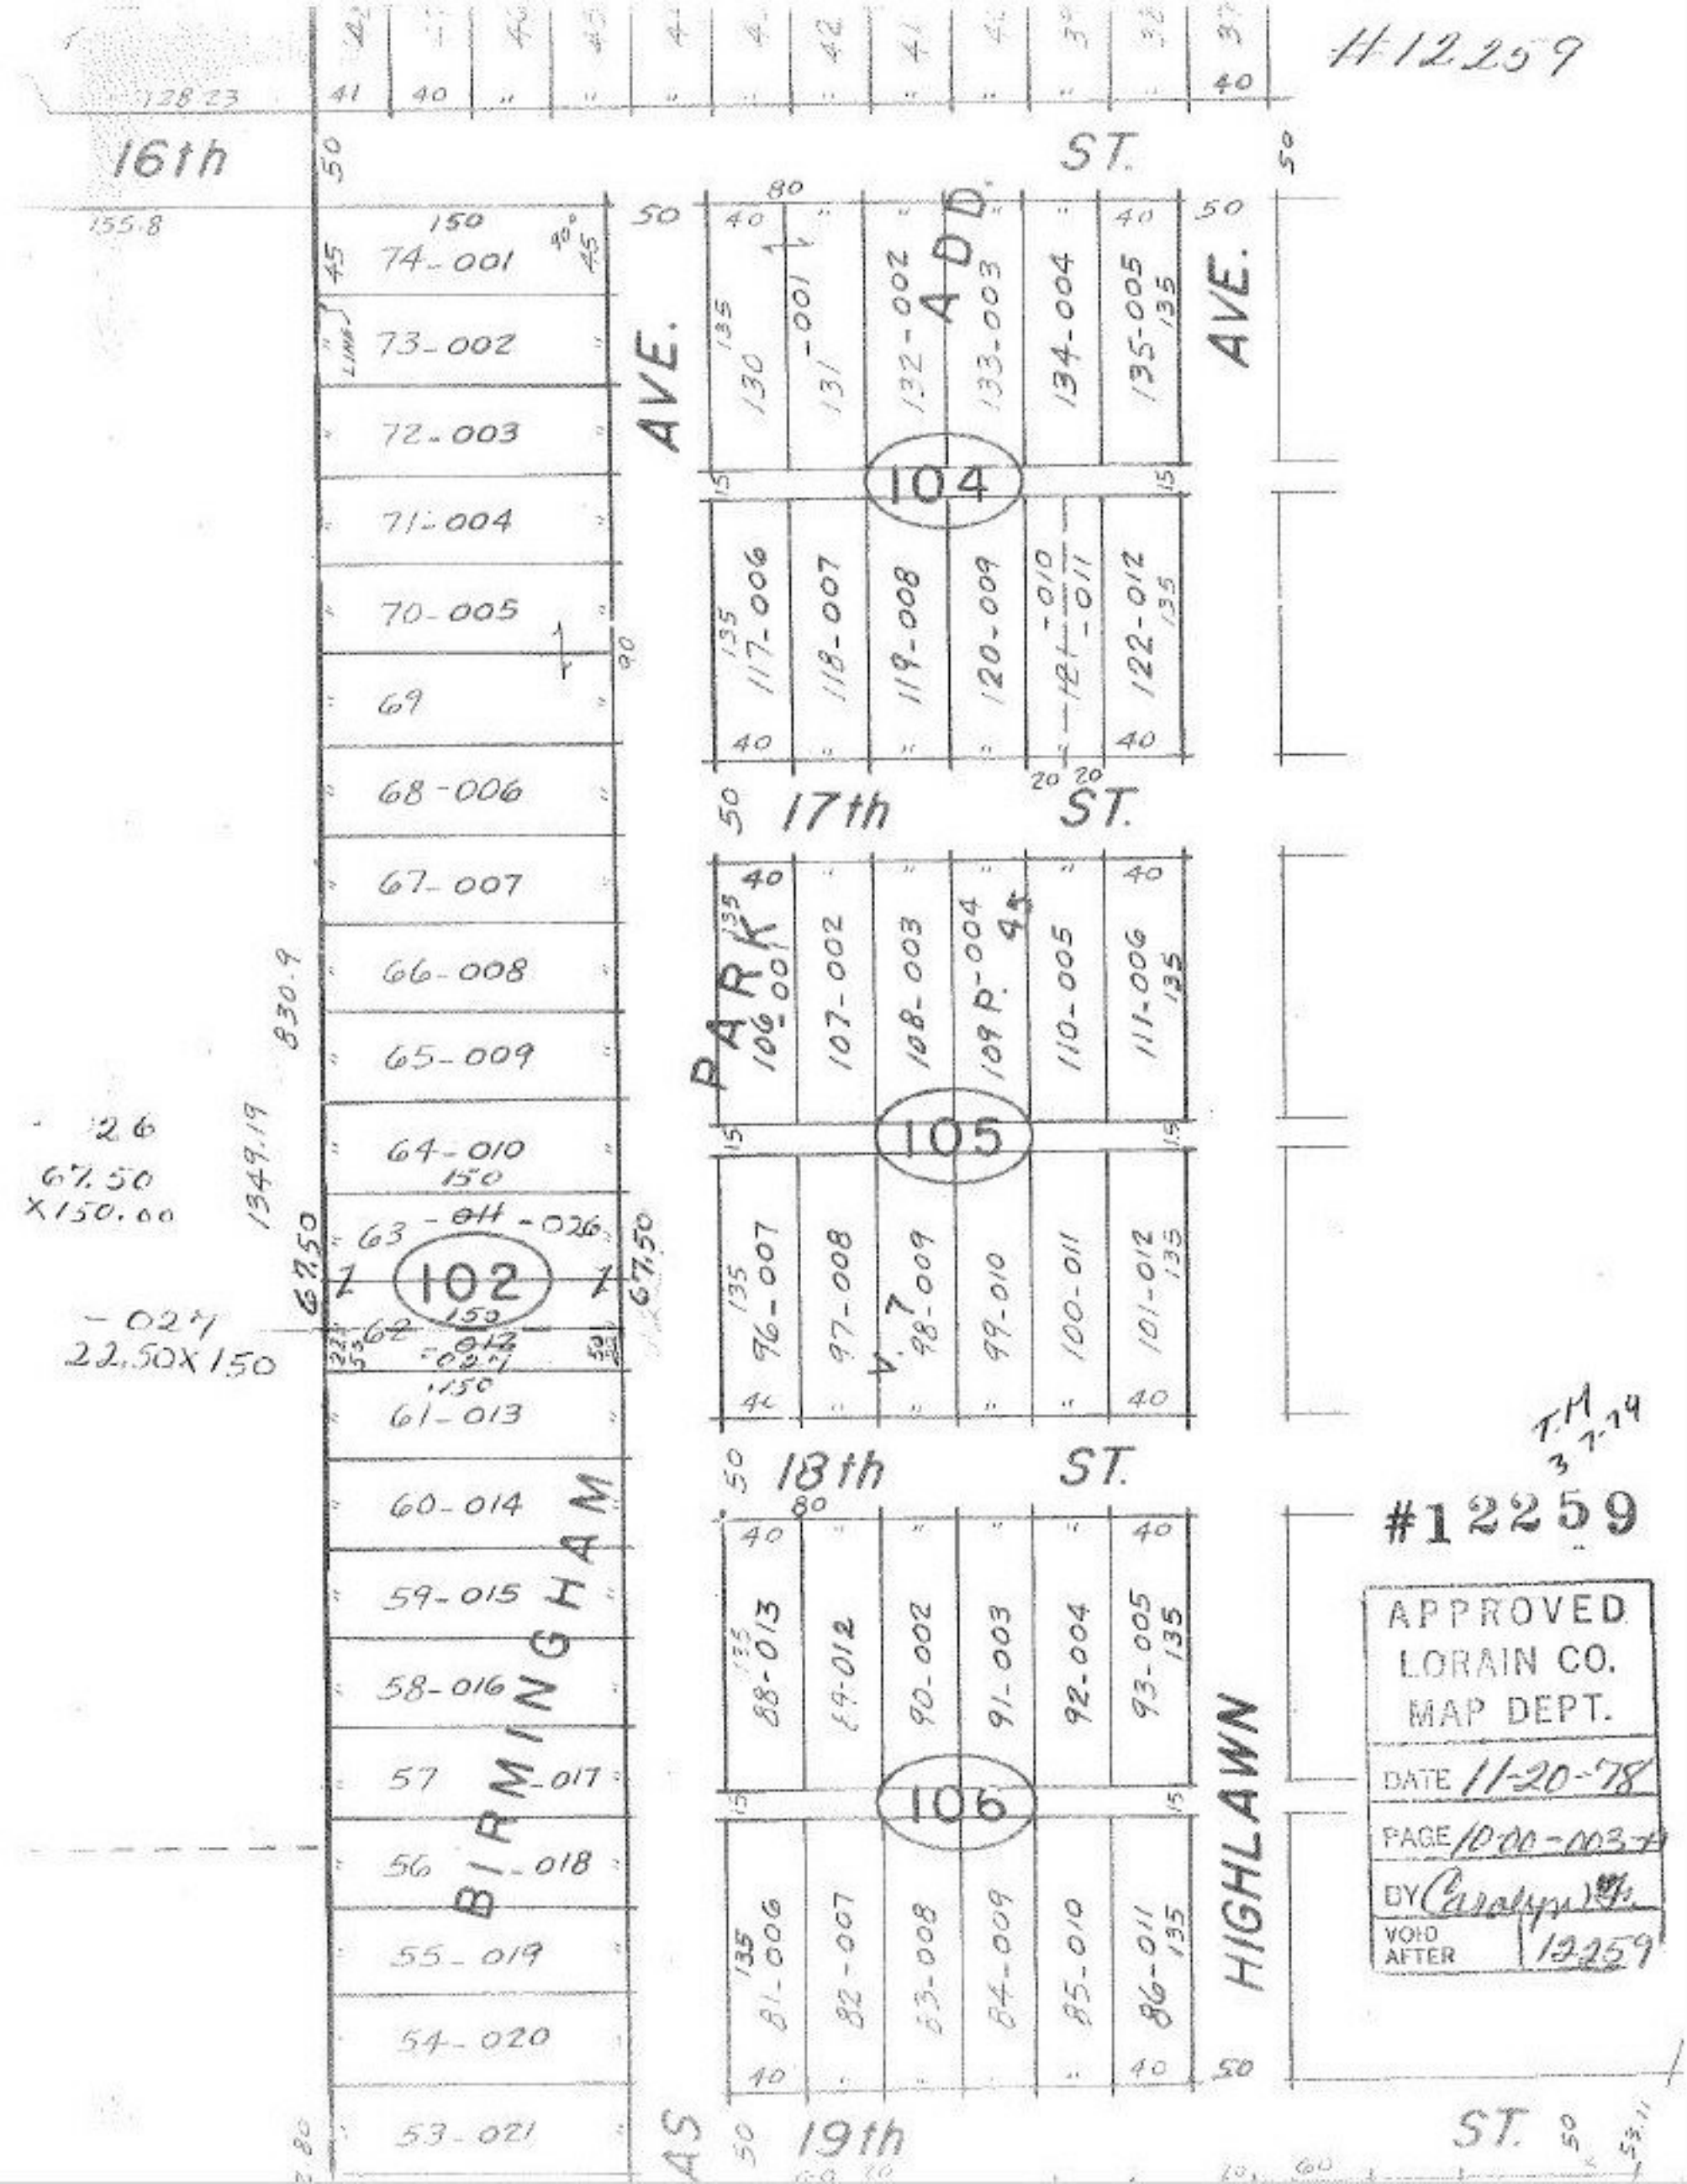
#12259
16th ST.
17th ST.
18th ST.
19th ST.
AVE.
ADD.
PARK
HIGHLAWN
BIRMINGHAM
104
105
106
102
74-001
73-002
72-003
71-004
70-005
69
68-006
67-007
66-008
65-009
64-010
63-011-026
62-012-027
61-013
60-014
59-015
58-016
57-017
56-018
55-019
54-020
53-021
130
131-001
132-002
133-003
134-004
135-005
117-006
118-007
119-008
120-009
121-010-011
122-012
106-001
107-002
108-003
109 P.-004
110-005
111-006
96-007
97-008
98-009
99-010
100-011
101-012
88-013
89-012
90-002
91-003
92-004
93-005
81-006
82-007
83-008
84-009
85-010
86-011
830.9
1349.19
67.50
22.50X150
T.M. 3-7-79
#12259
APPROVED
LORAIN CO.
MAP DEPT.
DATE 11-20-78
PAGE 10-00-003-A
BY Carolyn
VOID AFTER 12259