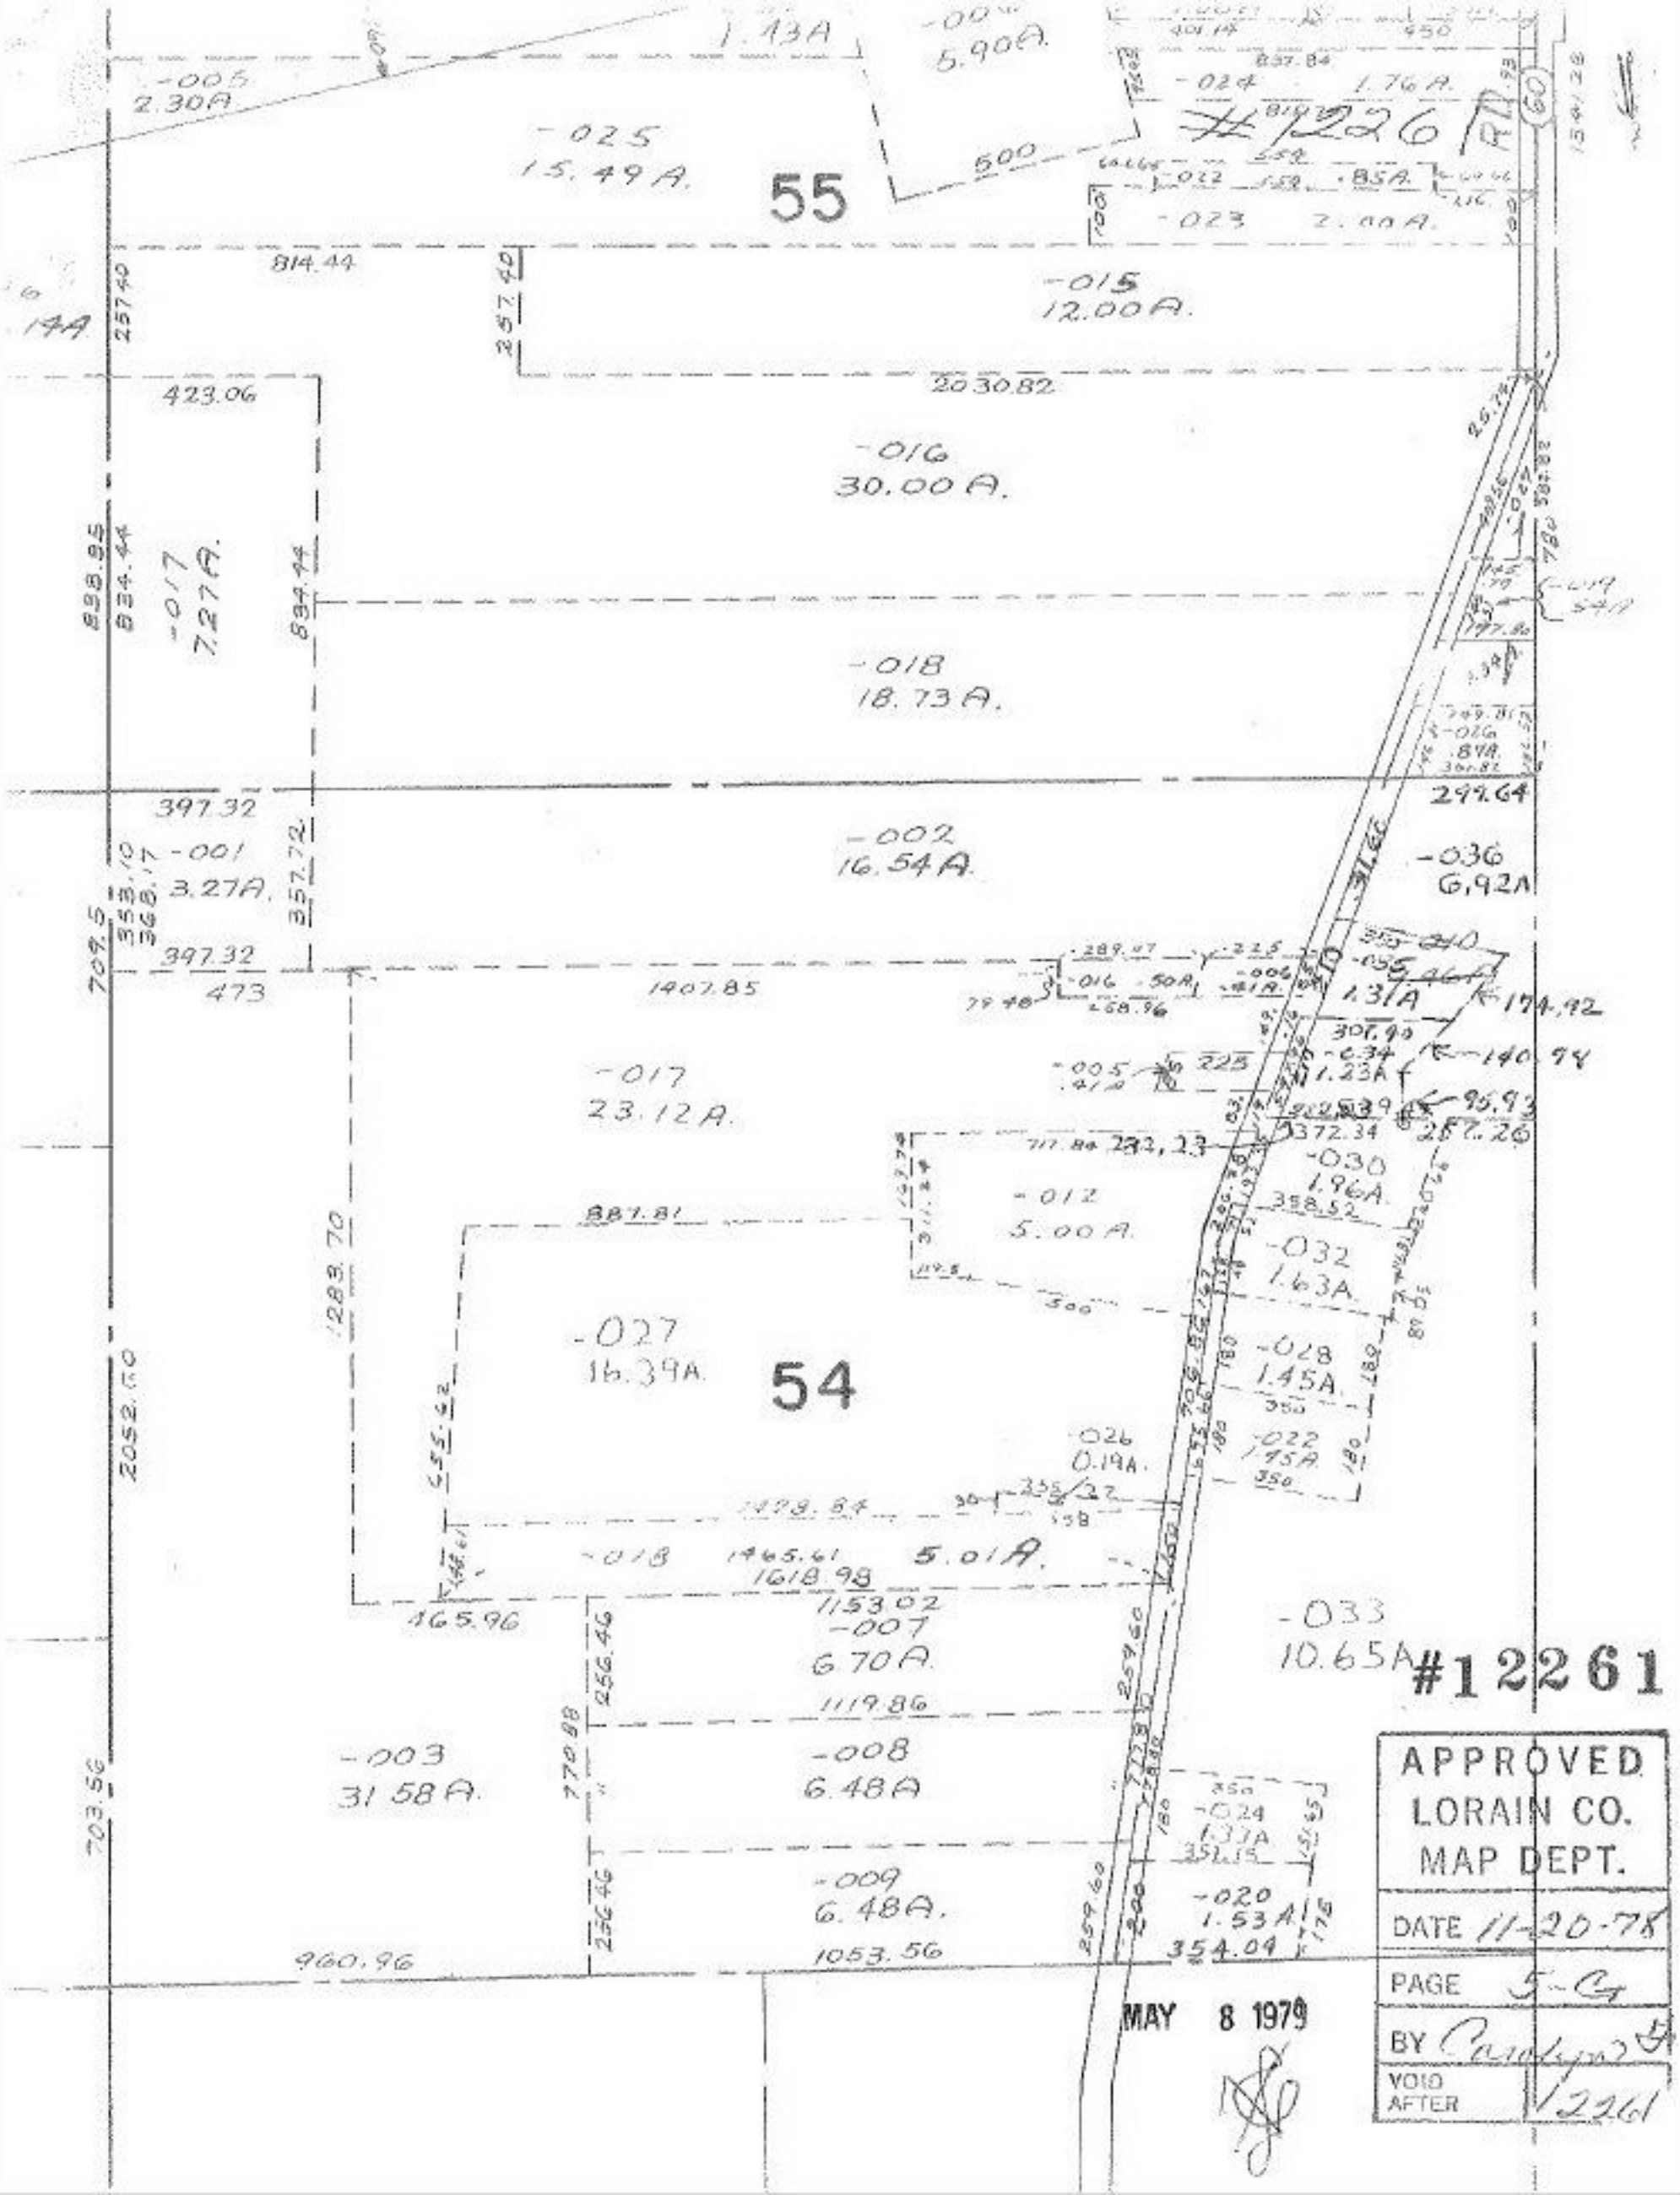

55
54
#12261
APPROVED
LORAIN CO.
MAP DEPT.
DATE 11-20-78
PAGE 5-G
BY
VOID AFTER 12261
MAY 8 1979