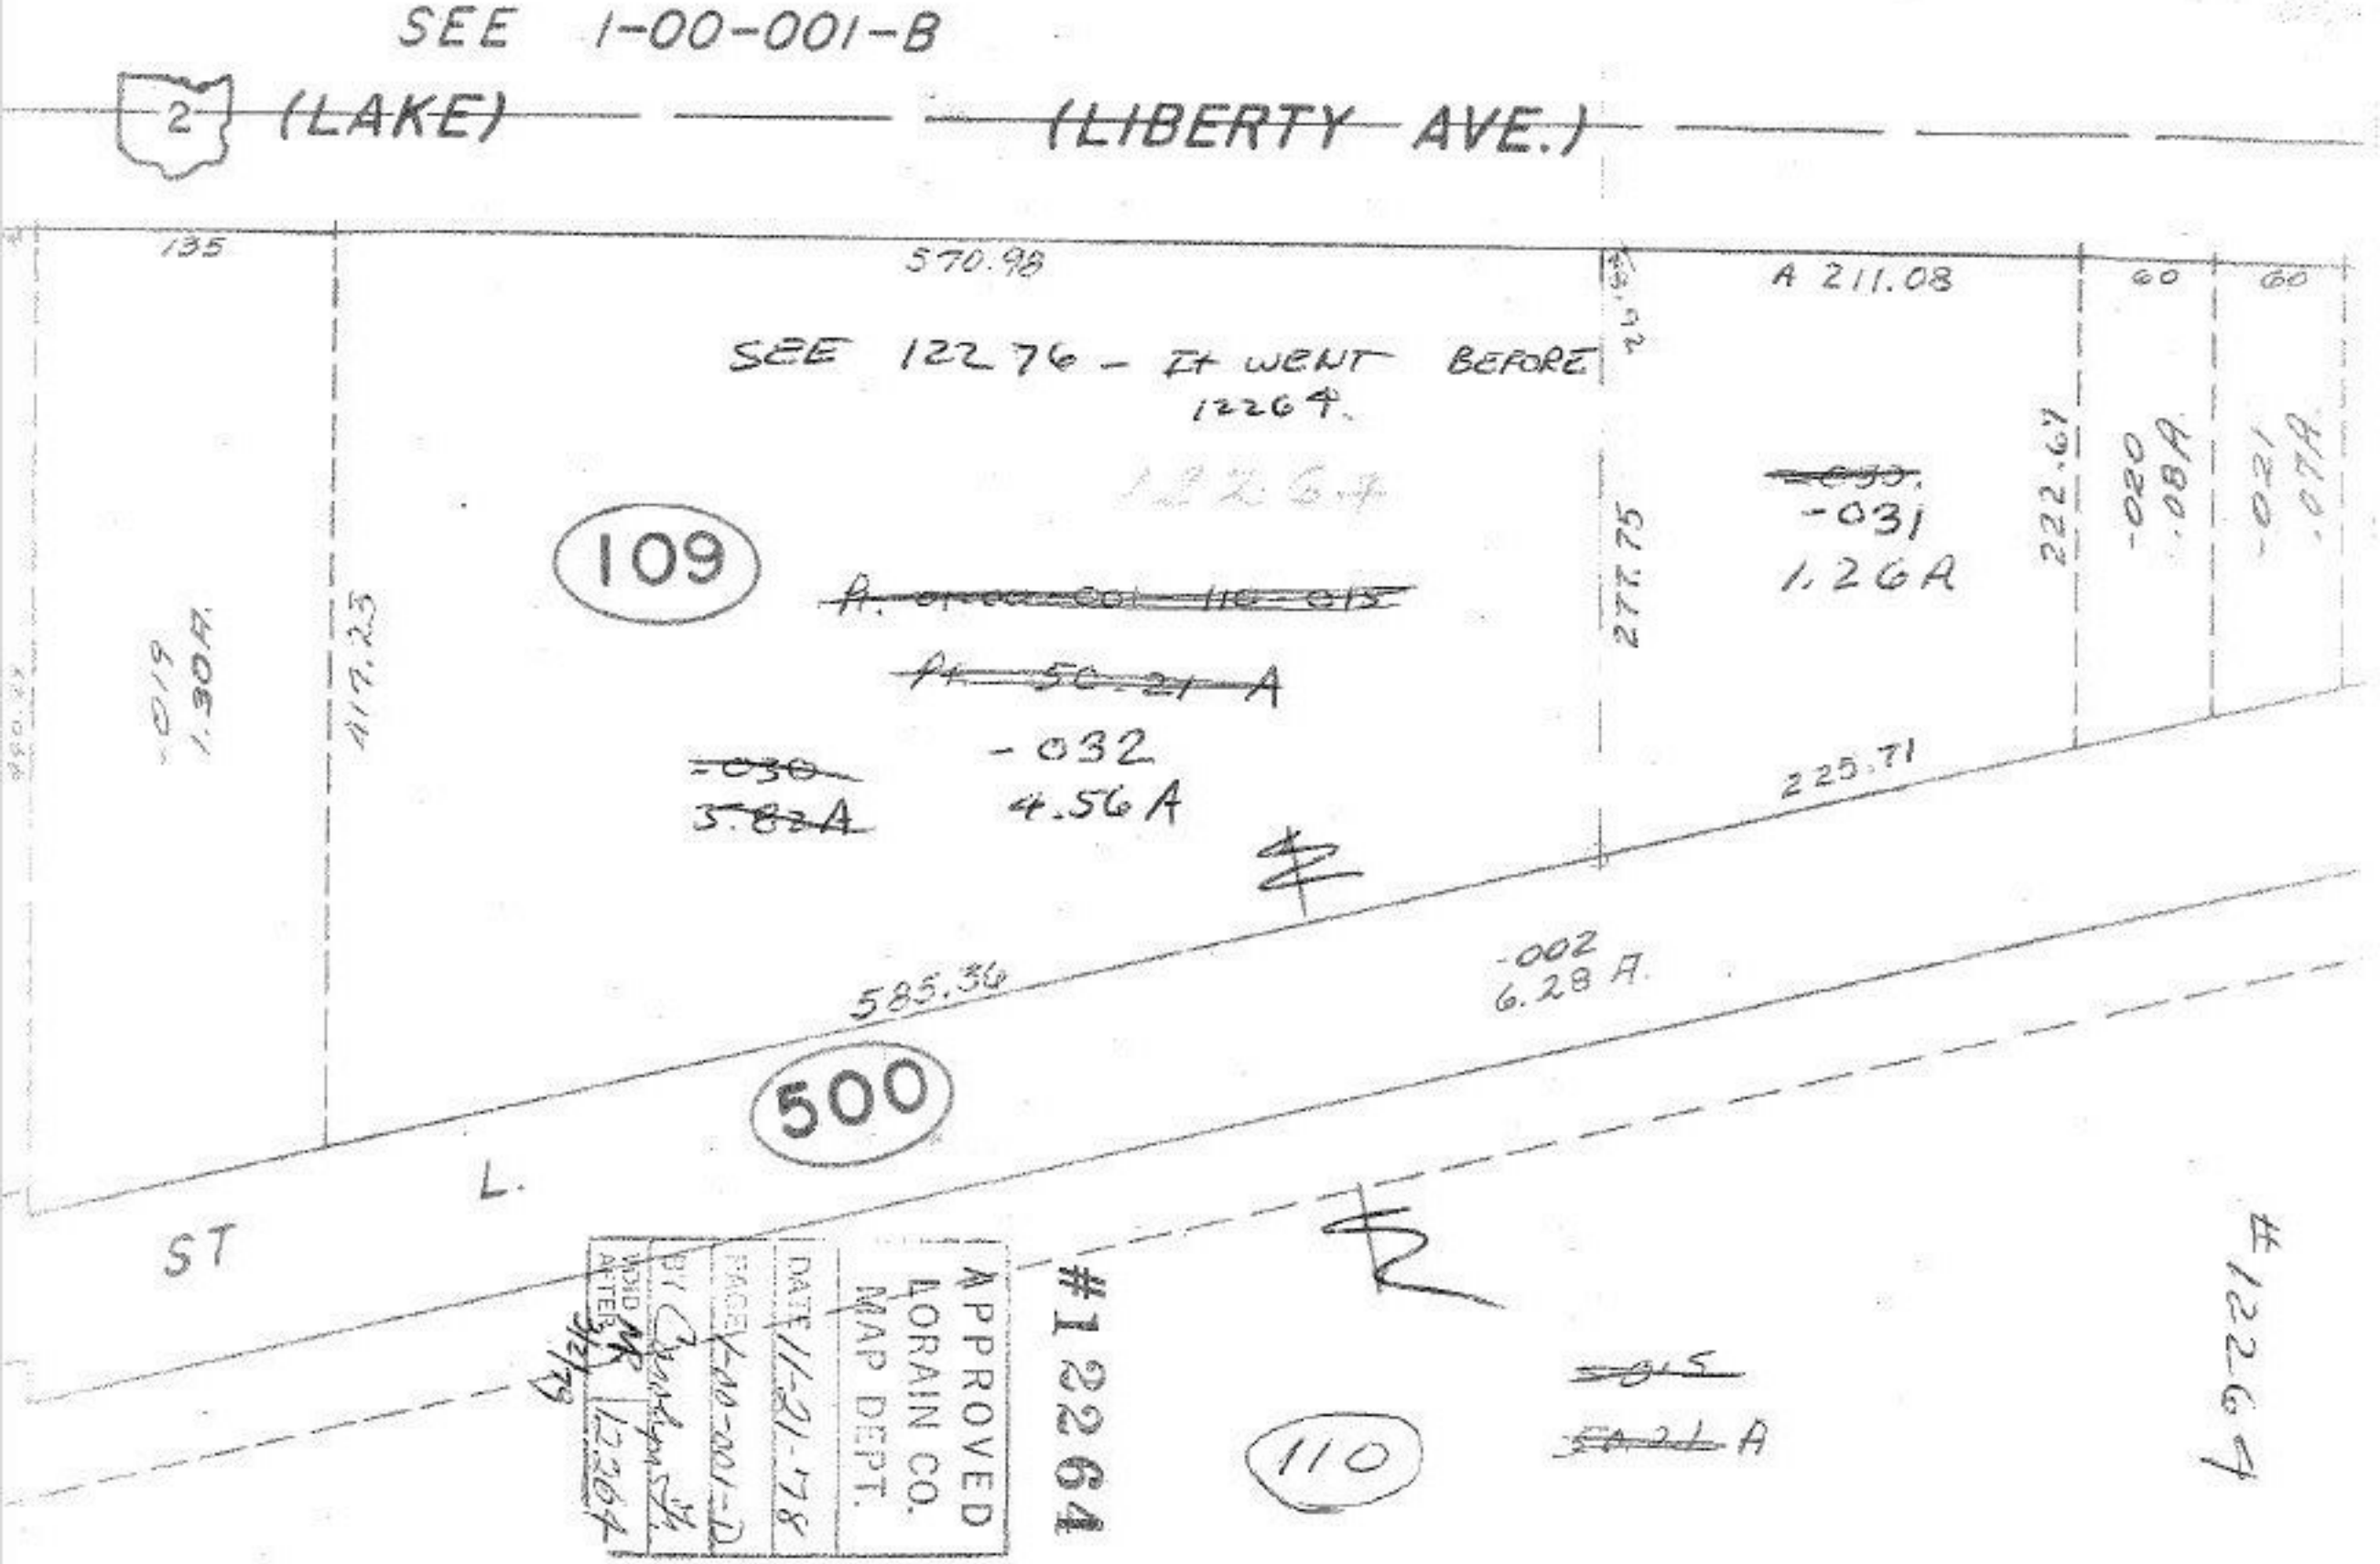
SEE 1-00-001-B
2
(LAKE)
(LIBERTY AVE.)
135
570.98
A 211.08
60
60
SEE 12276 - It went before 12264.
12264
109
-019
1.30A
417.23
~~A. 01-00-001-110-015~~
~~A. 50.21 A~~
~~-030~~
~~3.82A~~
-032
4.56A
277.75
~~-030~~
-031
1.26A
222.67
-020
.08A
-021
.07A
225.71
585.36
-002
6.28 A.
500
L.
ST
APPROVED
LORAIN CO.
MAP DEPT.
DATE 11-21-78
PAGE 1-00-001-D
BY
VOID
AFTER 12264
#12264
110
~~-015~~
~~50.21~~ A
#12264