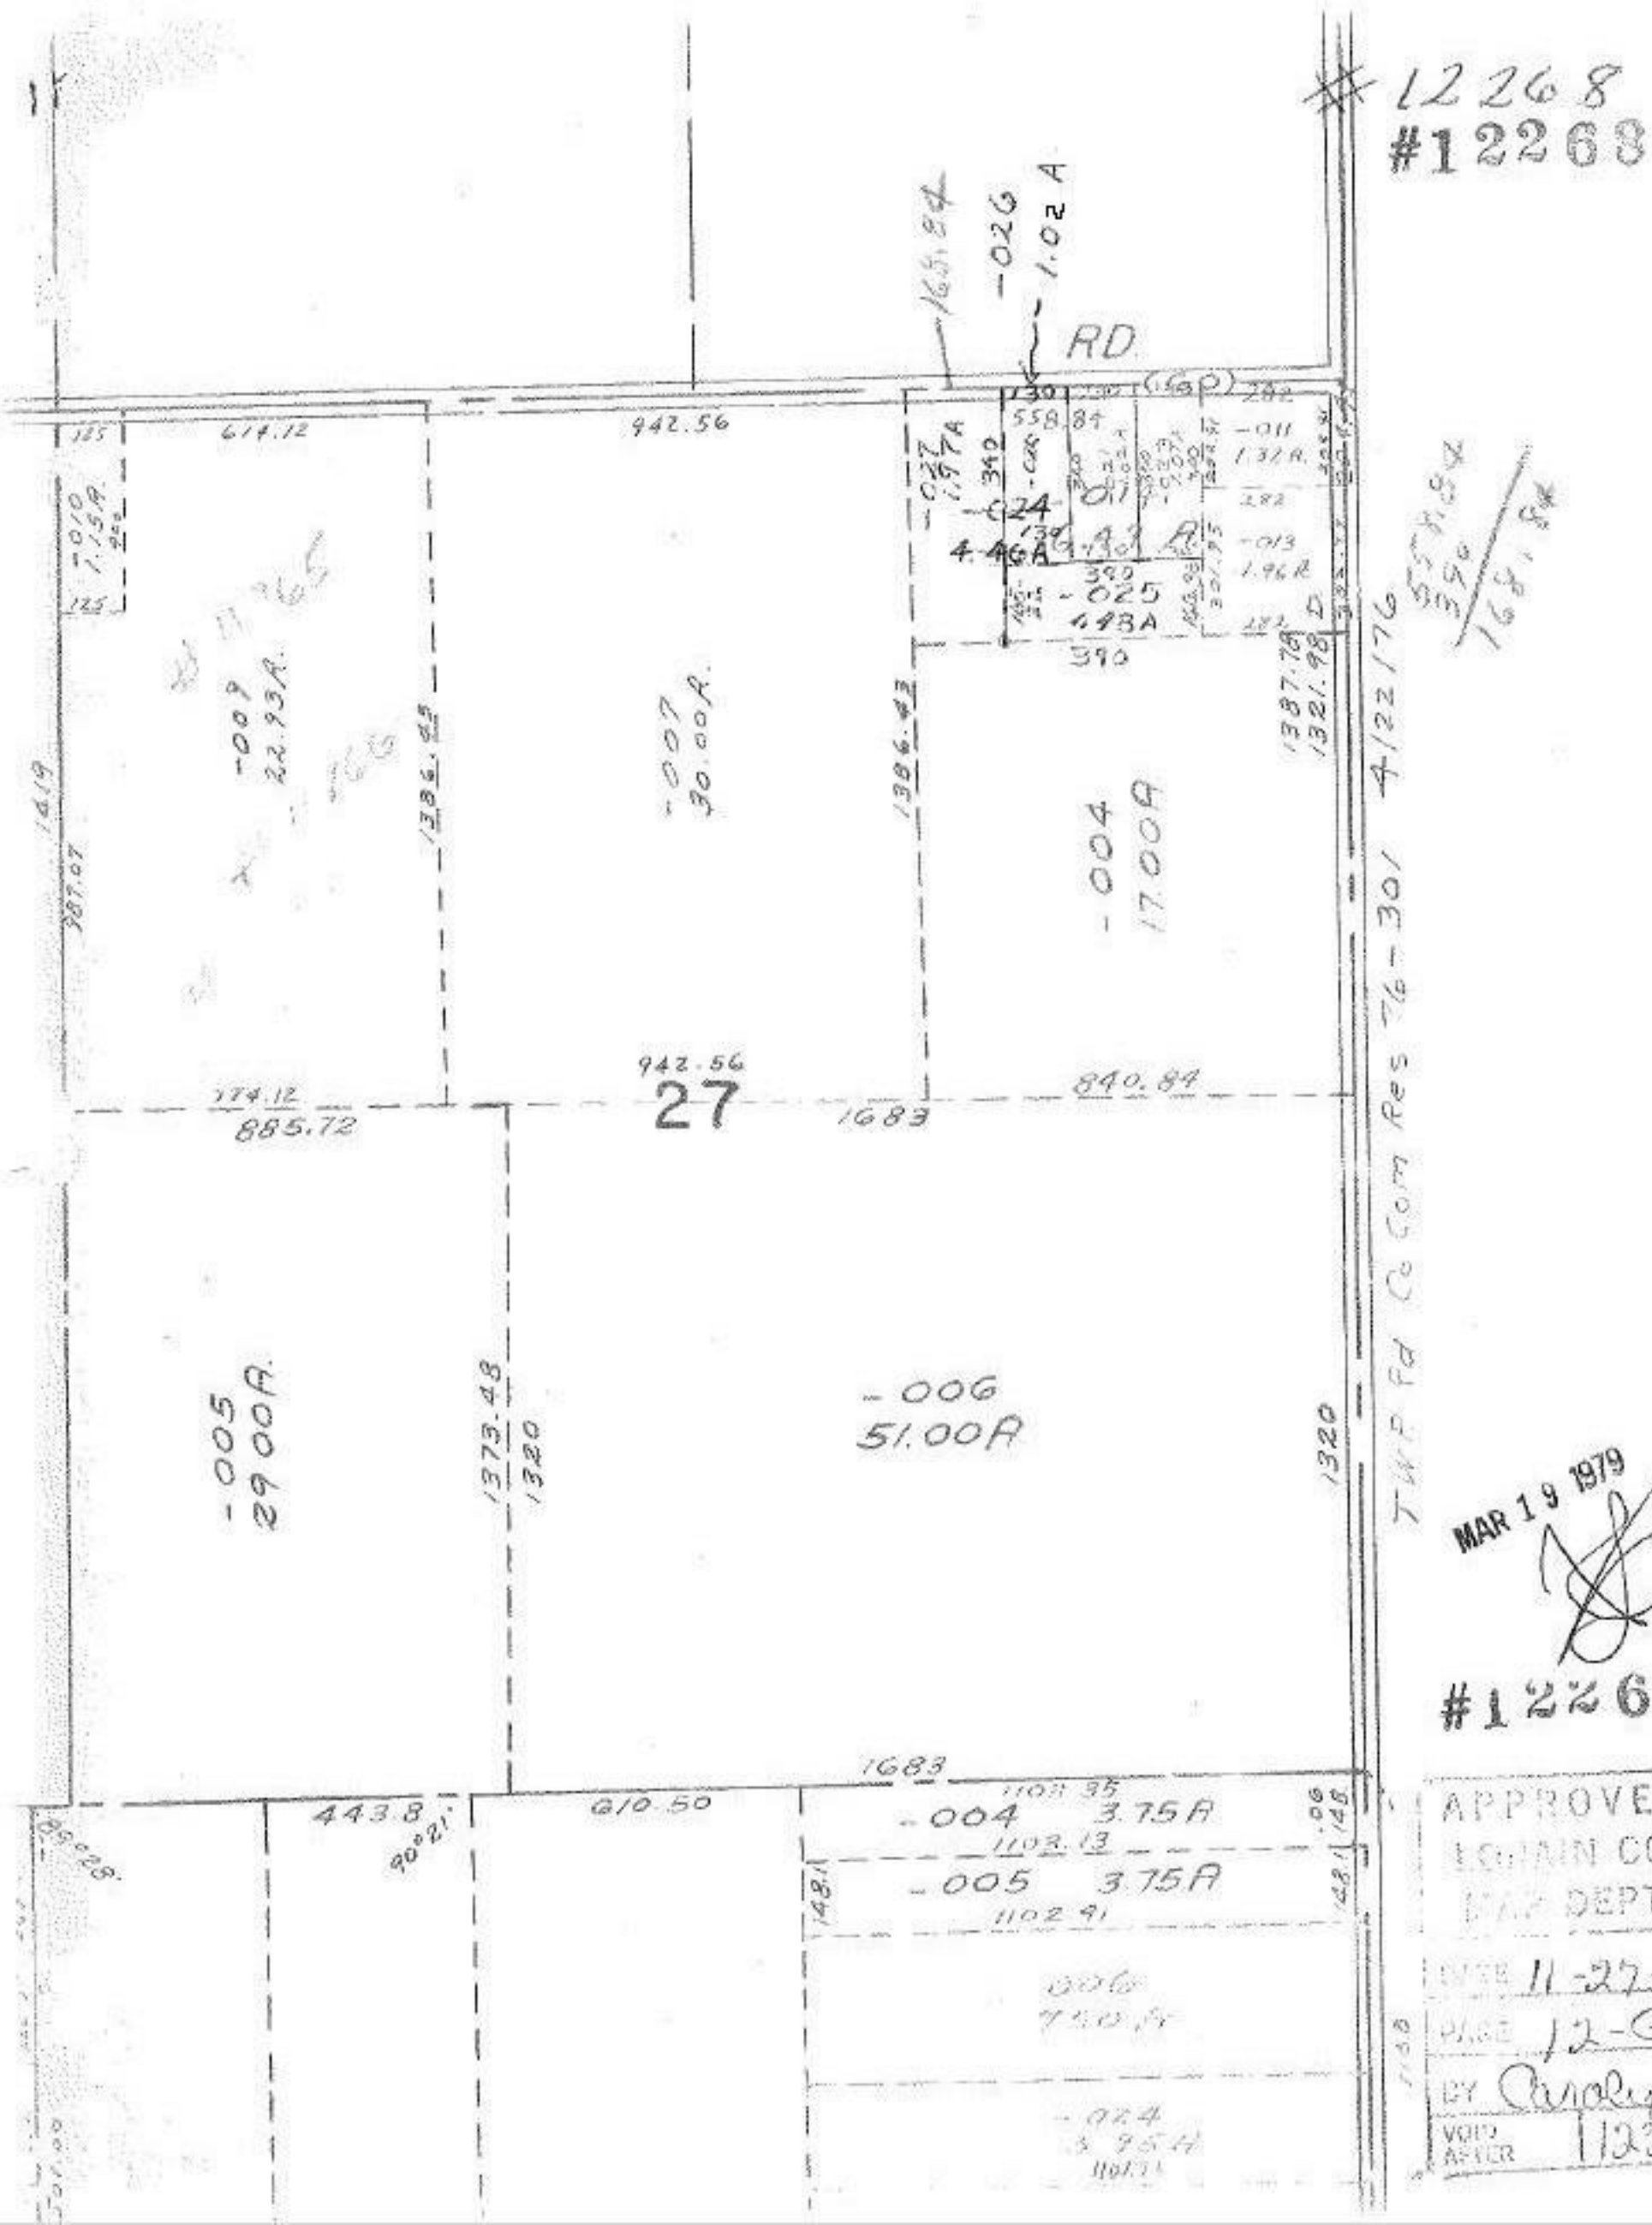

#12268
#12268
RD
-026
1.02 A
-024
4.46A
-025
4.48A
-011
1.32 A
-013
1.96 A
-009
22.93A
-007
30.00A
-004
17.00A
-005
29.00A
-006
51.00A
27
942.56
614.12
1386.43
1387.78
1321.98
1683
840.84
885.72
1373.48
1320
443.8
610.50
-004 3.75A
-005 3.75A
TWP Rd Co Com Res 76-301
MAR 19 1979
#12268
APPROVED
LOGAN CO.
MAP DEPT.
DATE 11-27-7
PAGE 12-G
BY Carolyn
VOID AFTER 12268