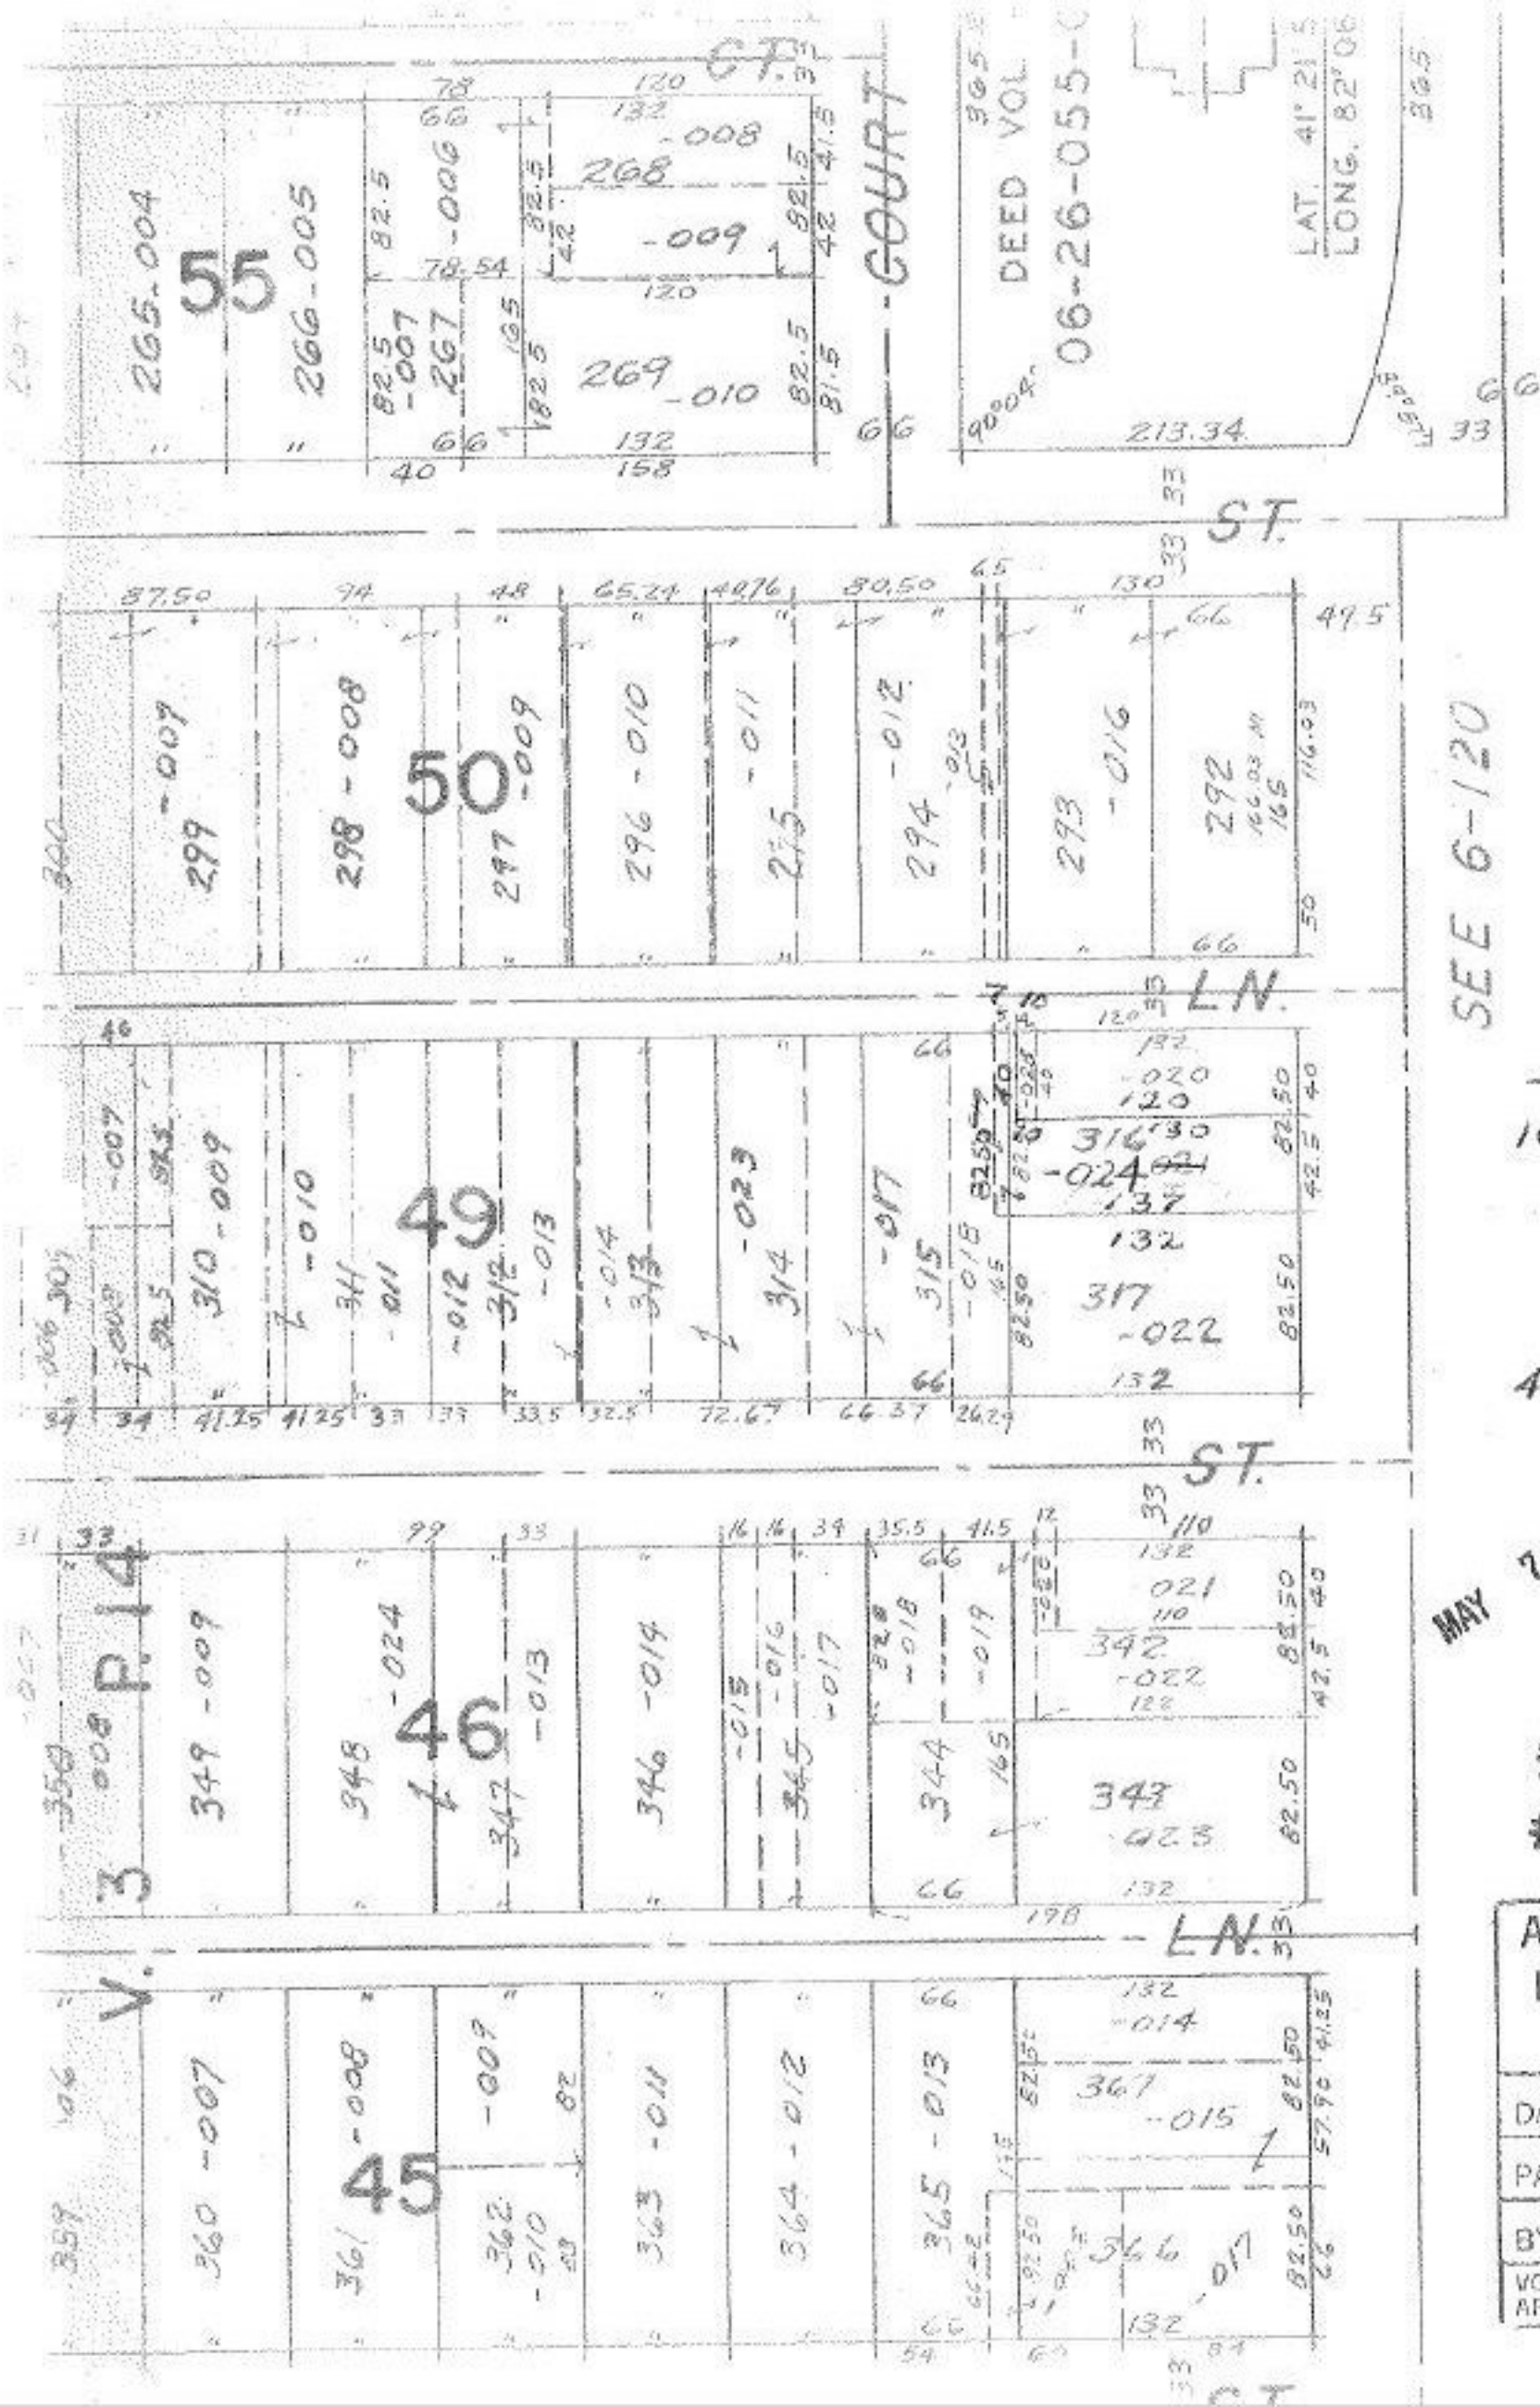


#12270

#12443

-025
10x40

-024
42.50x137
1 R

MAY 7 1979

#12443
#12270

APPROVED
LORAIN CO.
MAP DEPT.

DATE 11-28-78

PAGE 6-119

BY Carolyn F.

VOID AFTER 12270