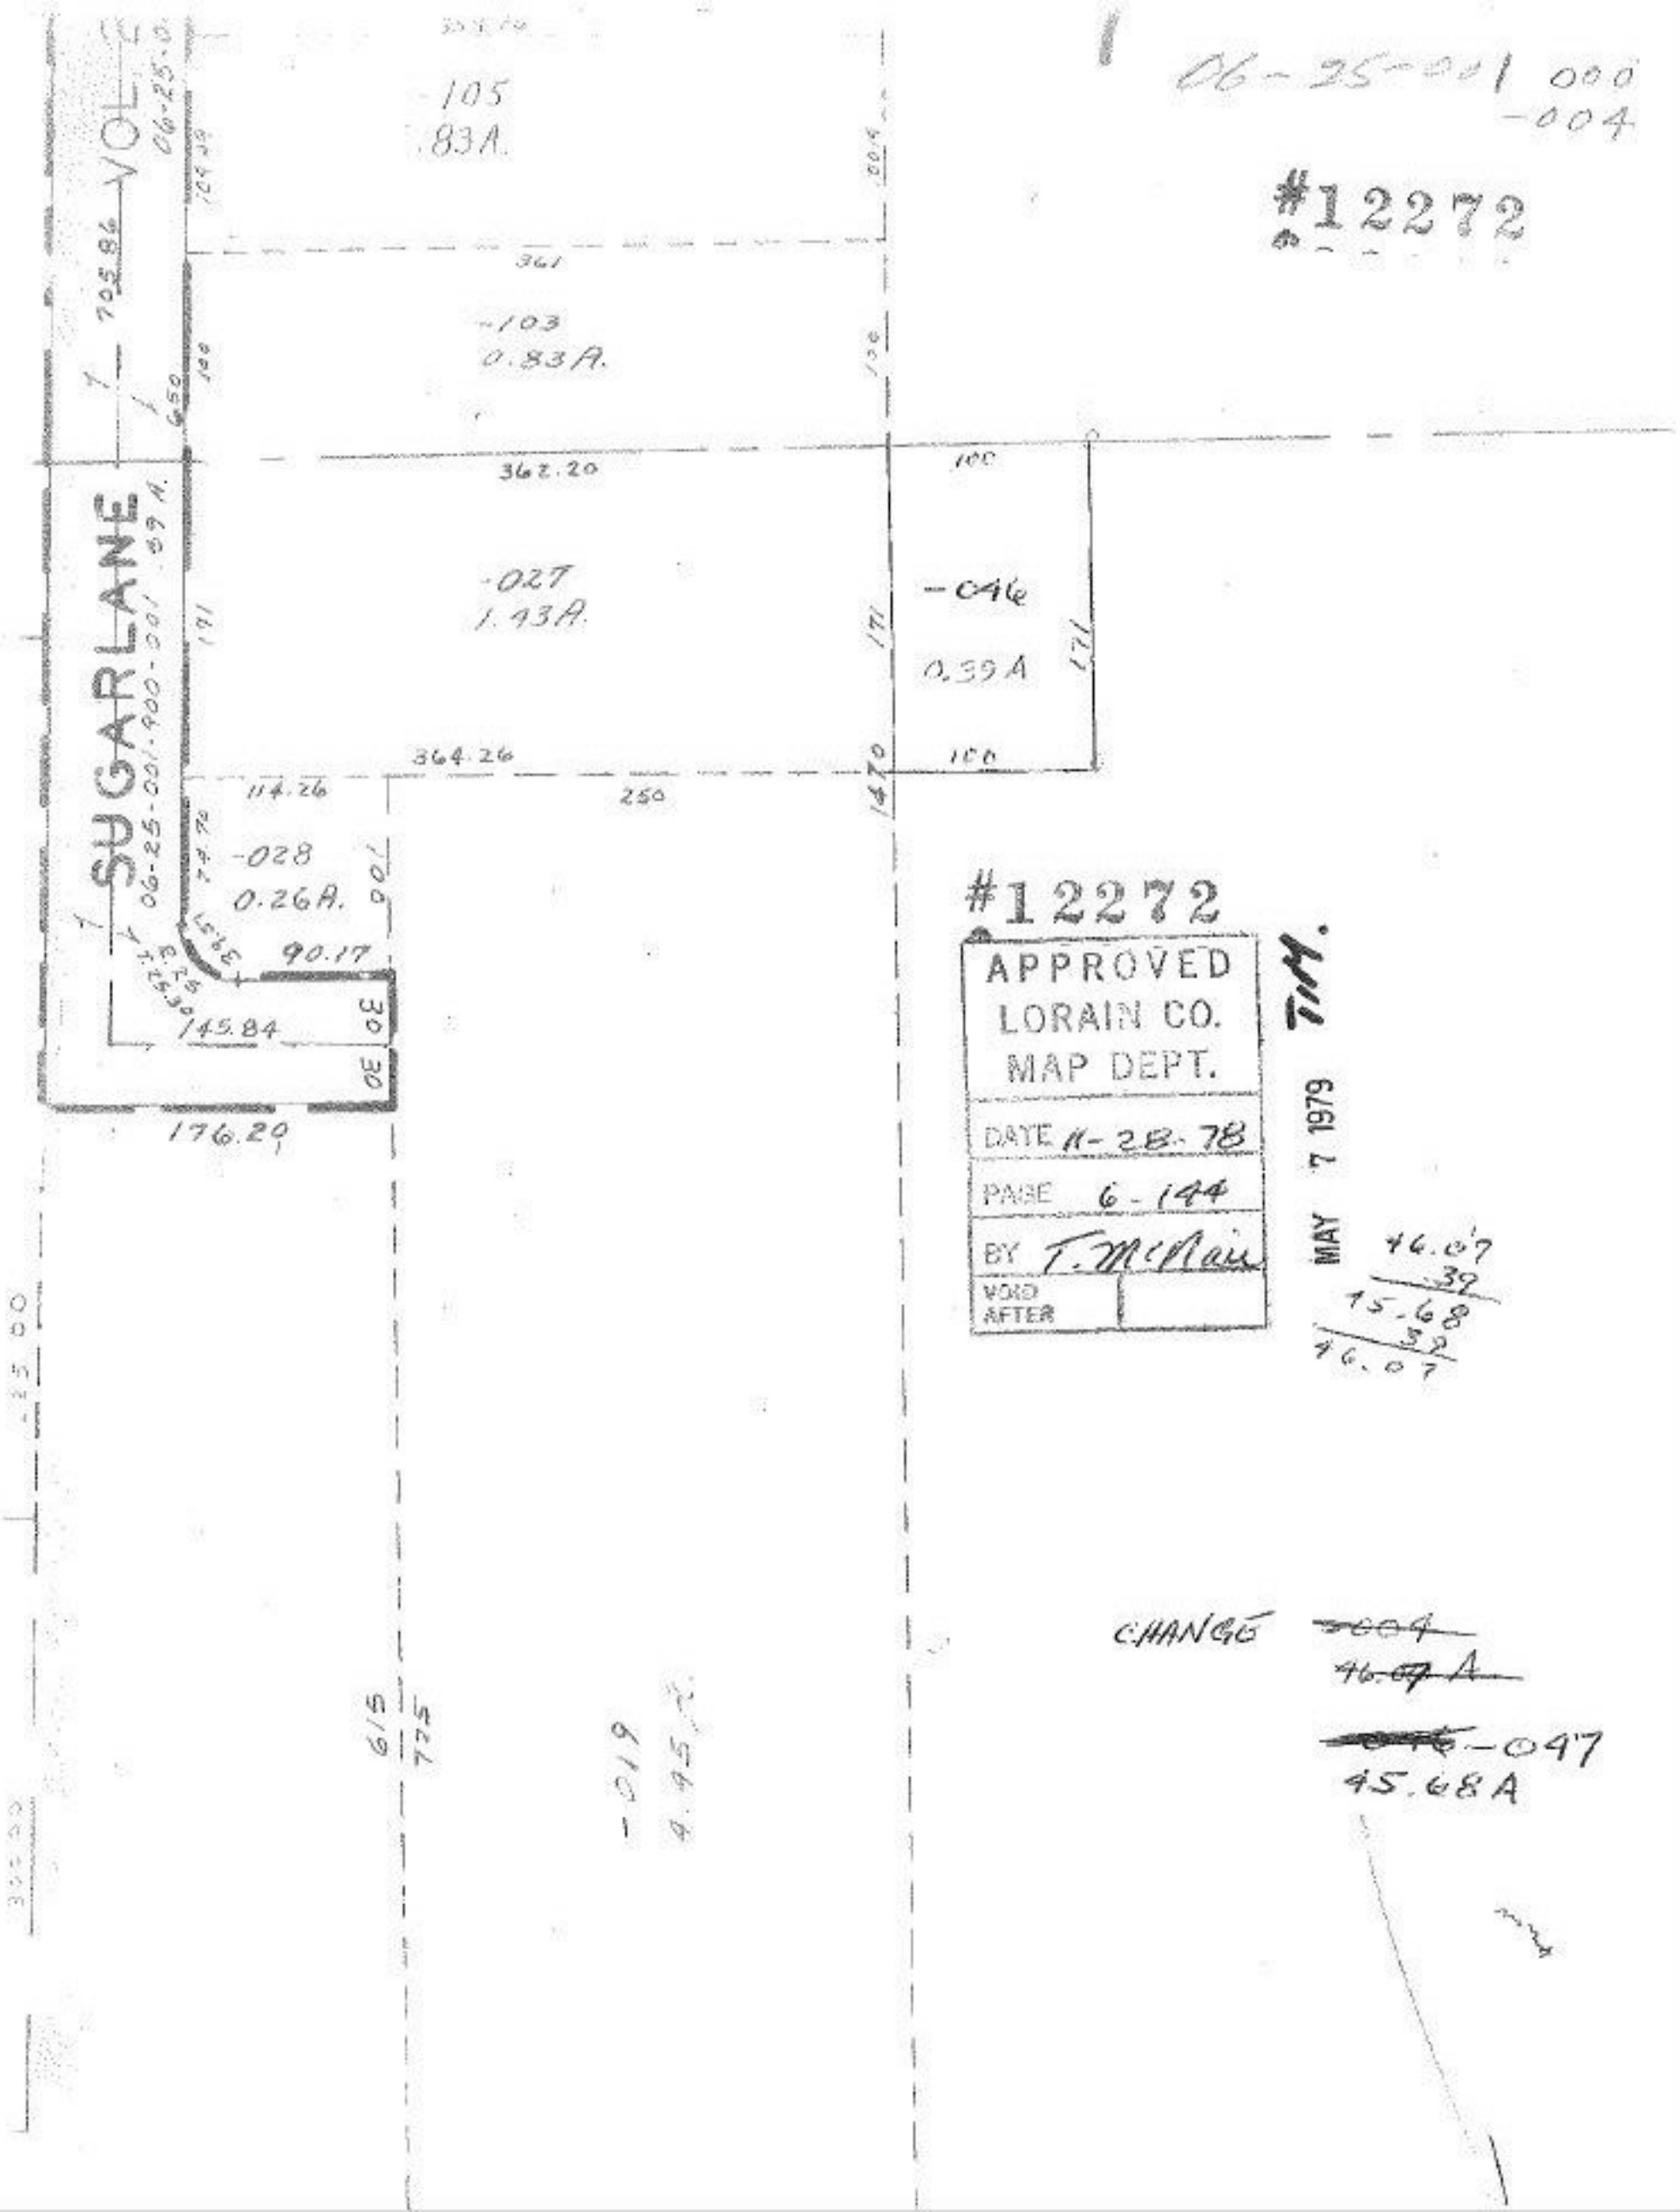
06-25-001 000
-004
#12272
VOL
SUGARLANE
06-25-001-900-001 .89 A.
705.86
-105
.83A.
361
-103
0.83A.
362.20
100
-027
1.43A.
-046
0.39A
171
364.26
114.26
250
1470
-028
0.26A.
90.17
145.84
30
176.20
#12272
APPROVED
LORAIN CO.
MAP DEPT.
DATE 11-28-78
PAGE 6-144
BY T. McNair
VOID AFTER
MAY 7 1979
TIM.
46.07
.39
45.68
.39
46.07
CHANGE
~~-004~~
~~46.07 A~~
~~-046~~ -047
45.68 A
615
775
-019
4.95 A