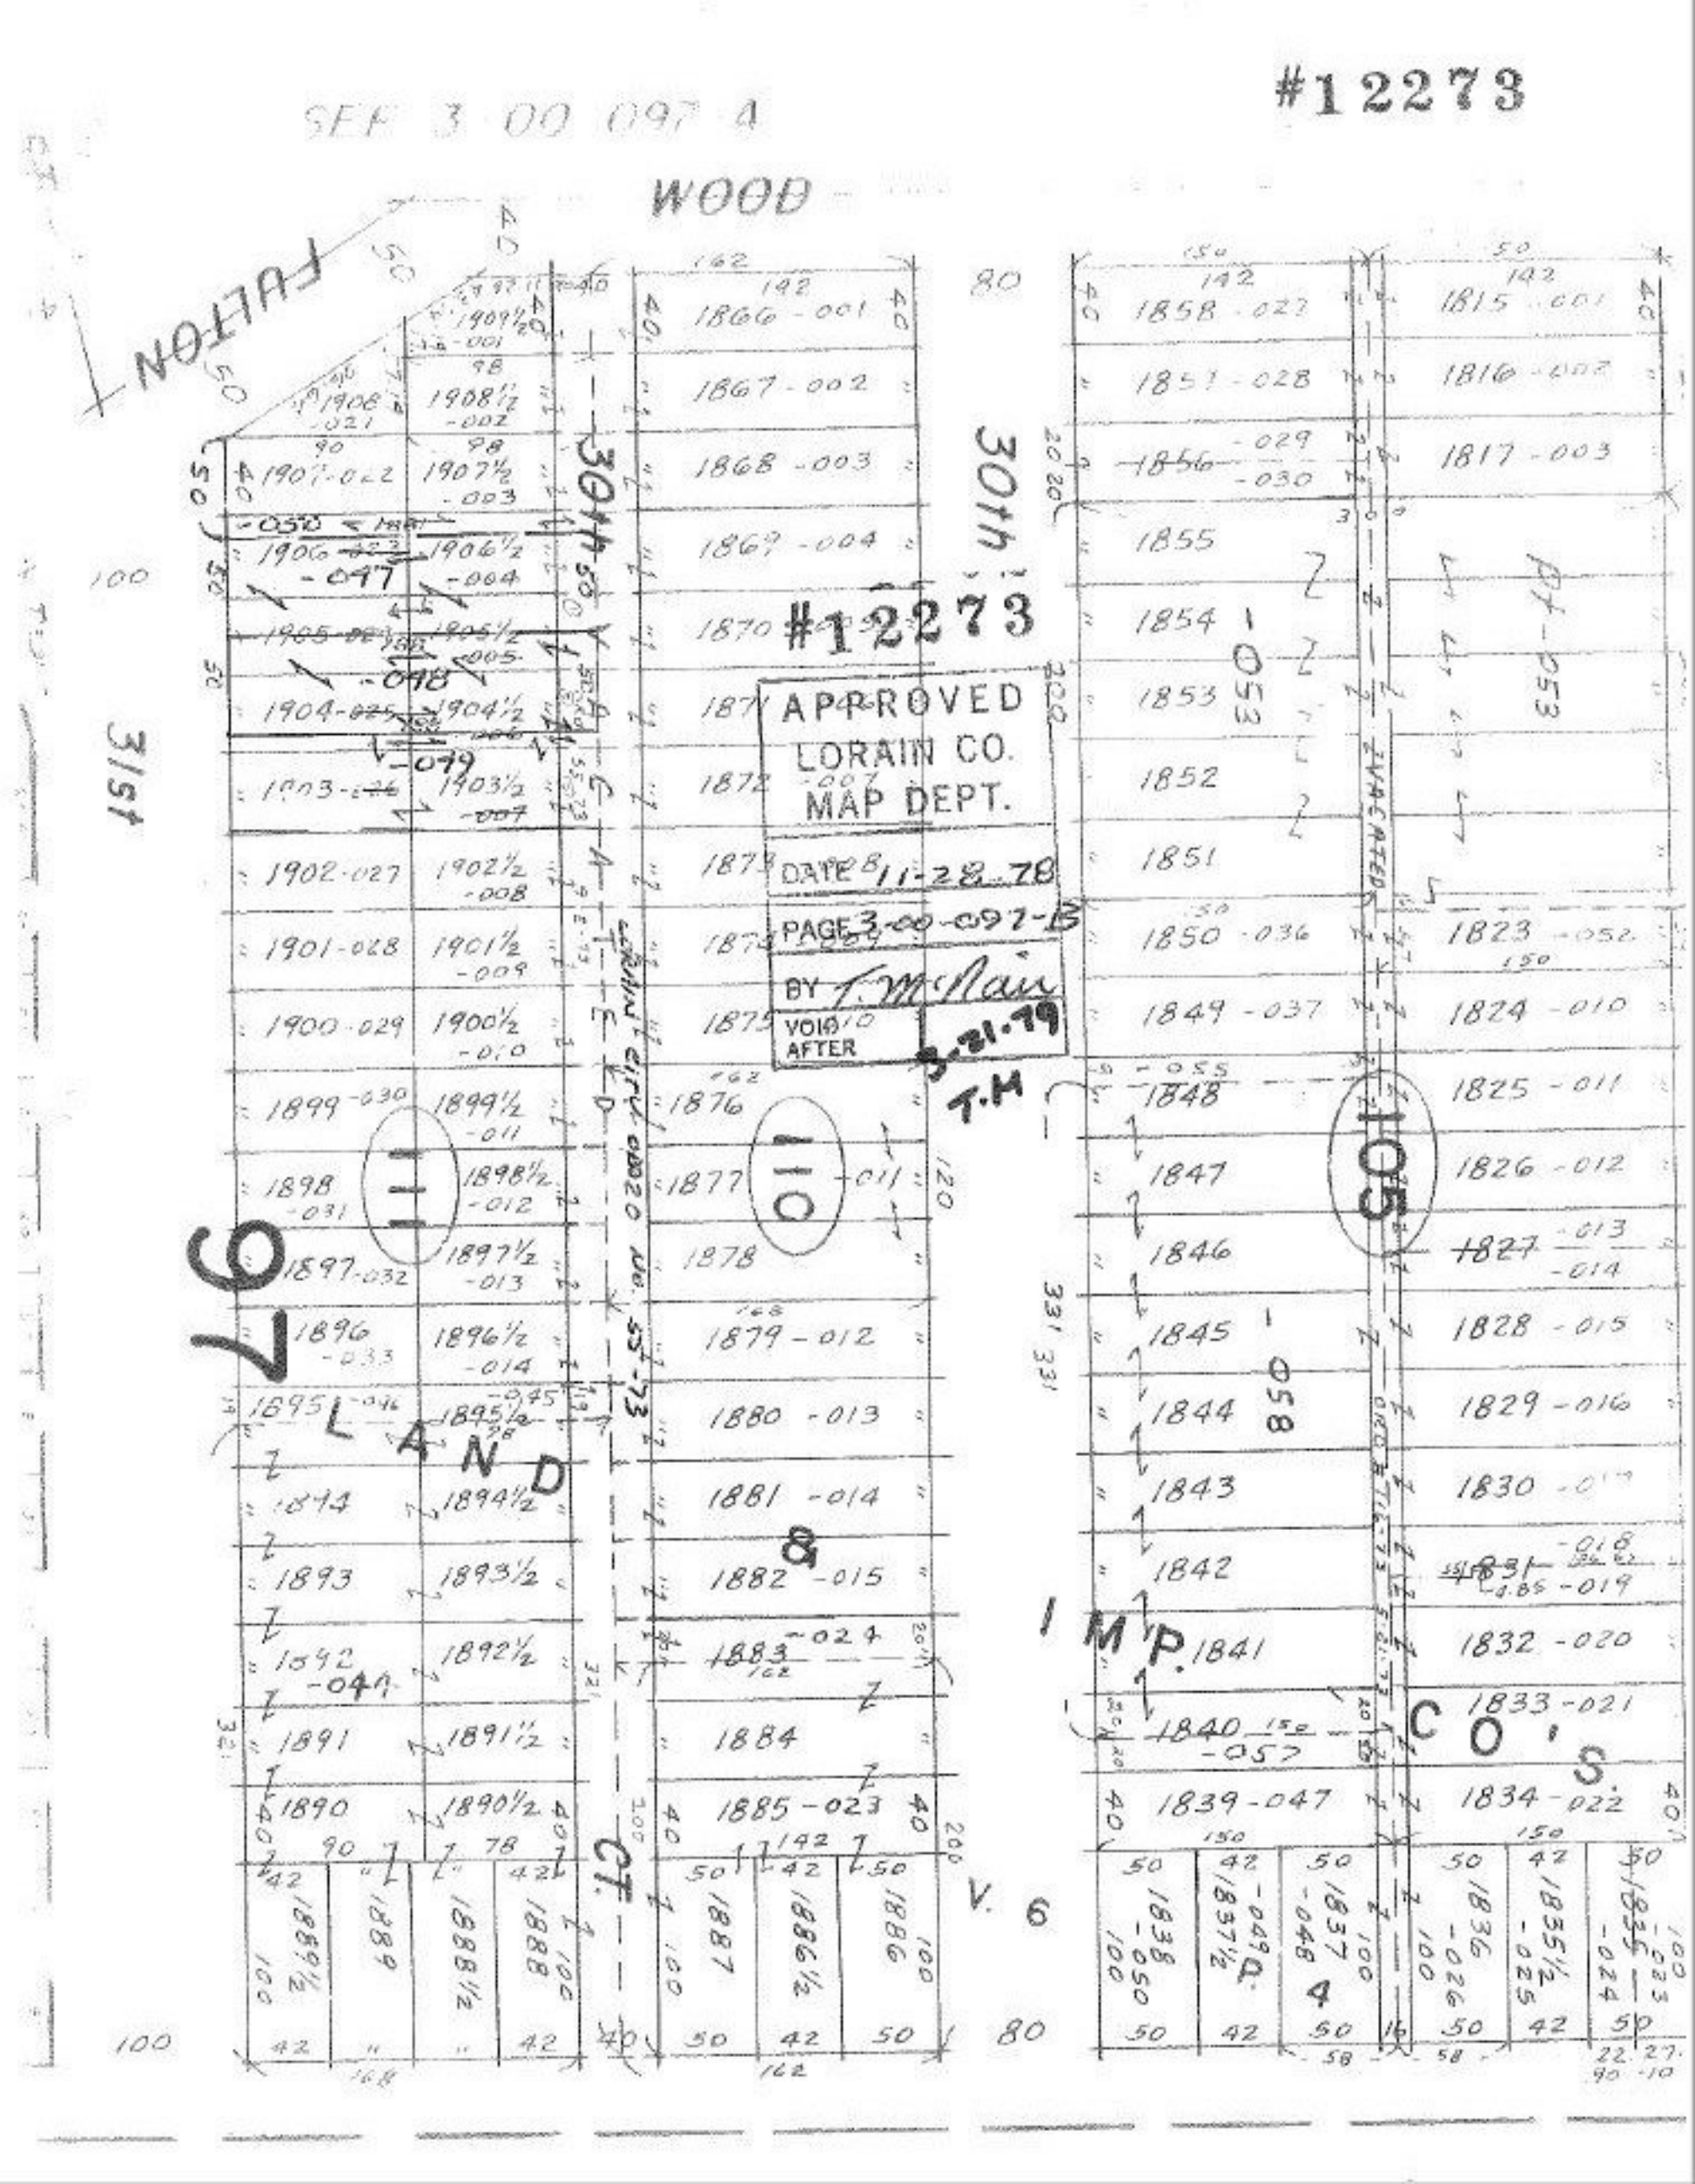

#12273
SEE 3-00-097-4
WOOD
FULTON
30th
31st
#12273
APPROVED
LORAIN CO.
MAP DEPT.
DATE 11-28-78
PAGE 3-00-097-B
BY T. McNair
VOID AFTER 3-21-79
T.H
LAND & IMP. CO'S
CT.
V. 6
P. 4
97
111
110
105
1866-001
1867-002
1868-003
1869-004
1870
1871
1872
1873
1874
1875
1876
1877
1878
1879-012
1880-013
1881-014
1882-015
1883-024
1884
1885-023
1858-027
1857-028
1856-029
1855
1854
1853
1852
1851
1850-036
1849-037
1848
1847
1846
1845
1844
1843
1842
1841
1840-057
1839-047
1815-001
1816-002
1817-003
1823-052
1824-010
1825-011
1826-012
1827-013
1828-015
1829-016
1830
1831-018
1832-020
1833-021
1834-022
1909½-001
1908-021
1908½-002
1907-022
1907½-003
1906-023
1906½-004
1905-024
1905½-005
1904-025
1904½-006
1903-026
1903½-007
1902-027
1902½-008
1901-028
1901½-009
1900-029
1900½-010
1899-030
1899½-011
1898-031
1898½-012
1897-032
1897½-013
1896-033
1896½-014
1895-046
1895½-045
1894
1894½
1893
1893½
1892-044
1892½
1891
1891½
1890
1890½
1889½
1889
1888½
1888
1887
1886½
1886
1838-050
1837½-049
1837-048
1836-026
1835½-025
1835-024
1835-023