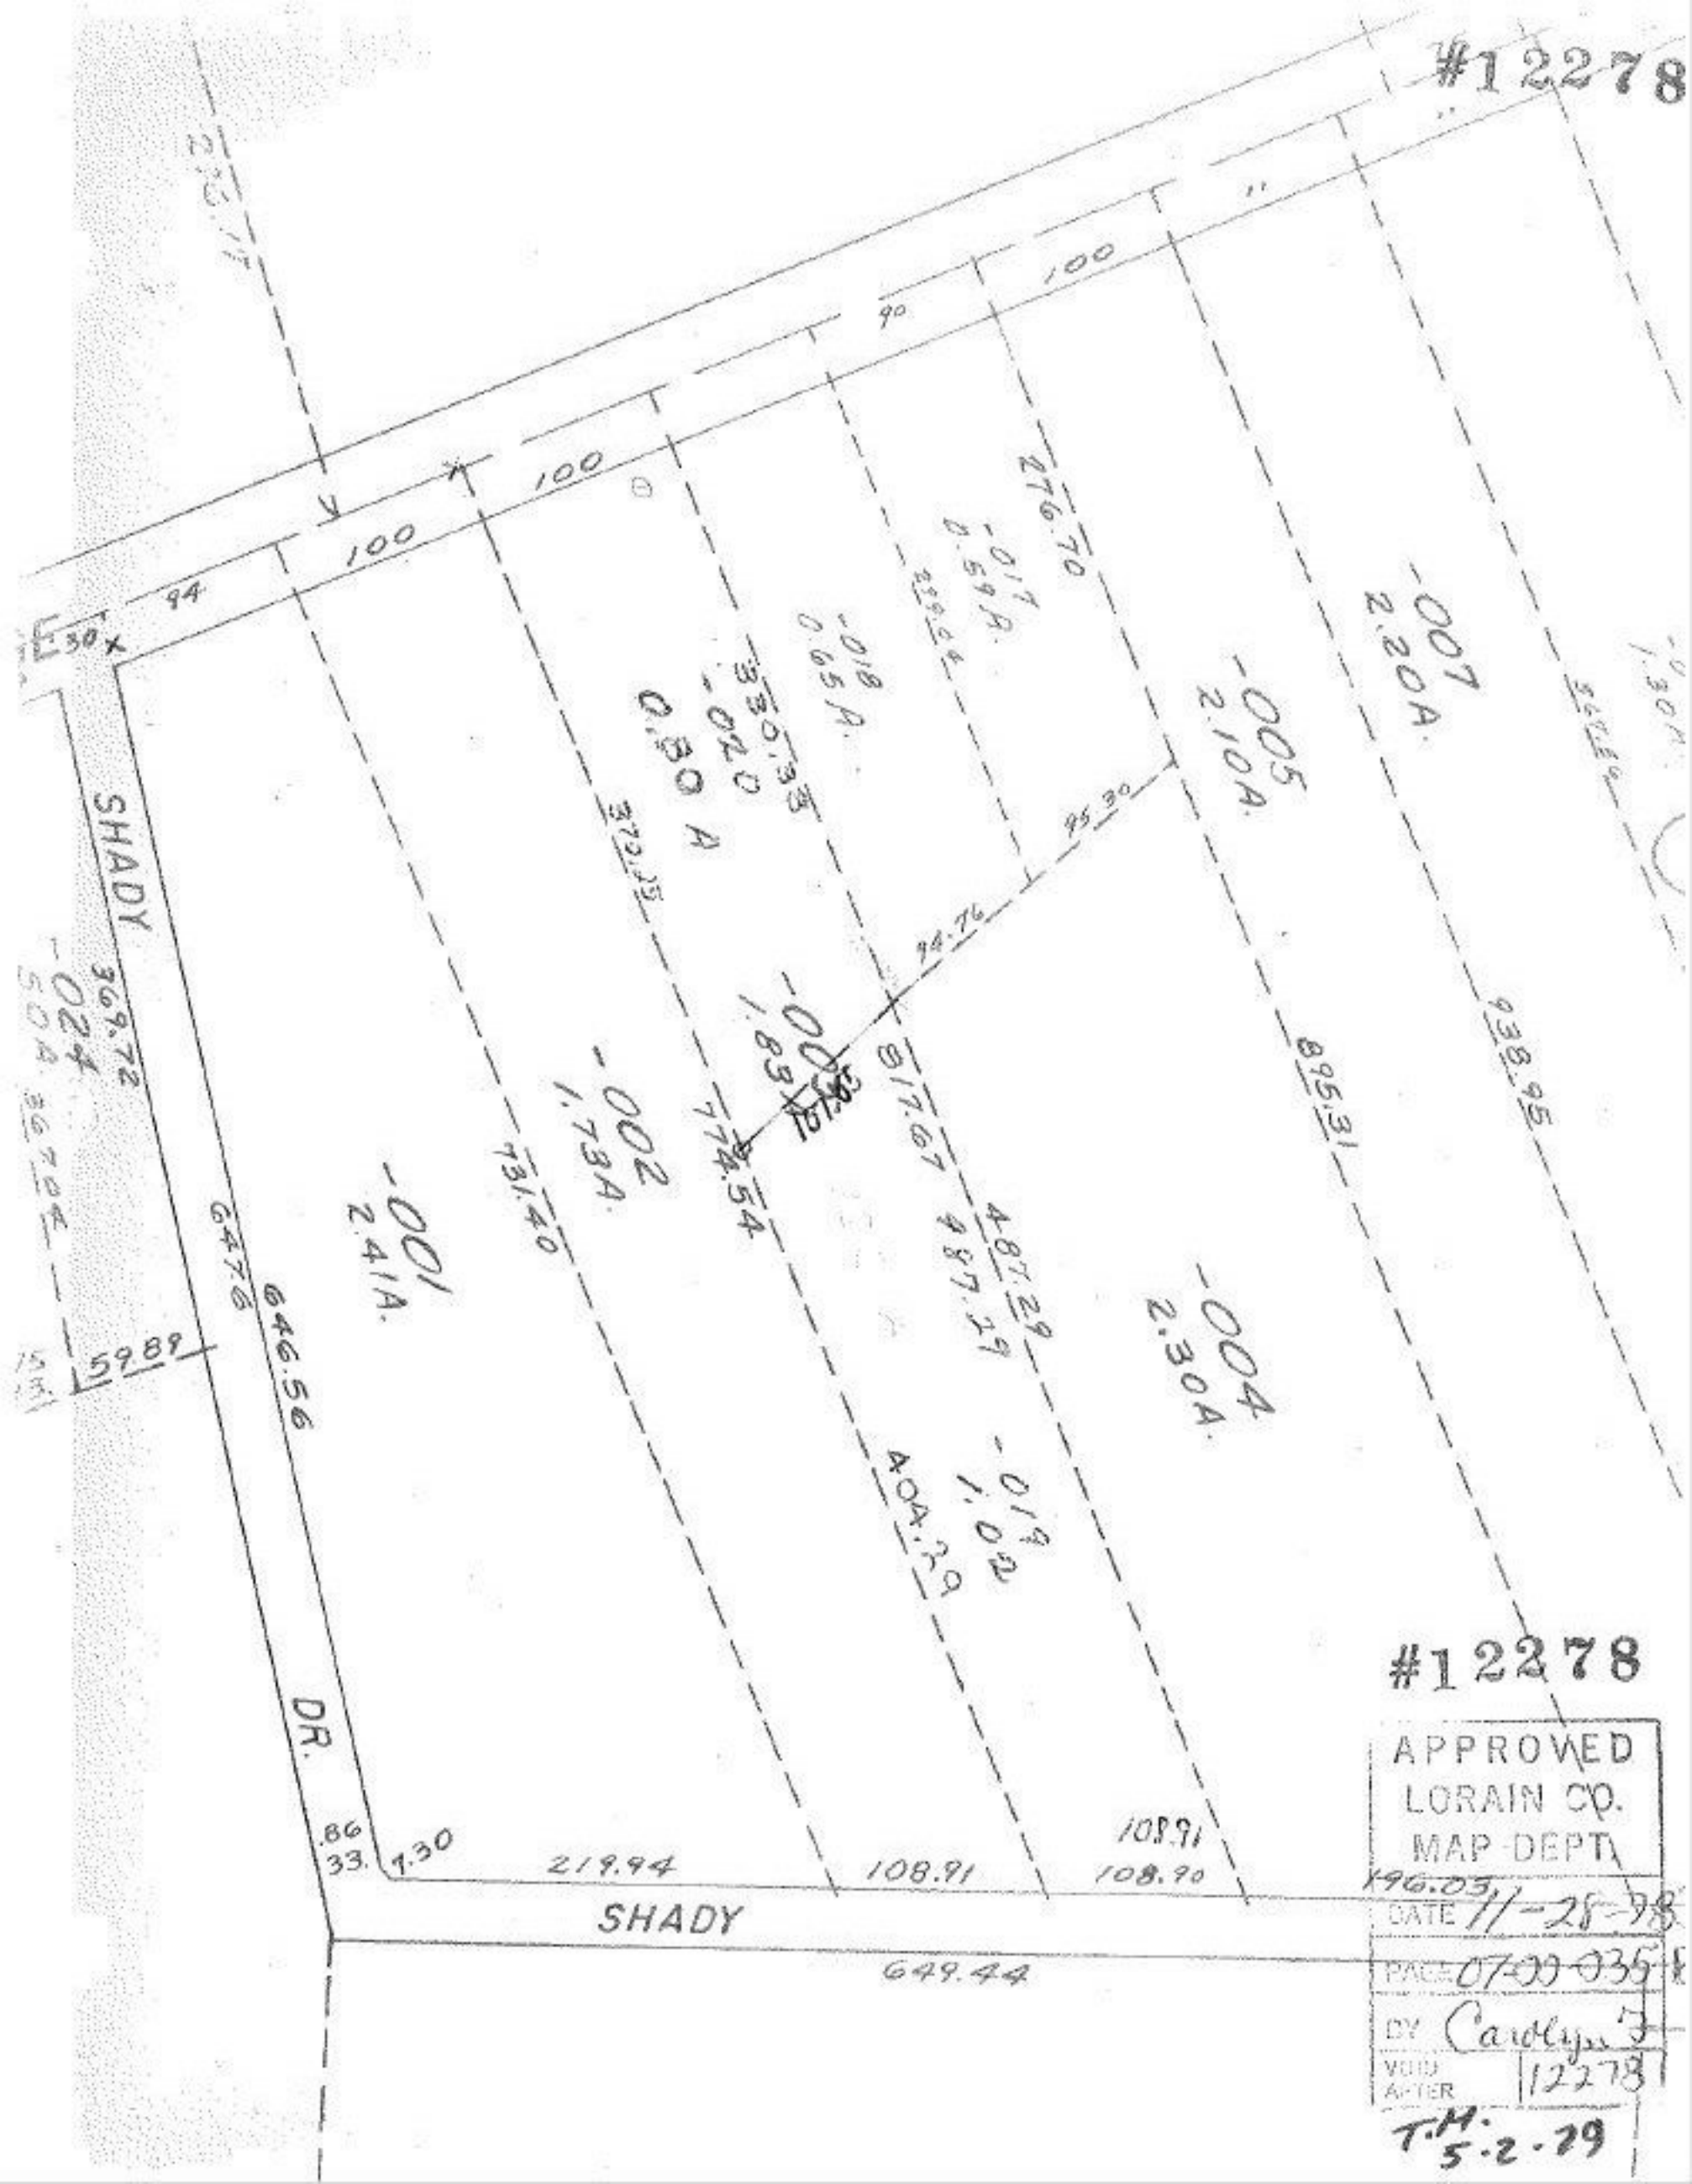
#12278
SHADY
DR.
SHADY
-001
2.41A.
-002
1.73A.
-003
1.83A.
-004
2.30A.
-005
2.10A.
-007
2.20A.
-018
0.65A.
-017
0.59A.
-019
1.02
-020
0.80 A
276.70
330.33
370.15
774.54
731.40
817.67
487.29
404.29
895.31
938.95
94.76
95.30
100
100
100
100
90
94
30
369.72
647.6
646.56
59.89
.86
33.
7.30
219.94
108.91
108.91
108.90
196.03
649.44
#12278
APPROVED
LORAIN CO.
MAP DEPT.
DATE 11-28-78
PAGE 07-00-035
BY Carolyn
VOID AFTER 12278
T.M. 5-2-79