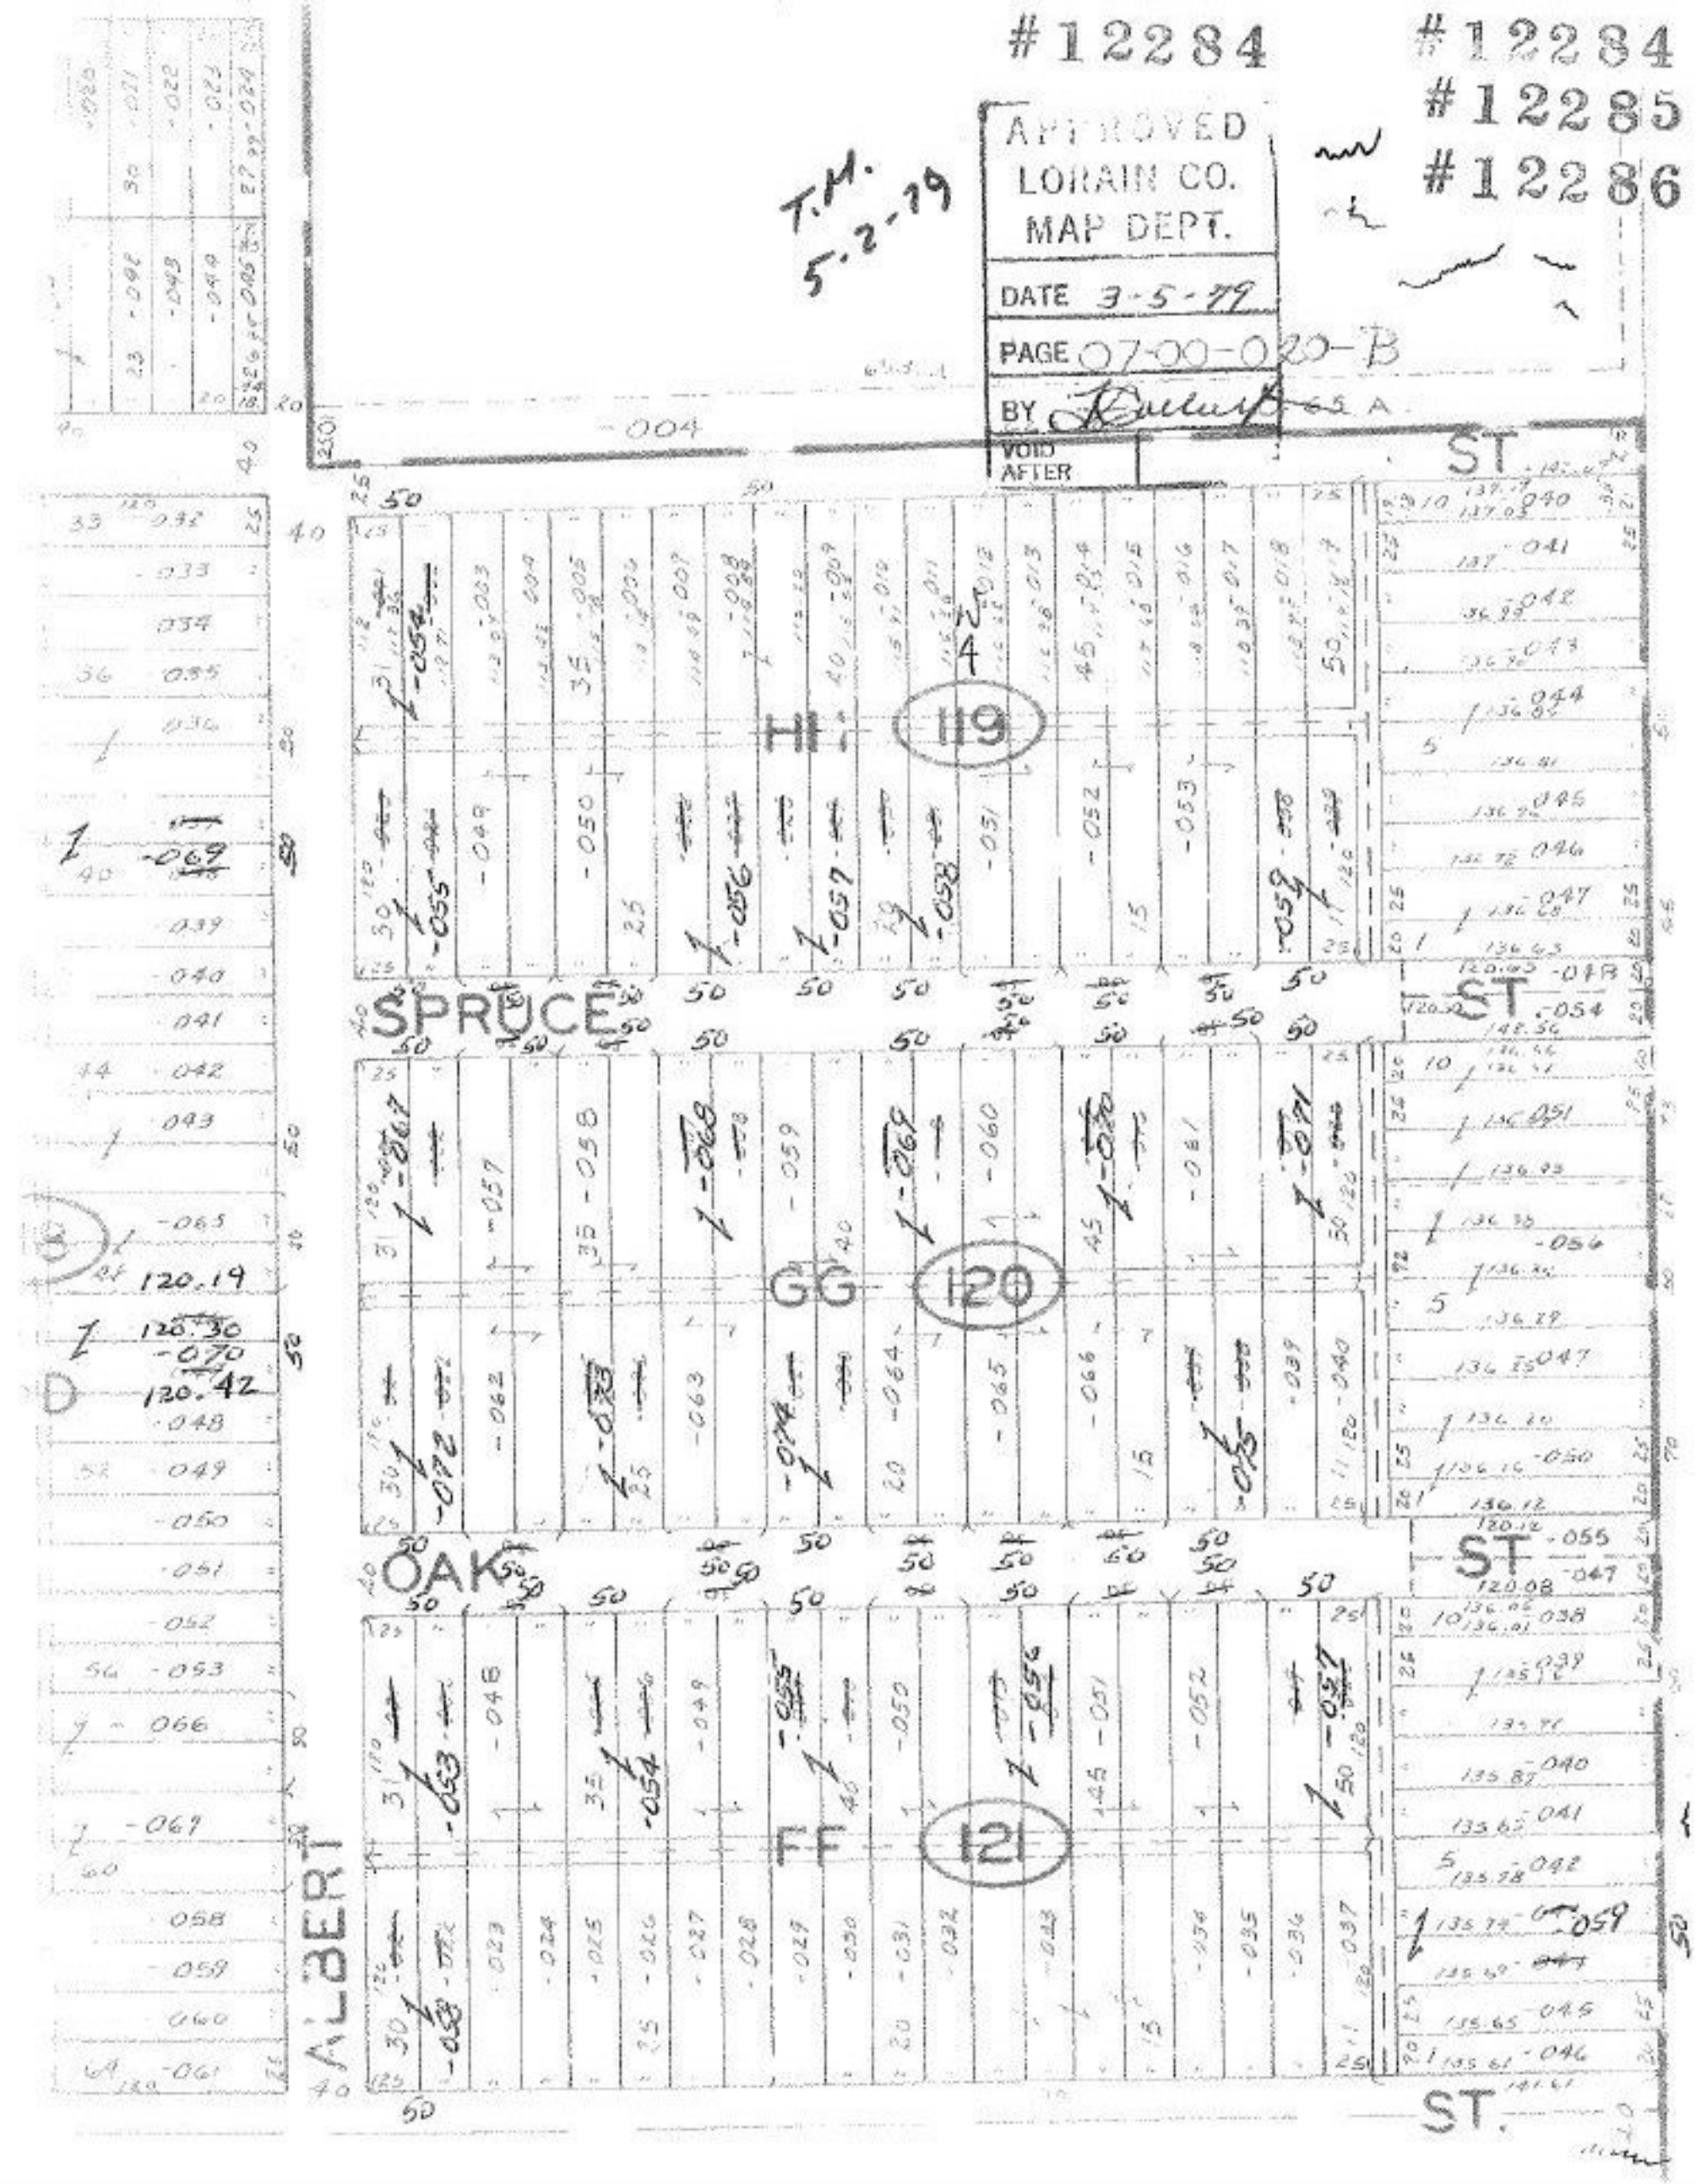
#12284
#12284
#12285
#12286
APPROVED
LORAIN CO.
MAP DEPT.
DATE 3-5-79
PAGE 07-00-020-B
BY
VOID AFTER
T.M. 5-2-79
HI 119
GG 120
FF 121
SPRUCE
OAK
ALBERT
ST
ST
ST
ST
120.19
120.30
120.42