#12289

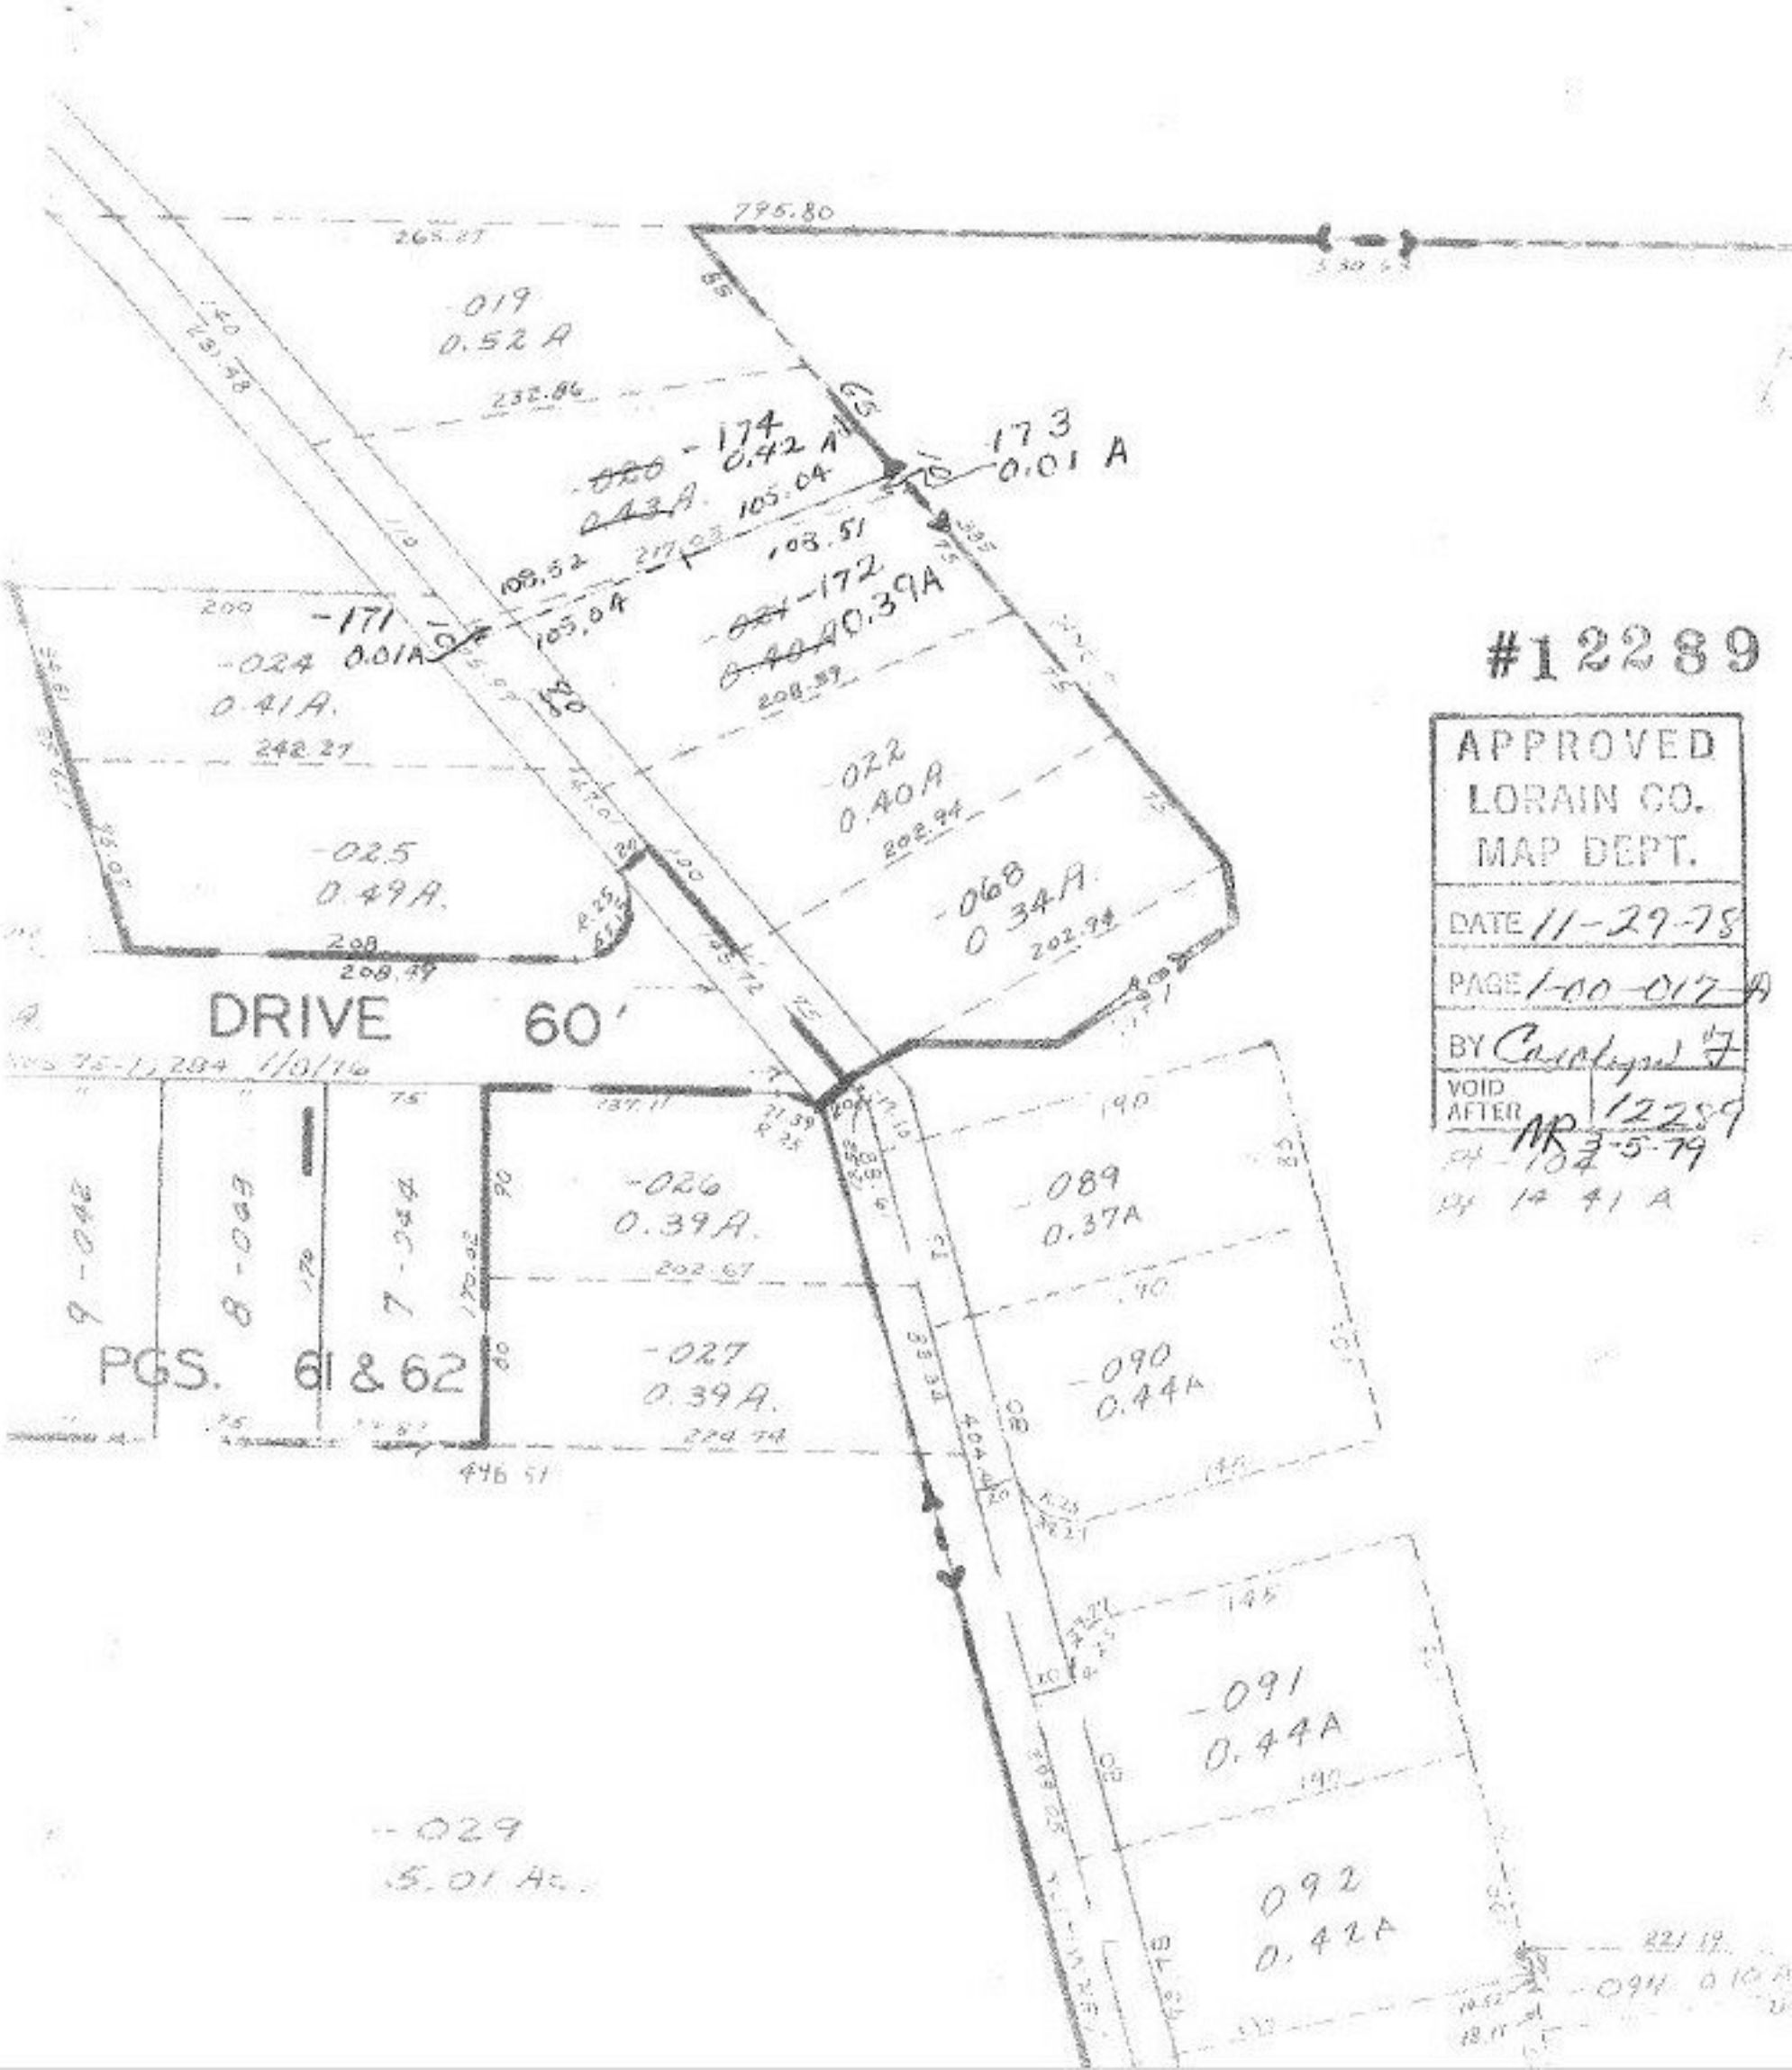

#12289

APPROVED
LORAIN CO.
MAP DEPT.
DATE 11-29-78
PAGE 1-00-017-A
BY Carolyn F
VOID AFTER 12289
MR 3-5-79
Pt 14 41 A