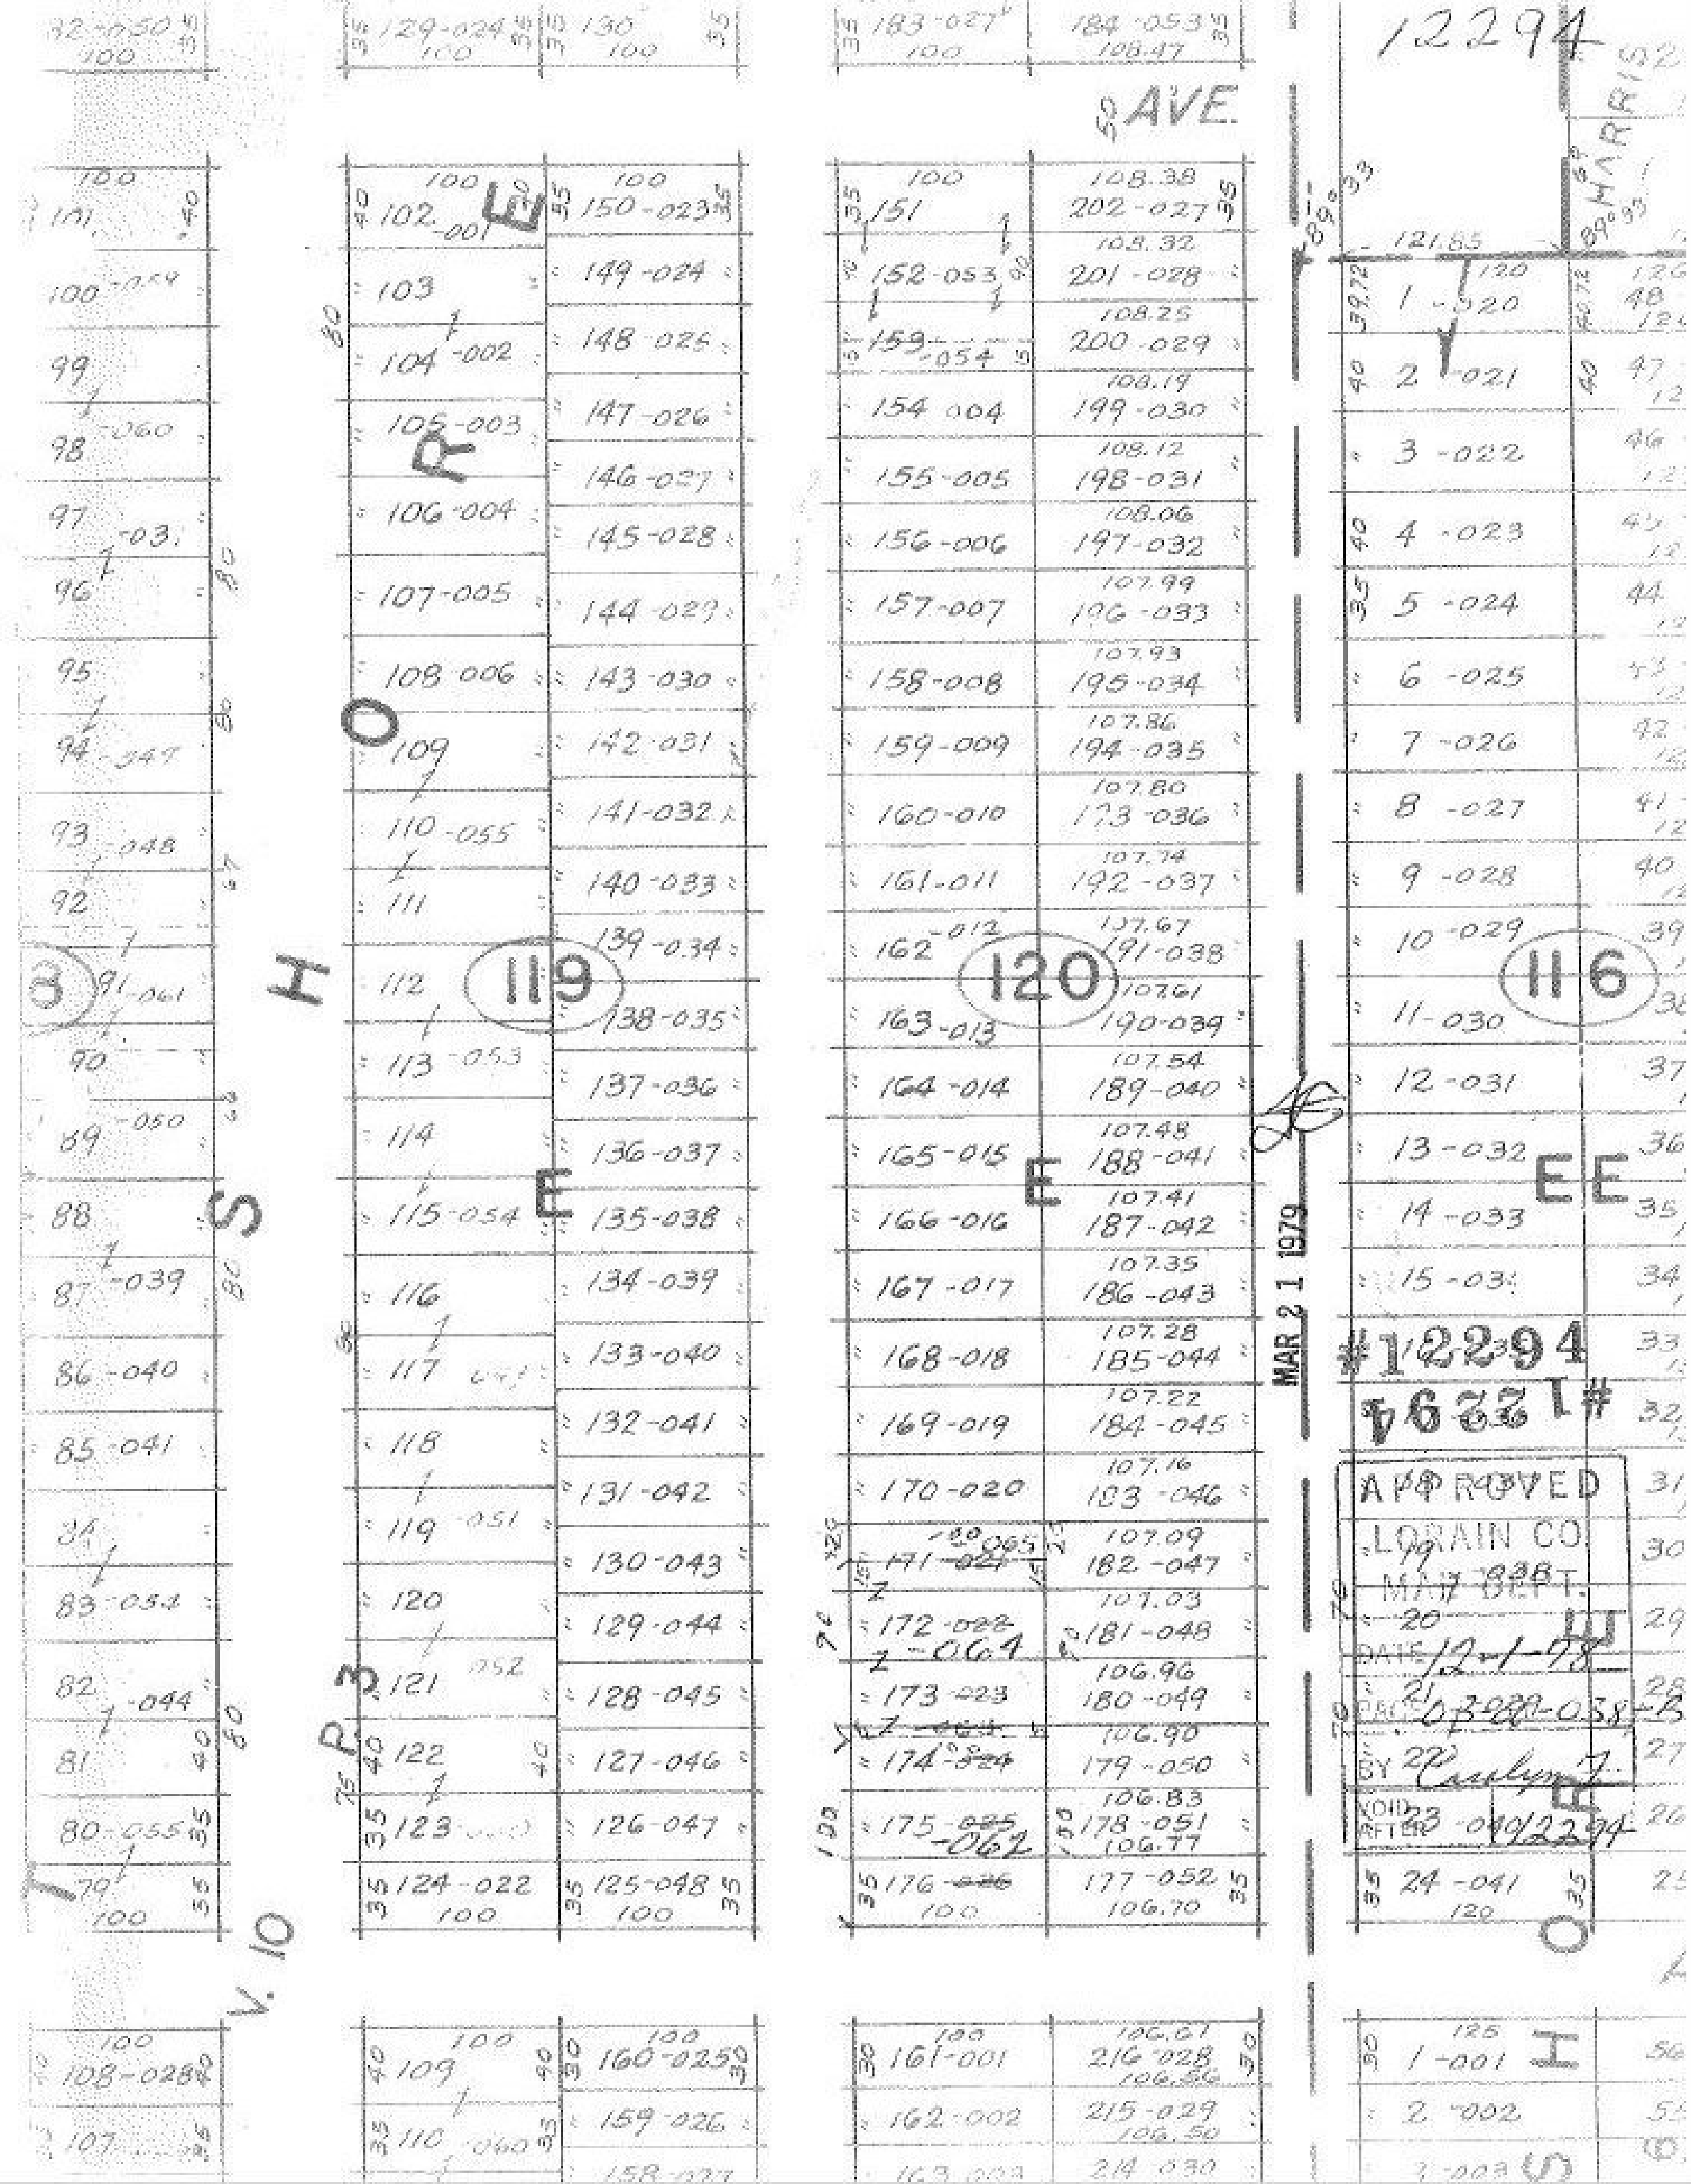

12294
AVE.
SHORE
119
120
116
102-001
103
104-002
105-003
106-004
107-005
108-006
109
110-055
111
112
113-053
114
115-054
116
117
118
119-051
120
121
122
123
124-022
150-023
149-024
148-025
147-026
146-027
145-028
144-029
143-030
142-031
141-032
140-033
139-034
138-035
137-036
136-037
135-038
134-039
133-040
132-041
131-042
130-043
129-044
128-045
127-046
126-047
125-048
151
152-053
154 004
155-005
156-006
157-007
158-008
159-009
160-010
161-011
162-012
163-013
164-014
165-015
166-016
167-017
168-018
169-019
170-020
173-023
176
202-027
201-028
200-029
199-030
198-031
197-032
196-033
195-034
194-035
192-037
191-038
190-039
189-040
188-041
187-042
186-043
185-044
184-045
182-047
181-048
180-049
179-050
178-051
177-052
1-020
2-021
3-022
4-023
5-024
6-025
7-026
8-027
9-028
10-029
11-030
12-031
13-032
14-033
24-041
MAR 21 1979
#12294
APPROVED
LORAIN CO.
MAP DEPT.
DATE 12-1-78
BY
VOID AFTER
161-001
162-002
216-028
215-029
1-001
2-002
108-028
109
110
160-025
159-026