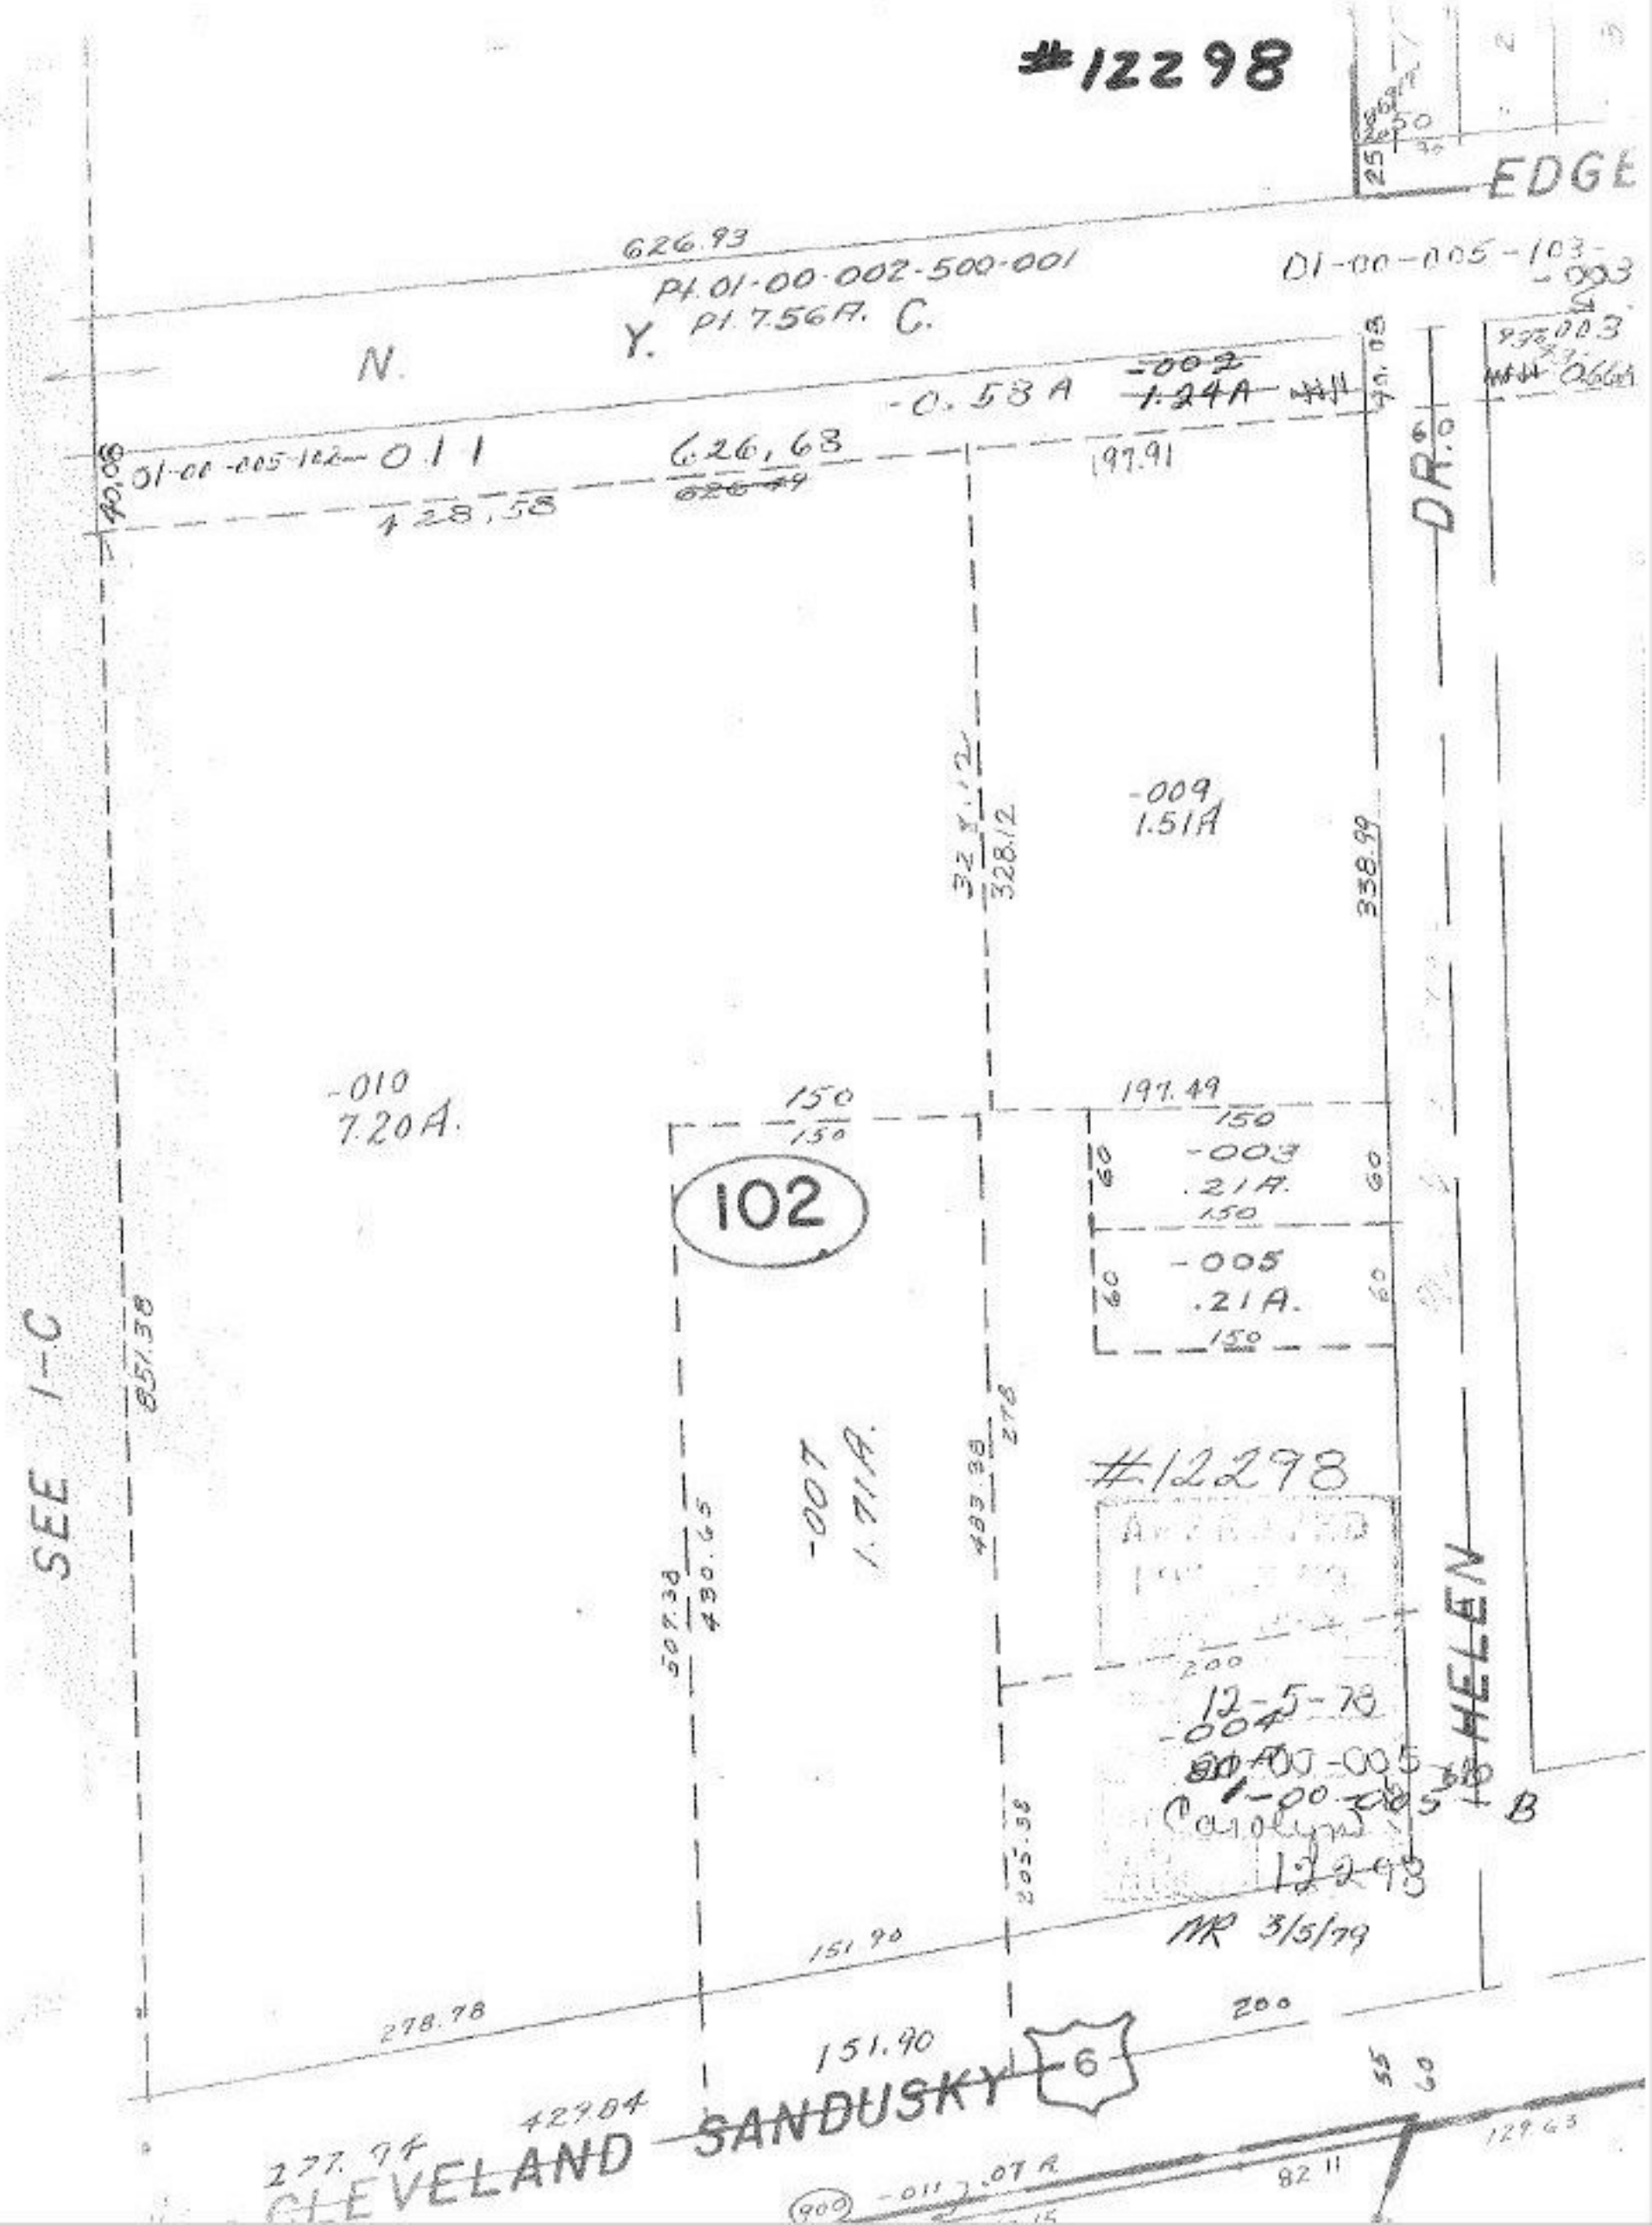
#12298
EDGE
626.93
Pt. 01-00-002-500-001
Pt. 7.56A. C.
N.
Y.
01-00-005-103-
-003
-0.58A
-002
1.24A
01-00-005-102-011
626.68
428.58
197.91
DR.
-009
1.51A
328.12
338.99
-010
7.20A.
150
150
197.49
-003
.21A.
-005
.21A.
102
SEE 1-C
851.38
-007
1.71A.
507.38
430.65
483.38
278
#12298
200
12-5-78
-004
01-00-005-
1-00-005-
B
12298
MR 3/5/79
HELEN
151.90
278.78
151.90
200
6
429.84
277.74
CLEVELAND
SANDUSKY
-011
.07 A
82.11
129.63