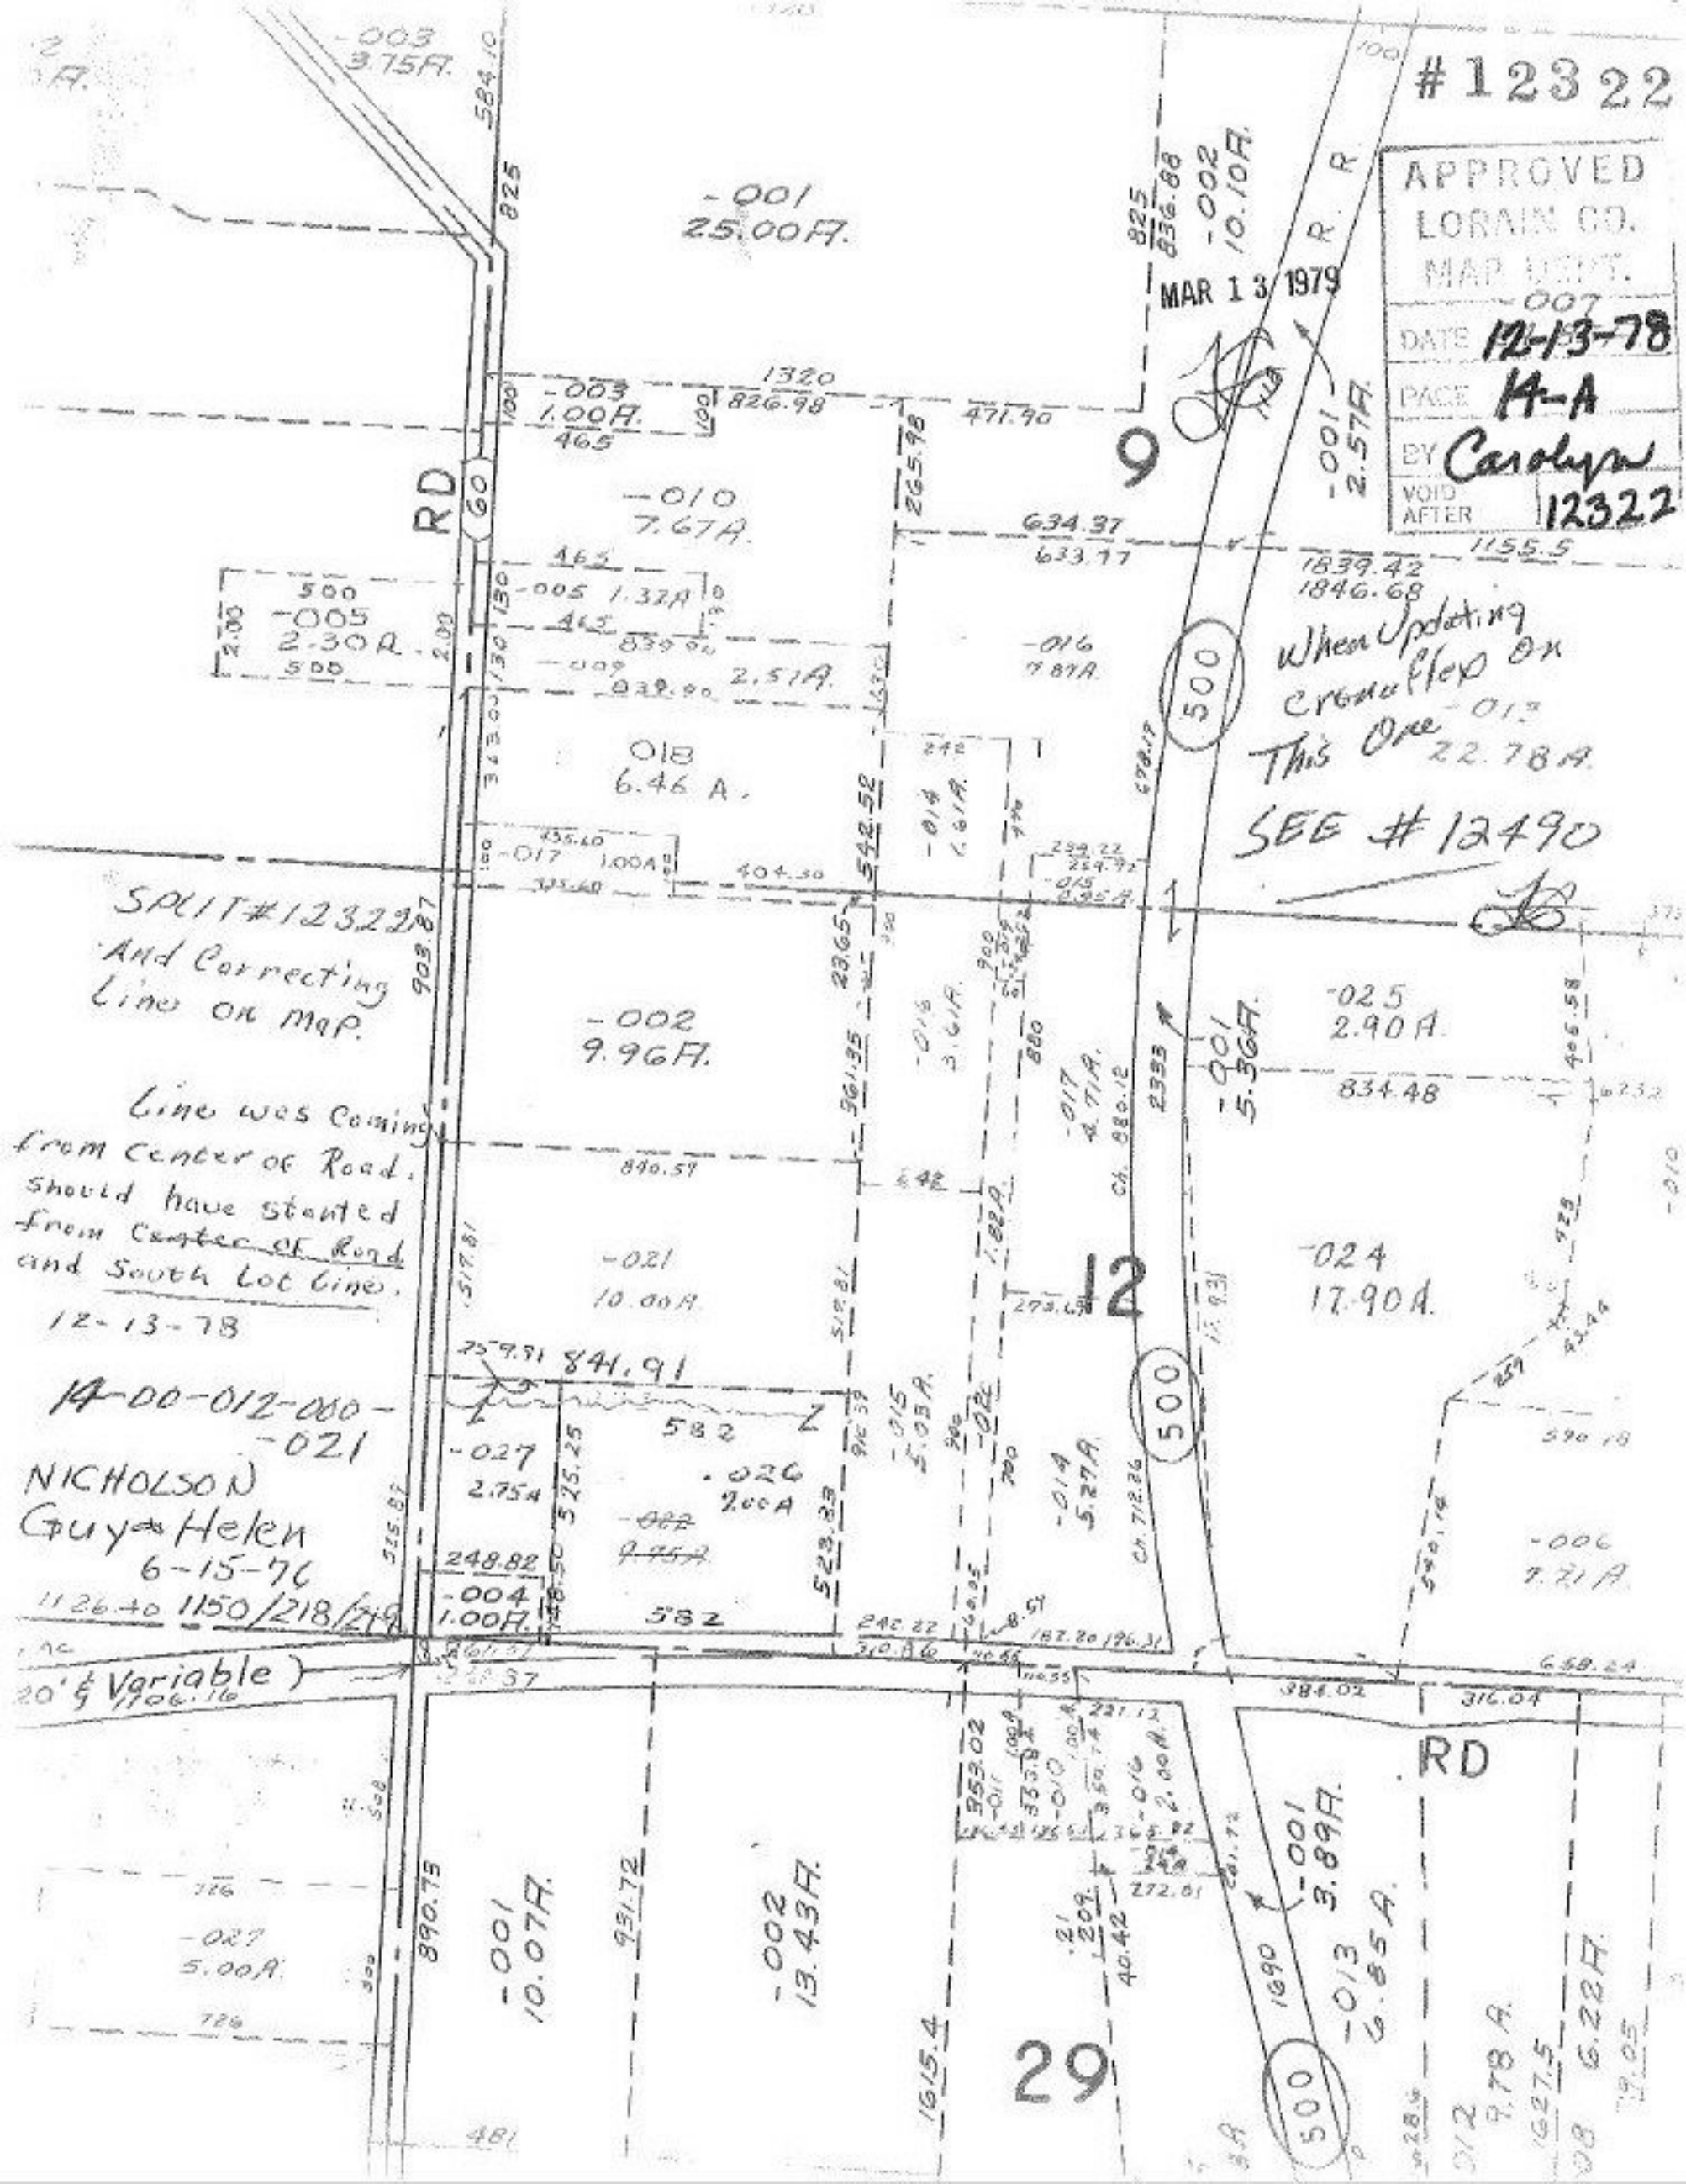
#12322
APPROVED
LORAIN CO.
MAP DEPT.
DATE 12-13-78
PAGE 14-A
BY Carolyn
VOID AFTER 12322
MAR 13 1979
When Updating Cronaflex On This One
SEE #12490
SPLIT #12322 And Correcting Line on Map.
Line was Coming from Center of Road. Should have started from Center of Road and South Lot Line.
12-13-78
14-00-012-000-021
NICHOLSON
Guy & Helen
6-15-76
1150/218/219
20' & Variable
RD
9
12
29
500
-001 25.00A.
-002 10.10A.
-003 3.75A.
-003 1.00A.
-010 7.67A.
-005 2.30A.
-005 1.32A
-009 2.51A.
-016 7.87A.
-018 6.46 A.
-017 1.00A
-002 9.96A.
-021 10.00A
-025 2.90A.
-024 17.90A.
-001 5.36A.
-027 2.75A
-026 7.00A
-004 1.00A.
-006 7.21A
-001 10.07A.
-002 13.43A.
-001 3.89A.
-013 6.85A.
-027 5.00A.
-012 9.78A.
-008 6.22A.