#12325

#12325

APPROVED
LORAIN CO.
MAP DEPT.
DATE 12-13-78
PARCEL 3-00-038-B
BY T. McNair
NO.
NEW
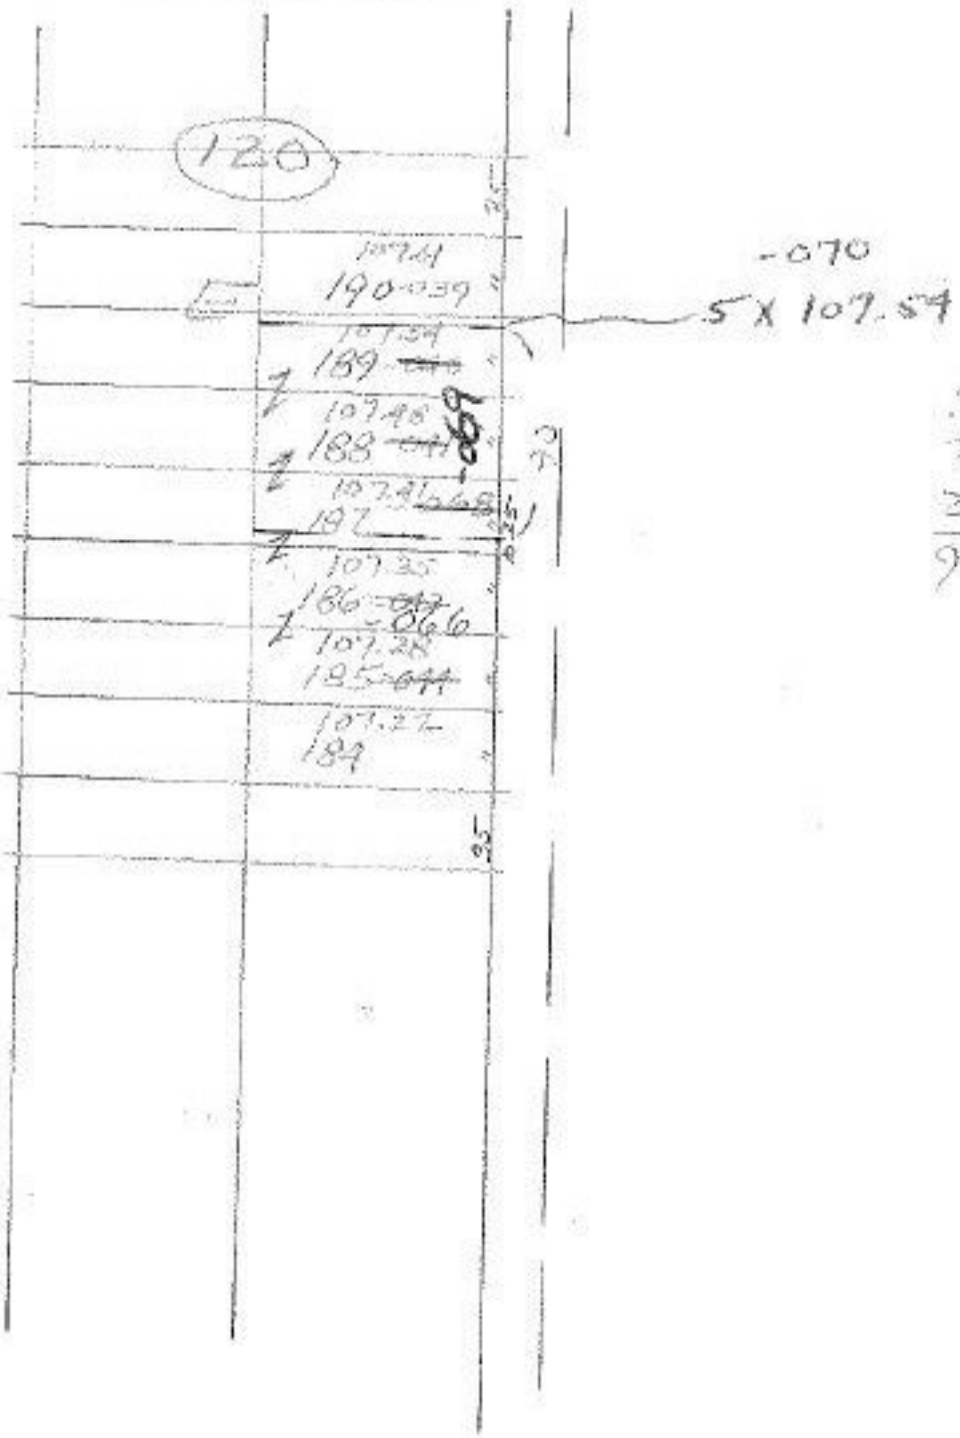
MAR 21 1979